

D-1078 - U.S. Postal Service
dedicates abutter's access rights
to Wichita Street. Generally
located on the west side of
Wichita Street, between 2nd and
3rd Streets.

POSTED
6-14-82
F

ACTION

DATE

COMMITTEE _____

M.A.P.C. _____

B.C.C./B. ~~60-C~~ *Accepted* 3-10-81

closed


MAP No. 5447A
 Sec. No. _____
 TWP. No. _____
 RANGE _____

DEDICATION REPORT AND PROGRESS
 CASE No. D - 1078
 ASSOCIATED CASE NO. V-1011

1. OFFER TO DEDICATE: Abutter's Access Rights to Wichita Street.
 GENERALLY LOCATED: on the west side of Wichita Street, between 2nd and 3rd Streets.

LEGALLY DESCRIBED AS: _____

DEDICATED BY: U. S. Postal Service
 AGENT: _____
 ADDRESS: _____
 PURPOSE OF DEDICATION: _____ PHONE _____

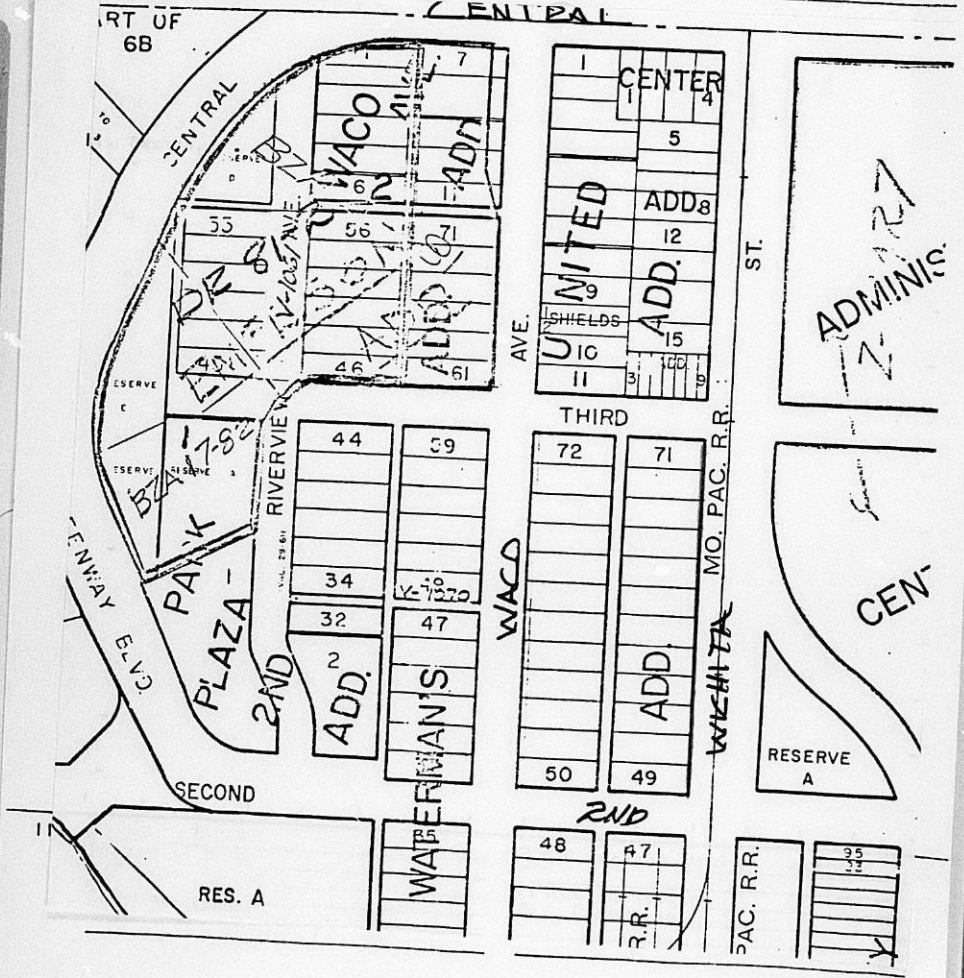

Dedication file & control card
Map 5447.A

D-1078

U.S. Postal Service dedicates abutted access rights
to Wichita Street. Generally located on the
west side of Wichita Street between ~~Second~~
2nd and 3rd Streets.

Assoc. w/ V-1011

BCC accepted 3-10-81

Some filed to Lantz. File control card on cloud file

DEDICATION OF ABUTTER'S ACCESS RIGHTS

D-1078

KNOW ALL MEN BY THESE PRESENTS:

That for and in consideration of the sum of One Dollar (\$1.00) and other good and valuable considerations, the receipt of which is hereby acknowledged, the undersigned, The United States Postal Service being the owner of the following described real estate in Sedgwick County, Kansas, to wit:

Odd Lots 49 through 71 inclusive on Wichita Street in Waterman's Addition to Wichita, Sedgwick County, Kansas

do hereby transfer and convey to the City of Wichita, Kansas, all abutter's rights of access, ingress and egress to said property from or to Wichita Street over and across the East line of the above described property; to have and to hold the same forever. It being understood that this conveyance is a covenant running with the land and prohibits all subsequent owners thereof and all members of the public from entering upon said property from Wichita Street except as such rights may be granted by the City of Wichita in the future.

Executed this 10th day of October, 1980.

The United States Postal Service

GILBERT P. MULLEN

Gilbert P. Mullen

Field Manager/Contracting Officer

STATE OF KANSAS)
COUNTY OF JOHNSON) ss.

BE IT REMEMBERED, that on this 10th day of October, 1980, before me a notary public in and for the said County and State, came Gilbert P. Mullen to me personally known to be the same person who executed the foregoing instrument and duly acknowledged the execution of the same.

IN WITNESS WHEREOF, I have hereunto subscribed my name and affixed my official seal, the day and year last above written.

Diana K. Adams
Notary Public

My Commission expires:

Diana K. Adams

