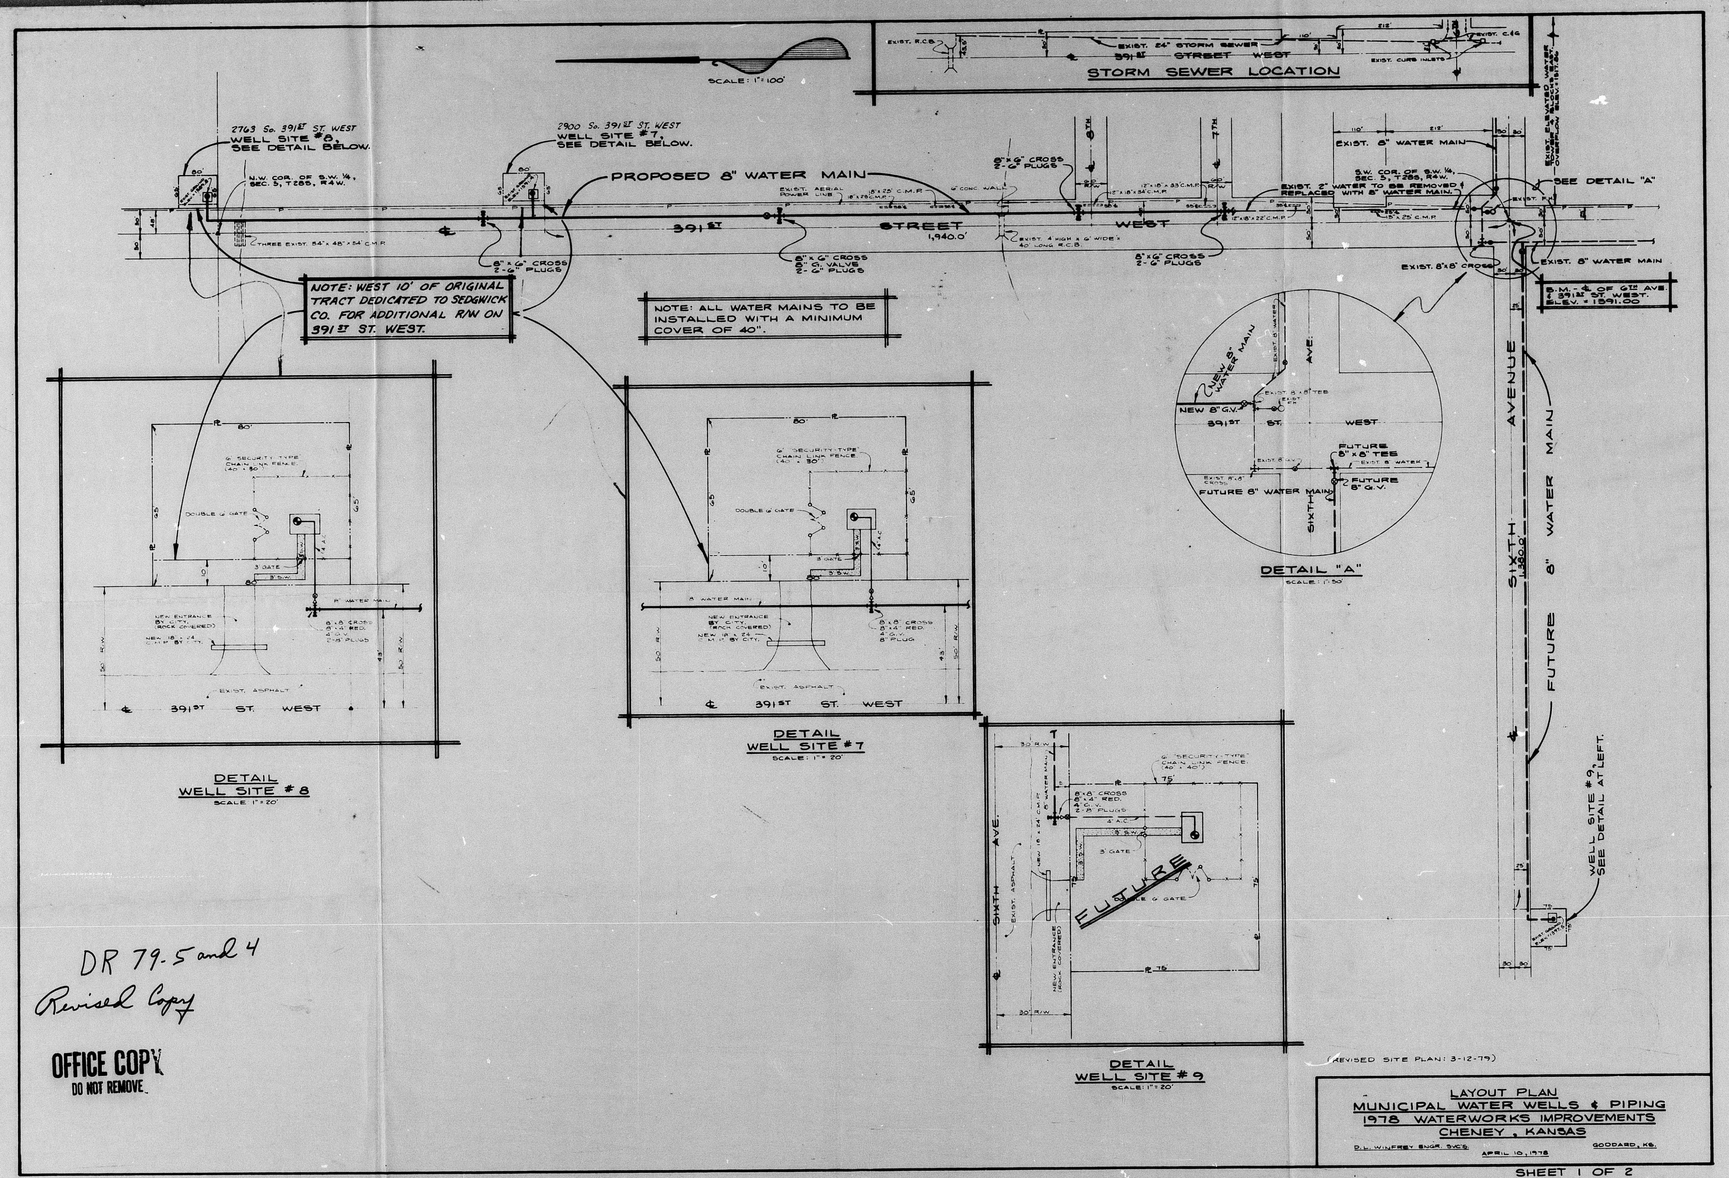

DR 79-5 and 4
Revised Copy

OFFICE COPY
DO NOT REMOVE

FILMED FROM THE BEST AVAILABLE COPY....