


LANDSCAPE PLAN

APPROVED 8/12/23 BY *[Signature]*

Note: Existing landscaping is not shown on this plan due to the limited scope of remodel work proposed. Any landscaping on site must adhere to the City of Wichita Title 28-Zoning: Chapter 28.06 of the Wichita City Code.

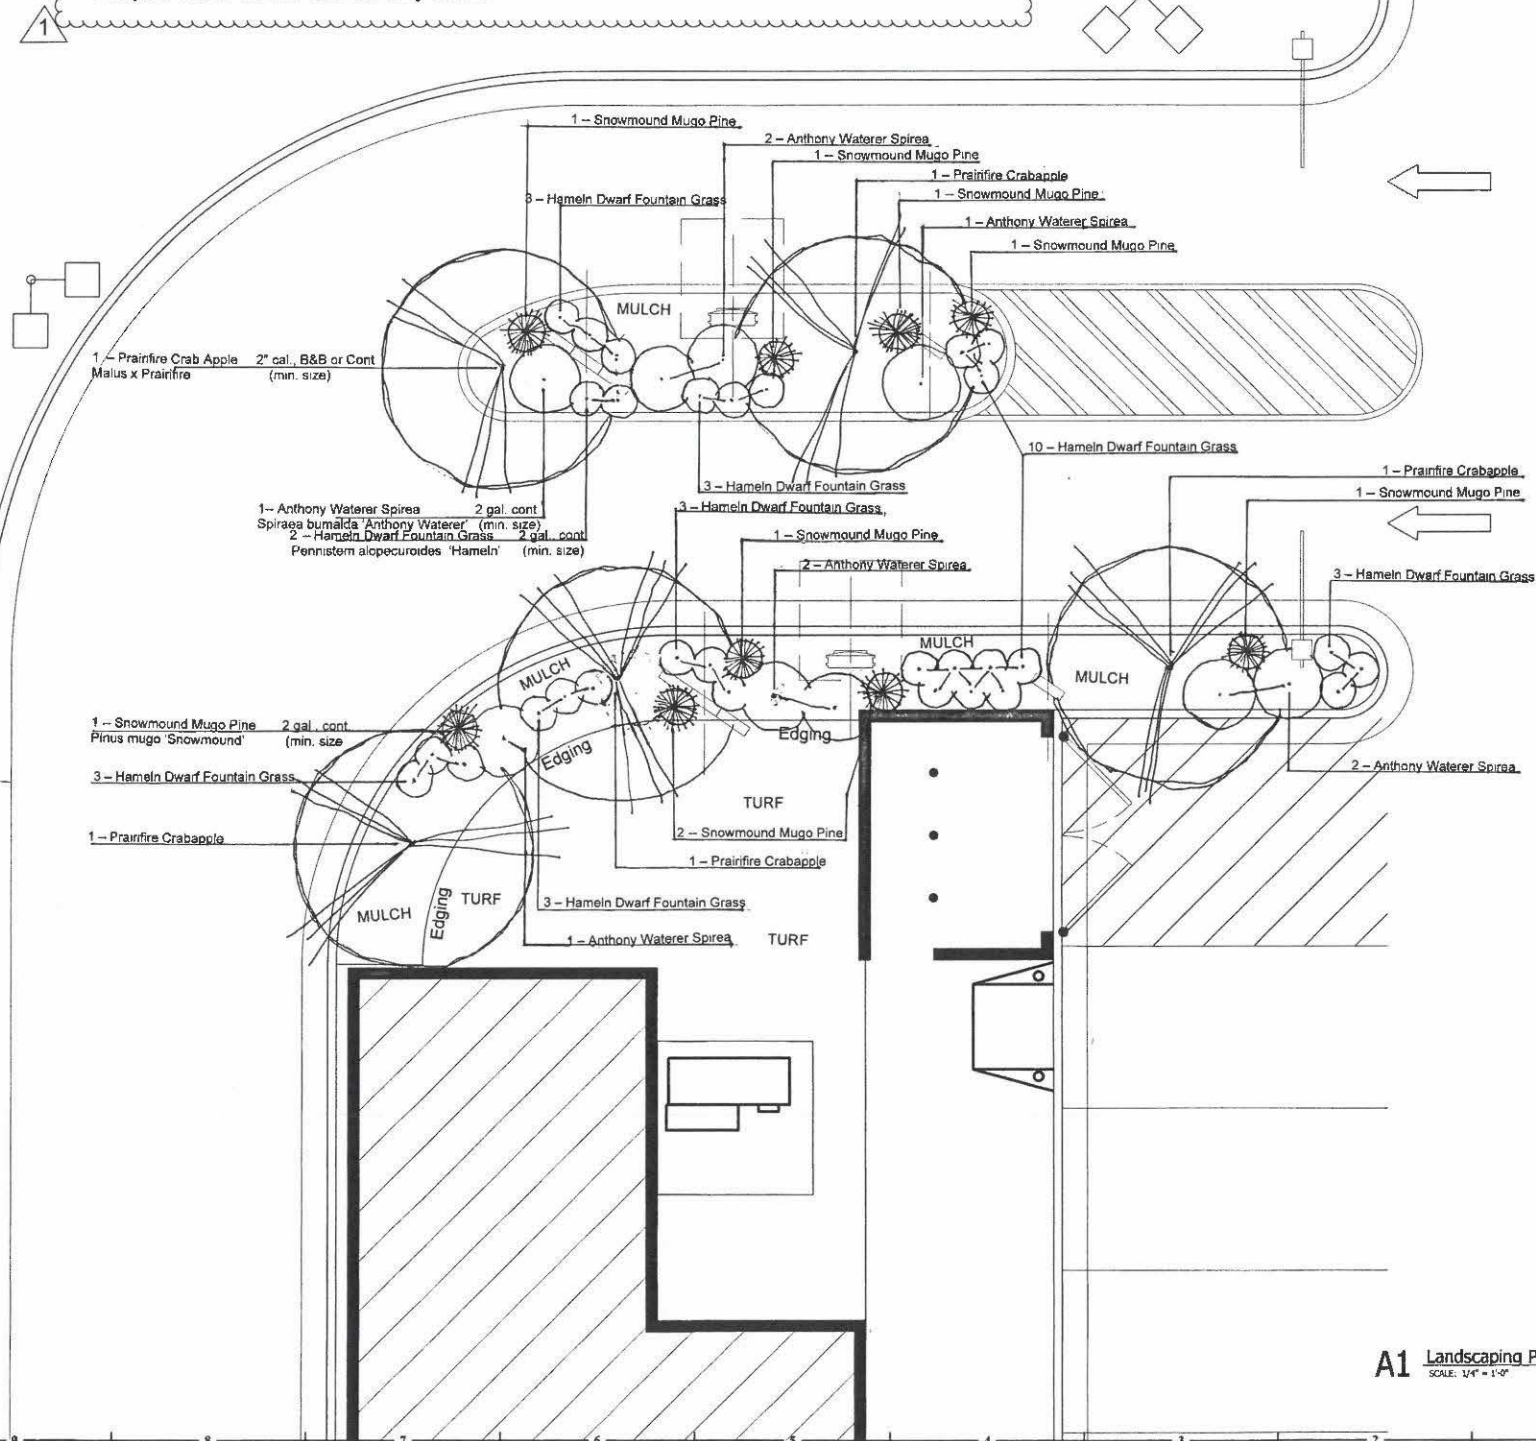

GENERAL NOTES - FLOOR PLANS

- ALL TREES ARE TO BE PLANTED, FERTILIZED, STAKED, MULCHED, PRUNED, AND WRAPPED IN ACCORDANCE WITH STANDARD INDUSTRY PRACTICES. ALL TREES TO BE NORTHERN GROWN - PLANTS GROWN IN NURSERIES ONE (1) YEAR OR MORE. LOCATED IN HARDINESS ZONES 5-8, PER THE USDA MAP. TREES FURNISHED SHALL BE WELL-BRANCHED, PARTIALLY WITH RESPECT TO THE HEIGHT: WIDTH RELATIONSHIP. TREES WITH BROKEN LEADERS WILL NOT BE ACCEPTED. THE BRANCHING HEIGHT FOR SHADE TREES IS TO BE 4-8 FEET ABOVE FINISH GRADE. TREES PROVIDED SHALL BE BALLED AND BURLAPPED. SHADE TREE SIZE - MINIMUM 2" CALIPER. ALL SHRUBS ARE TO BE PLANTED, FERTILIZED, AND PRUNED IN ACCORDANCE WITH STANDARD INDUSTRY PRACTICES. SHRUBS PROVIDED SHALL BE DELIVERED IN CONTAINERS OR BALLED AND BURLAPPED.
 - ALL PLANT MATERIALS PROVIDED FOR THIS PROJECT SHALL BE IN ACCORDANCE WITH - AMERICAN NATIONAL STANDARDS INSTITUTE, INC. ANSI Z60.1 - 1973, AMERICAN STANDARD FOR NURSERY STOCK.
 - SOIL IN PLANTING AREAS TO BE TESTED AND MODIFIED AS REQUIRED.
 - TOP SOIL PROVIDED FOR THIS PROJECT SHALL BE FERTILE, FRAMBLE, NATURAL, LOAM SOIL OF UNIFORM QUALITY, CHARACTERISTIC OF REPRESENTATIVE LOCAL SOILS TO PRODUCE A HEAVY GROWTH OF VEGETATION. IT SHOULD BE FREE OF SUBSOIL, CLAY, TRASH, STONES, ETC. THAT WOULD IMPEDE PLANT GROWTH.
 - MULCH 4" DEEP AROUND TREES AND 2-4" DEEP IN ALL SHRUB PLANTING BEDS. MULCH MATERIAL IS TO BE MEDIUM SIZE, DRY, SHREDDED WOOD FIBER OF A QUALITY WHICH MEETS INDUSTRY STANDARDS OR MATERIAL AS SPECIFIED BY THE OWNER.
 - PLANTING TIMES: SPRING: FEBRUARY 15 TO MAY 31 - INCLUSIVE; FALL: SEPTEMBER 15 TO DECEMBER 31 - INCLUSIVE.
 - THE LANDSCAPE CONTRACTOR IS TO BE RESPONSIBLE FOR ALL PERMITS REQUIRED AND IS TO SEE THAT ALL WORK IS PERFORMED IN ACCORDANCE WITH STATE AND LOCAL CODES.
 - THE LANDSCAPE CONTRACTOR IS RESPONSIBLE FOR THE LOCATION OF ALL UTILITIES IN THE PROJECT AREA AND THEIR PROTECTION. ANY DAMAGE TO UTILITIES DURING CONSTRUCTION WILL BE REPAIRED AT THE LANDSCAPE CONTRACTOR'S EXPENSE.
 - ALL TURF AREAS WILL BE PLANTED USING A LOCALLY AVAILABLE TALL FESCUE. ALL TURF WILL BE INSTALLED IN ACCORDANCE WITH THE INDUSTRY STANDARDS. ALL TURF AREAS DISTURBED BY CONSTRUCTION WILL BE REPLANTED.
 - THE LANDSCAPING CONTRACTOR IS TO PROVIDE SOO AND THE DESIGN / INSTALLATION OF AN IRRIGATION SYSTEM. CONTRACTOR TO ENSURE IRRIGATION SYSTEM IS IN ACCORDANCE WITH CITY AND COUNTY STANDARDS.
- NOTE: TREES/SHRUBS NEED WATERING, UNTIL ESTABLISHED. FIRST YEAR MINIMUM.

HOEFER WELKER

11460 Tomahawk Creek Parkway, Suite 400, Leawood, Kansas 66211
P: 913.307.3700 - F: 913.307.3710 - www.hoefervs.com

DESIGN DEVELOPMENT

Burger King

740 N. Tyler Rd.
Wichita, KS 67212

COPYRIGHT © BY
HOEFER WELKER, LLC

REVISION DATES

08/08/23 - PLAN REV. #1

PROFESSIONAL SEAL

LS1.11

ISSUE DATE 3/13/2023
HOEFER WELKER # 111131

Susan L. Moeder L.A.
967 N. Back Bay Blvd.
Wichita, Kansas 67203
susanlmoeder@gmail.com
316-516-1149

A1 Landscaping Plan
SCALE: 1/4" = 1'-0"



LANDSCAPING PLAN