



**Wichita-Sedgwick County
Metropolitan Area
Planning Department**

ICT Airbenders, LLC
Attn: Francis Baalmann
1141 North Coachhouse Ct.
Wichita, KS 67235

May 28, 2024

RE: CON2024-00030 –Administrative Permit for Short Term Rental in the City on property zoned TF-3 Two-Family Residential; generally located within two-blocks south of East Douglas Avenue and one-quarter mile west of South Hillside Avenue (240 South Erie Avenue).

Legal Description: Lots 33-35, Roger's Subdivision of Richland's 2nd Addition, Wichita, Sedgwick County, Kansas.

Dear Applicant,

We reviewed your Administrative Permit request to permit a non-owner-occupied Short-Term Rental in the City in the SF-5 Single-Family Residential District for the above-described property.


Section V-L.2.b. of the Unified Zoning Code (UZC) allows a Short Term Rental in the City to be approved by Administrative Permit subject to Supplementary Use Regulations found in Section III-D.6.qq of the UZC, provided that the application is not protested by greater than 50 percent of the eligible properties that either touch or are across the street or alley from the subject property.

No protests were received against this case.

Therefore, the Administrative Permit to permit a Short Term Rental in the City is hereby **GRANTED** per the previously signed approval letter and subject to the conditions contained in that letter.

The "Development Application" sign should now be removed from the property.

Sincerely,

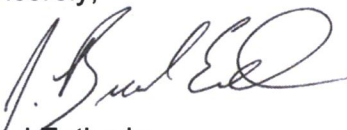

Brad Eatherly
Current Plans
Senior Planner

cc: MABCD
Brandon Johnson, CM District IV
Cameron Jackson, CSR District IV



**Wichita-Sedgwick County
Metropolitan Area
Planning Department**

ICT Airbenders, LLC
Attn: Francis Baalman
1141 North Coachhouse Ct.
Wichita, KS 67235

May 10, 2024

RE: CON2024-00030 –Administrative Permit for Short Term Rental in the City on property zoned TF-3 Two-Family Residential; generally located within two-blocks south of East Douglas Avenue and one-quarter mile west of South Hillside Avenue (240 South Erie Avenue).

Legal Description: Lots 33-35, Roger's Subdivision of Richland's 2nd Addition, Wichita, Sedgwick County, Kansas.

Dear Applicant,

We reviewed your Administrative Permit request to permit a non-owner-occupied Short Term Rental in the City in the TF-3 Two-Family Residential District for the above-described property.

Section V-L.2.b. of the Unified Zoning Code (UZC) allows a Short Term Rental in the City to be approved by Administrative Permit subject to Supplementary Use Regulations found in Section III-D.6.qq of the UZC, provided that the application is not protested by greater than 50 percent of the eligible properties that either touch or are across the street or alley from the subject property.

Below is information regarding the protest procedure.

- Protests must be in writing.
- Protests must include the signatures of all owners on record for the property protesting.
- Protests must be submitted to the Metropolitan Area Planning Department, 271 West 3rd Street, 2nd Floor, Wichita, KS, 67202.
- Protests must be received within 2 weeks of the date of this approval letter. The valid protest period ends at **5:00 p.m. on Friday, May 24, 2024**. Protests received after this date will not be considered valid.
- If greater than 50 percent of the eligible properties protest the application, the applicant can submit a Conditional Use application, which requires a public hearing process considered by the Metropolitan Area Planning Commission and the Wichita City Council. If this is the case, you will be notified in the future of any scheduled public hearing related to this case at which you will have the opportunity to provide comment.


Our signatures below indicate that the Administrative Permit to permit a Short Term Rental in the City is hereby **GRANTED**, subject to the following conditions, and subject to any valid protests received within the valid protest period.

- 1) Permitted only in residential Dwelling Units and permitted Accessory Apartments.
- 2) May be permitted as either a Primary Use or an Accessory Use
- 3) Not permitted to be in any Recreational Vehicle.
- 4) Must be licensed and operated in accordance with the requirements of Chapter 3.40 of the Code of the City of Wichita.
- 5) Must be in compliance at all times with all applicable zoning, building, fire and life-safety, housing and health codes.
- 6) Must not exceed the posted capacity permitted in accordance with Chapter 3.40 of the Code of the City of Wichita.
- 7) If the Zoning Administrator finds that there is a violation of any of the conditions of the Zoning Administrative Permit, the Zoning Administrator, in addition to enforcing the other remedies set forth in the Unified Zoning Code, may, with the concurrence of the Planning Director, declare that the Zoning Administrative Permit is null and void.

The "Development Application" sign should now be removed from the property.



Scott Wadle, Director
Metropolitan Area Planning Department

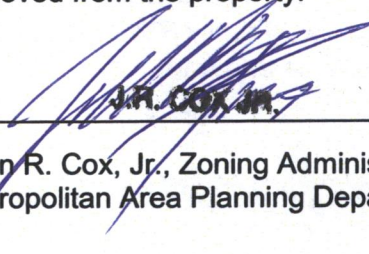


John R. Cox, Jr., Zoning Administrator
Metropolitan Area Planning Department

cc: MABCD

Brandon Johnson, CM District I

Cameron Jackson, CSR District I

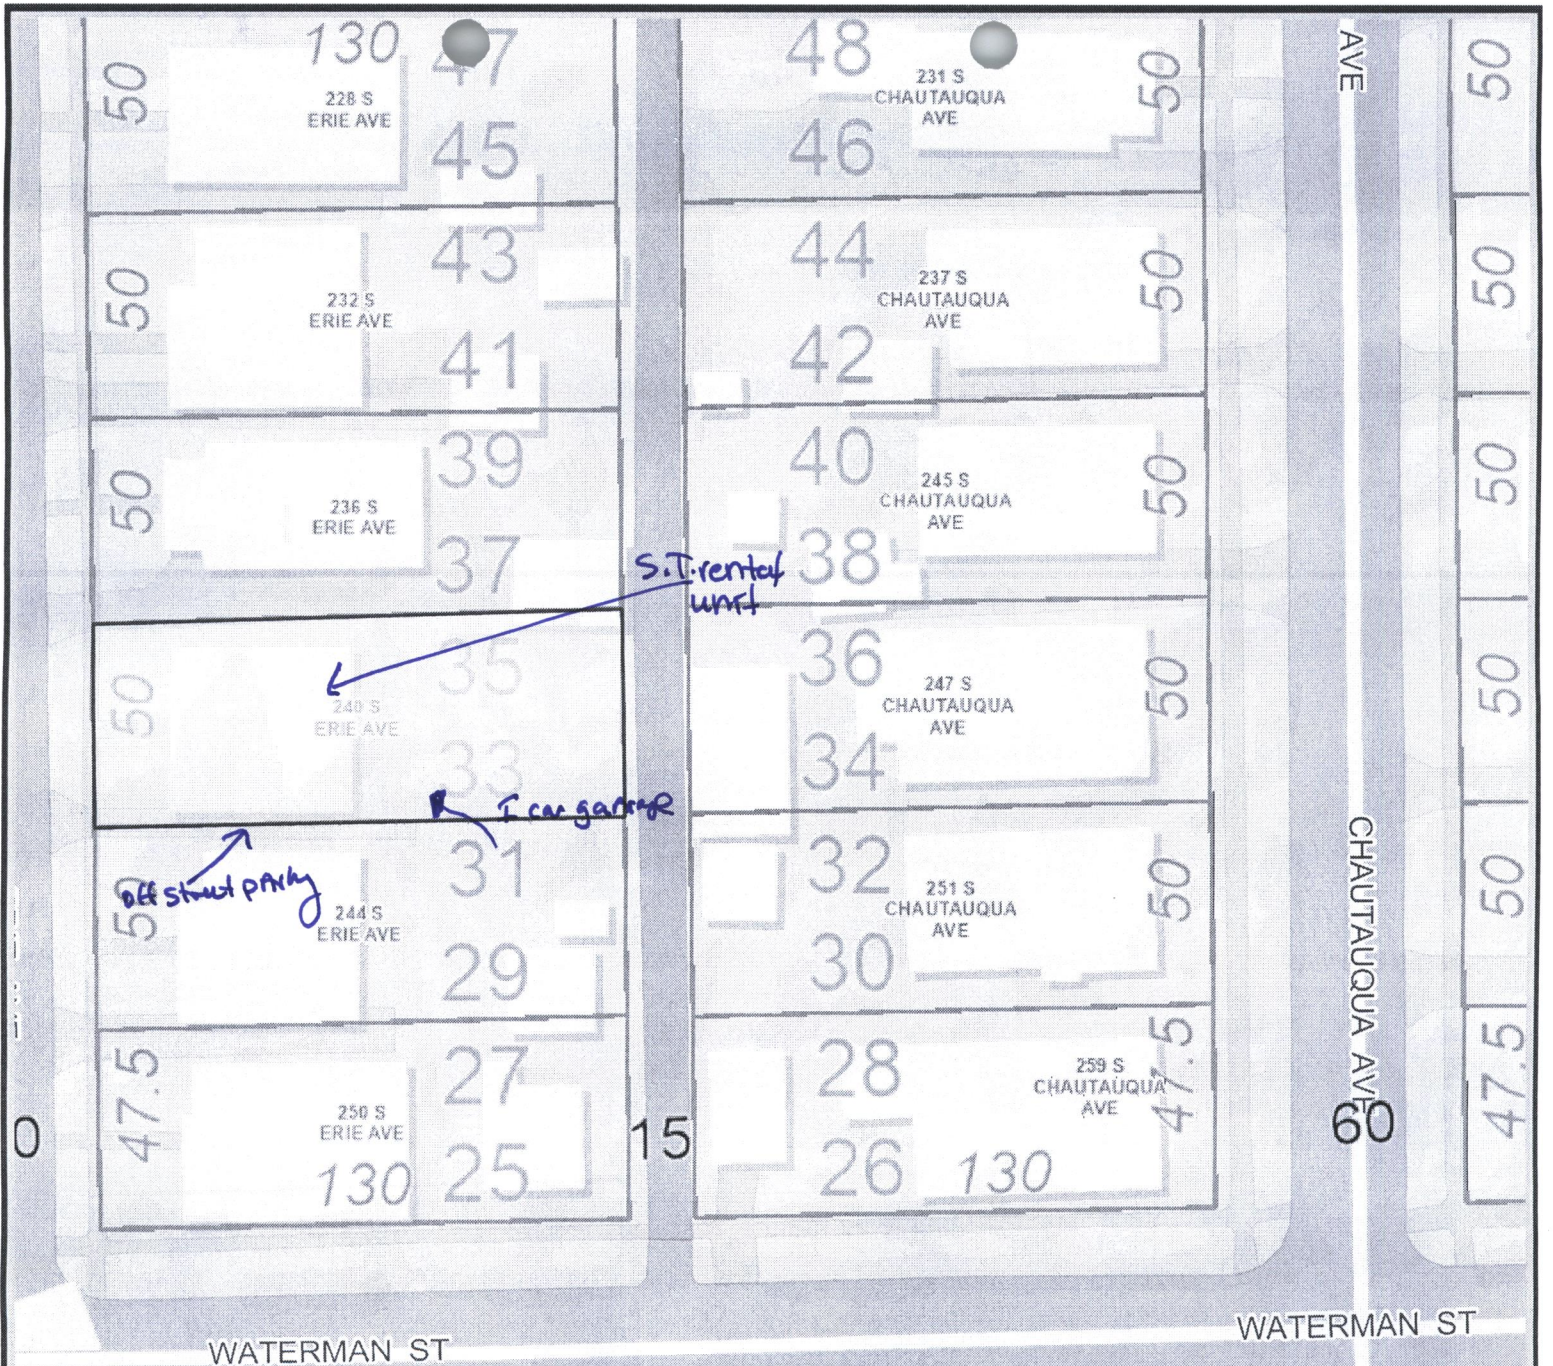

Geographic Information Services

Sedgewick County...
working for you

Date: 4/18/2024

SITE PLAN
APPROVED JSB BY 8/7/24


It is understood that the Sedgewick County GIS, Division of Information and Operations, has no indication or reason to believe that there are inaccuracies in information incorporated in the base map.

The GIS personnel make no warranty or representation, either expressed or implied, with respect to the information or the data displayed.

© 2024 Sedgewick County Kansas Government.
All rights reserved.

My Map

Sedgewick County, Kansas

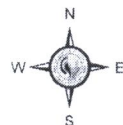

1:564

