

CASE No: V - 1193

ASSOCIATED CASE: _____

MAP No. 6160B
SEC. No. _____
TWP. No. _____
RANGE _____

the east-west and the north-south alleys in Block 11,

1. VACATION OF: Furley, Sedgwick Co., Kansas.
GENERALLY LOCATED: north of 101st St. North and west of Greenwich Road


744-3100

REQUESTED BY: Bobby D. Eilert, et al, Rte 1, Box 105A, Valley Center 67147

AGENT: Alan Joseph

ADDRESS: Box 2373, Suite 210, 434 N. Market. 67201 PHONE 265-9650

REASON FOR REQUEST: _____

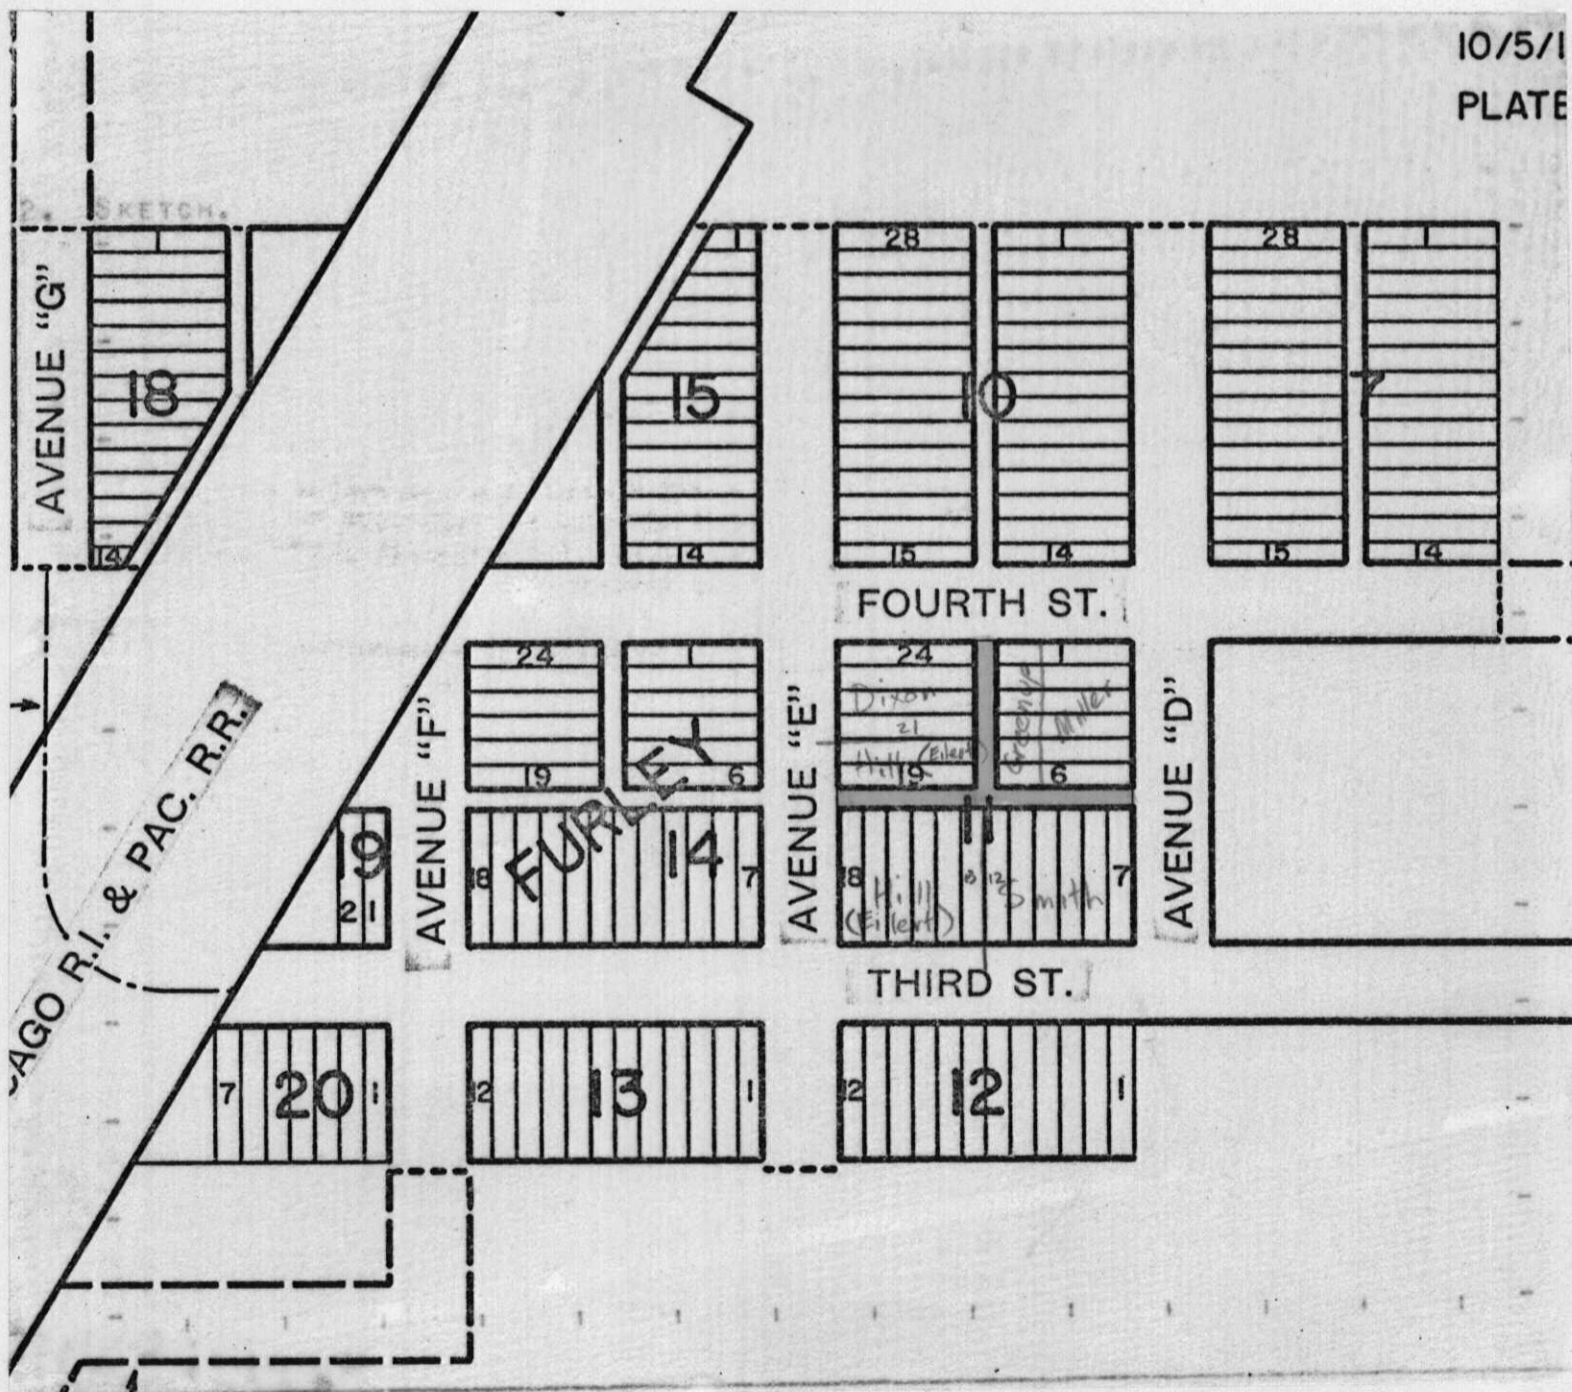

3. APPLICATION FILED 5-25-83
 POSTED TO ATLAS _____
 NOTICES SENT _____
 S/D COMM. ACTION 6-9-83 Approve
 DEPT. REPORT _____
 M.A.P.C. ACTION 6-16-83 approve
 DEPT. REPORT _____

ORD/RES. SUBMITTED _____
 APPROVED BY DEPT OF LAW _____
 B.C.C. ACTION _____
 ORD/RES _____ PUBLISHED _____
 Bd. Co. Co. ACTION 7-27-83 Approve
 ORDER TO VACATE RECORDED _____

BEFORE THE BOARD OF COUNTY COMMISSIONERS
OF SEDGWICK COUNTY, KANSAS

IN THE MATTER OF THE VACATION)
OF)
THE EAST-WEST ALLEY AND THE)
NORTH-SOUTH ALLEY IN BLOCK 11,)
FURLEY, SEDGWICK COUNTY, KANSAS.)

VACATION ORDER

Now on this _____ day of _____, 19__, at 9:00
o'clock A.M. comes on for hearing the petition filed herein by
_____, praying for the vacation of the
following described _____ alleys _____:

The east-west alley and the north-south alley in Block 11,
Furley, Sedgwick County, Kansas.

the said petitioners being represented by their attorney,
Alan Joseph.

WHEREUPON, it is shown that proper notice has been given by
publication in the _____, a newspaper printed in
the State of Kansas and being published in and for general circulation
in Sedgwick County, Kansas, the first publication being made on the
_____, day of _____, 19__, and proper proof of such
publication being filed herein. The Board being advised in the pre-
mises finds that such notice is in due legal form and conforms to K.S.A.
1970 Supp. 12-504.

THEREAFTER, the matter is presented to the Board and the Board
finds that no private rights will be injured or endangered by such
vacation and that the public will suffer no loss or inconvenience
thereby, and that in justice to the petitioners, their prayer should
be granted and that no written objections have been filed hereto with
the County Clerk.

The Board further finds that the Wichita-Sedgwick
County Metropolitan Area Planning Commission at its
regular meeting held on the 16th day of June, 1983,
recommended and approved the vacation of the above described
alleys.

IT IS THEREFORE BY THE BOARD OF COUNTY COMMISSIONERS, in regular
session duly assembled, ordered that the above described _____
hereby vacated.

JACK SPRATT, CHAIRMAN

DONALD E. GRAGG, CHAIRMAN PRO TEM

TOM SCOTT, COMMISSIONER

ATTEST:


DOROTHY K. WHITE, COUNTY CLERK

APPROVED AS TO FORM:

RICHARD EUSON, ASST. COUNTY COUNSELOR

8-9

FURLEY, Sedgwick County, Kansas.

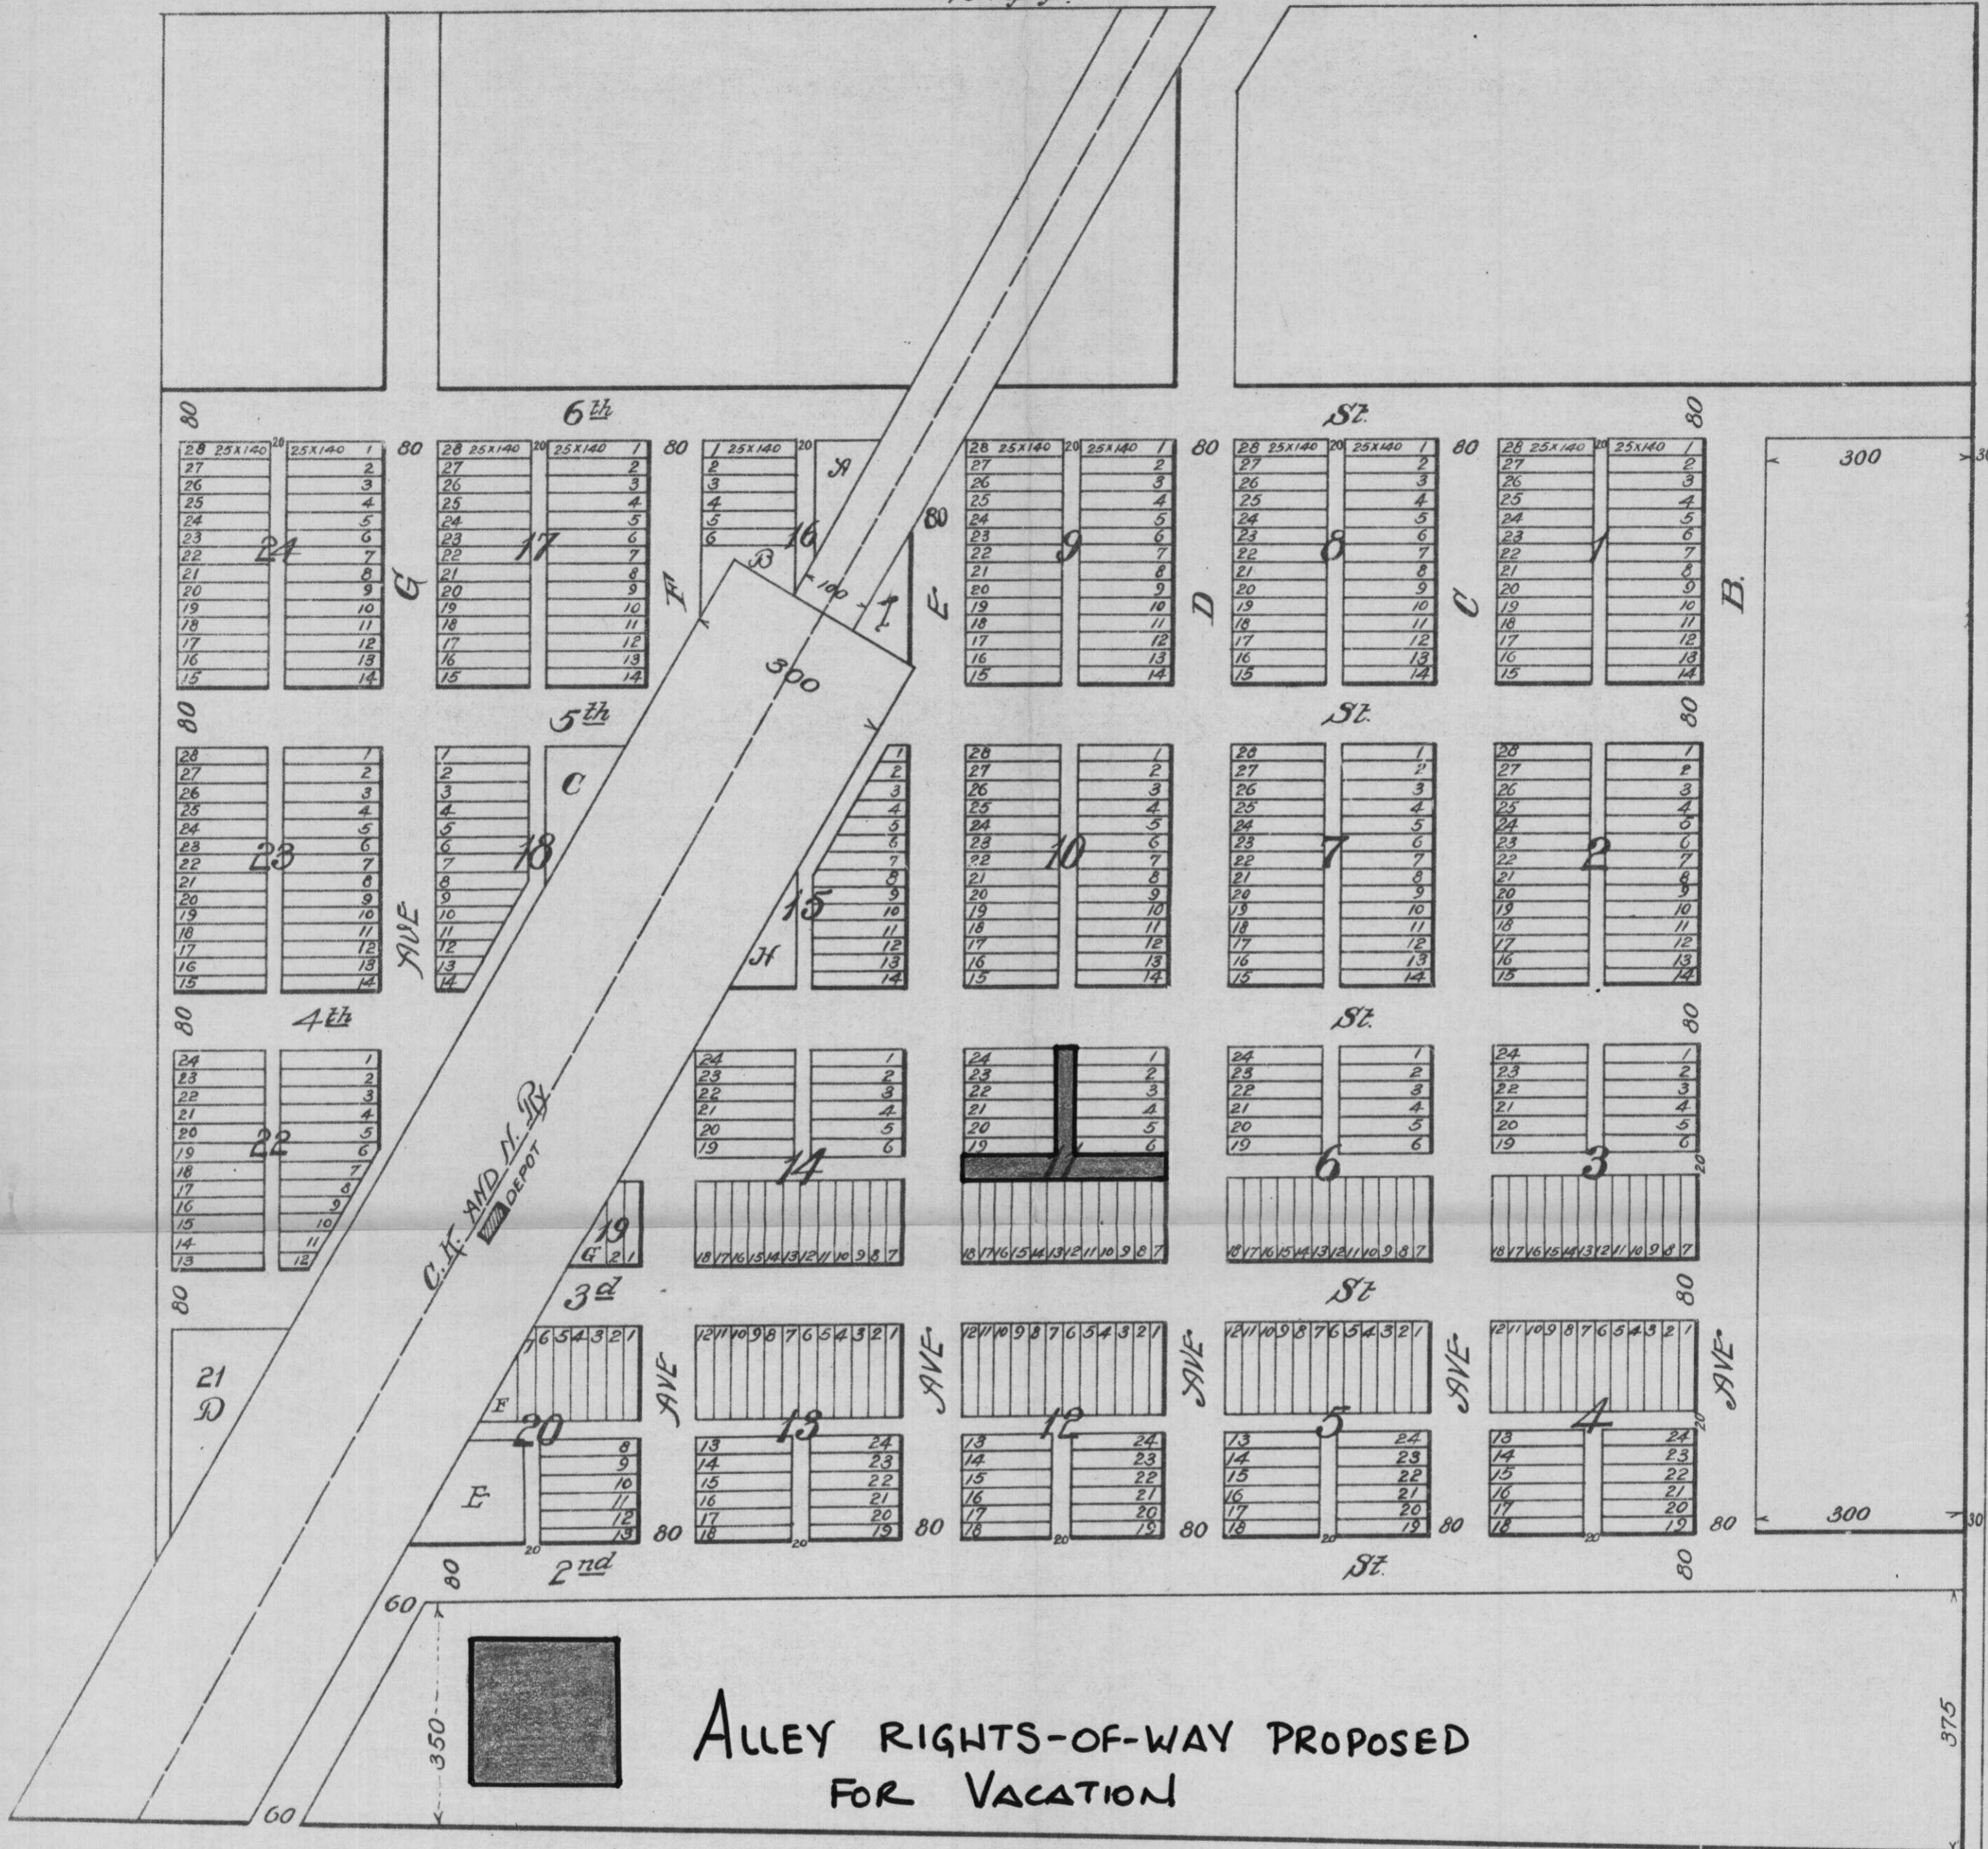

ALLEY RIGHTS-OF-WAY PROPOSED FOR VACATION

Know all men by these presents that that the Golden Belt town Company a corporation duly organized under the laws of the State of Kansas has caused this plat to be made executed and filed by it as a map or plat of a town to be known as the town of Furley, located on a part of the Northeast quarter of section sixteen (16) township twenty five (25) South of range two (2) East in Sedgwick County, Kansas. More particularly described as follows to wit:— Beginning at a point on a line running north 10°40' west three hundred and seventy five (375) feet north of and three hundred and thirty (330) feet west of the south east corner of said quarter section running thence northerly on said line seventeen hundred and twenty feet (1720) thence westerly at a right angle to said line to the west line of said quarter section, thence southerly on the west line of said quarter section seventeen hundred and twenty (1720) feet, thence easterly on a line to the place of beginning. All streets and alleys are of the width indicated on plat all lots are 25x140 feet excepting those in blocks 15, 16, 18, 19, and 22 which are of such dimensions and bounded by such streets alleys and other grounds as indicated by plat. Fractions A, B, C, D, E, F, G, H, I are of such shape and dimensions and bounded by such others grounds as plat indicates.— All streets and alleys are hereby dedicated to the public use. In witness whereof the Golden Belt town company, has caused this plat to be subscribed by its President attested to by its Secretary and the seal of said corporation to be fixed hereunto this _____ day of _____ A.D. 1887.

E.H. Kolleck President.
Charles C. Furley Secretary.

State of Kansas 7 S.3.
Marion County.

Be it remembered that on this _____ day of May A.D. 1887 before me a Notary Public in and for said county personally came a F.H. Kollock and to me known to be the identical person described in and who executed the foregoing plat as president of the Golden Belt town company and who duly acknowledged the execution of the same. In testimony whereof I have hereunto set my hand and official seal on the day and year last above written.

Willis Westerbrook,
Notary Public.

Notary Term expires Jan'y 29-1888.

State of Kansas 7 S.3.
Sedgwick County.

Be it remembered that on this 20th day of May 1887 before me a Notary Public in and for said county personally came one C.C. Furley and to me known to be the identical person described in and who executed the foregoing plat as secretary of the Golden Belt town Company and duly acknowledged the execution of the same. In testimony whereof I have hereunto set my hand and official seal the day and year above written.

W.J. Holbrook,
Notary Public.



Notary term expires June 9th 1890.

FILED 20th MAY 1887 AND RECORDED
IN PLAT BOOK P
PAGE 7.
H.D. HEISERMAN REGISTER OF DEEDS
GEO. F. BEARSE DEPUTY.

ENTERED ON TRANSFER
RECORD
MAY 20 1887
E.P. FORD CLERK

I, Joseph Bowman,
Register of Deeds of
Sedgwick County, Kansas,
do hereby certify that the
above is a true and correct
copy of the plat of Furley,
Sedgwick County, Kansas,
that the original, of which
above is a copy, is on file in
my office and that I have
the legal custody thereof.
Witness my hand and the
seal of my office this 21st day
of Feb. 1912.

Joseph Bowman
Register of Deeds.

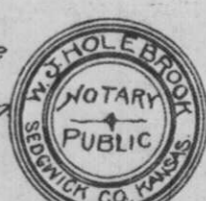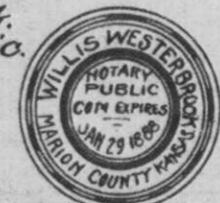

F 8-9 V-1193