

City of Wichita  
City Council Meeting  
May 12, 1987

Agenda Report # \_\_\_\_\_

TO: Mayor and City Council Members

SUBJECT: V-1453 - REQUEST TO VACATE A DRAINAGE EASEMENT, LOCATED  
IN AN AREA NORTH OF CENTRAL AND WEST OF WEBB ROAD.

INITIATED BY: Metropolitan Area Planning Department

AGENDA ACTION: Planning

-----  
MAPC Recommendation: Approve vacation of drainage easement.

Background: Lakepoint Company, 8100 E. 22nd Street North #1900, Wichita, KS 67226, is requesting this vacation to eliminate an unnecessary easement.

Analysis: The Planning Commission recommends the City Council find: (1) that no private rights will be injured or endangered; and (2) the public will suffer no loss or inconvenience by granting by order the vacation, subject to:

1. Proper publication of notice of public hearing;
2. The absence of proper written protest filed with the City Clerk;
3. All proceedings being without cost to the City, County or any utility company; and
4. Any relocation or reconstruction of utilities necessitated by this vacation shall be at the sole expense of the applicant.

Legal Considerations: The City Clerk certifies as to proper notification and no filing of written protest.

Recommendations/Action: Close public hearing; approve vacation; authorize the Mayor to sign the Vacation Order; and record certified copy of Order, recording costs to be billed to owner.

BEFORE THE CITY COUNCIL  
OF THE CITY OF WICHITA, SEDGWICK COUNTY, KANSAS

IN THE MATTER OF THE VACATION OF A PLATTED  
DRAINAGE EASEMENT.

GENERALLY LOCATED NORTH OF CENTRAL AND  
WEST OF WEBB ROAD. (V-1453)

MORE FULLY DESCRIBED BELOW

STATE OF KANSAS }  
SEDGWICK COUNTY }  
FILED FOR RECORD AT

MAY 19 1987

8 82502

NO. PAT KETTLER  
REGISTER OF DEEDS

MICROFILMED  
VACATION ORDER OF RECORD

*Ed Rea*  
Deputy

NOW on this 12th day of May, 1987, comes on for hearing the petition for vacation filed by Lakepoint Company, praying for the vacation of the following described drainage easement, to-wit:

The south 10 feet of Lot 10 and the north 10 feet of Lot 11, all in Block 2, Gatewood, an addition to Wichita, Sedgwick County, Kansas. (V-1453)

The City Council, after being duly and fully informed as to fully understand the true nature of this petition and the propriety of granting the same, makes the following findings:

1. That due and legal notice has been given by publication as required by law, by publication in the Daily Record of notice of this vacation proceeding for consecutive weeks on APR 29 & MAY 26, 1987.
2. No private rights will be injured or endangered by the vacation of the above-described drainage easement, and the public will suffer no loss or inconvenience thereby.
3. In justice to the petitioner(s) the prayer of the petition ought to be granted.
4. No written objection to said vacation has been filed with the City Clerk by any owner or adjoining owner who would be a proper party to the petition.
5. The vacation of the drainage easement described herein should be approved.

IT IS, THEREFORE, BY THE CITY COUNCIL, on this 12th day of May, 1987, ordered that the above-described drainage easement is hereby vacated. IT IS FURTHER ORDERED that the City Clerk shall certify a copy of this order to the Register of Deeds of Sedgwick County.

ATTEST:

*Dale E. Rea*  
Dale E. Rea, Deputy City Clerk


*Robert G. Knight*  
Robert G. Knight, Mayor

Approved as to Form:

*Thomas R. Powell*  
Thomas Powell, Interim Director of Law

State of Kansas )  
Sedgwick County )  
City of Wichita )  
DALE E. REA, Deputy City Clerk of the City of Wichita, Kansas, hereby certify that the document to which this is affixed is a true and correct copy of the original on file in the office of the City Clerk. Given under my hand and seal of the City of Wichita, Kansas, this MAY 12 1987  
*Dale E. Rea*  
Deputy City Clerk

city clerk

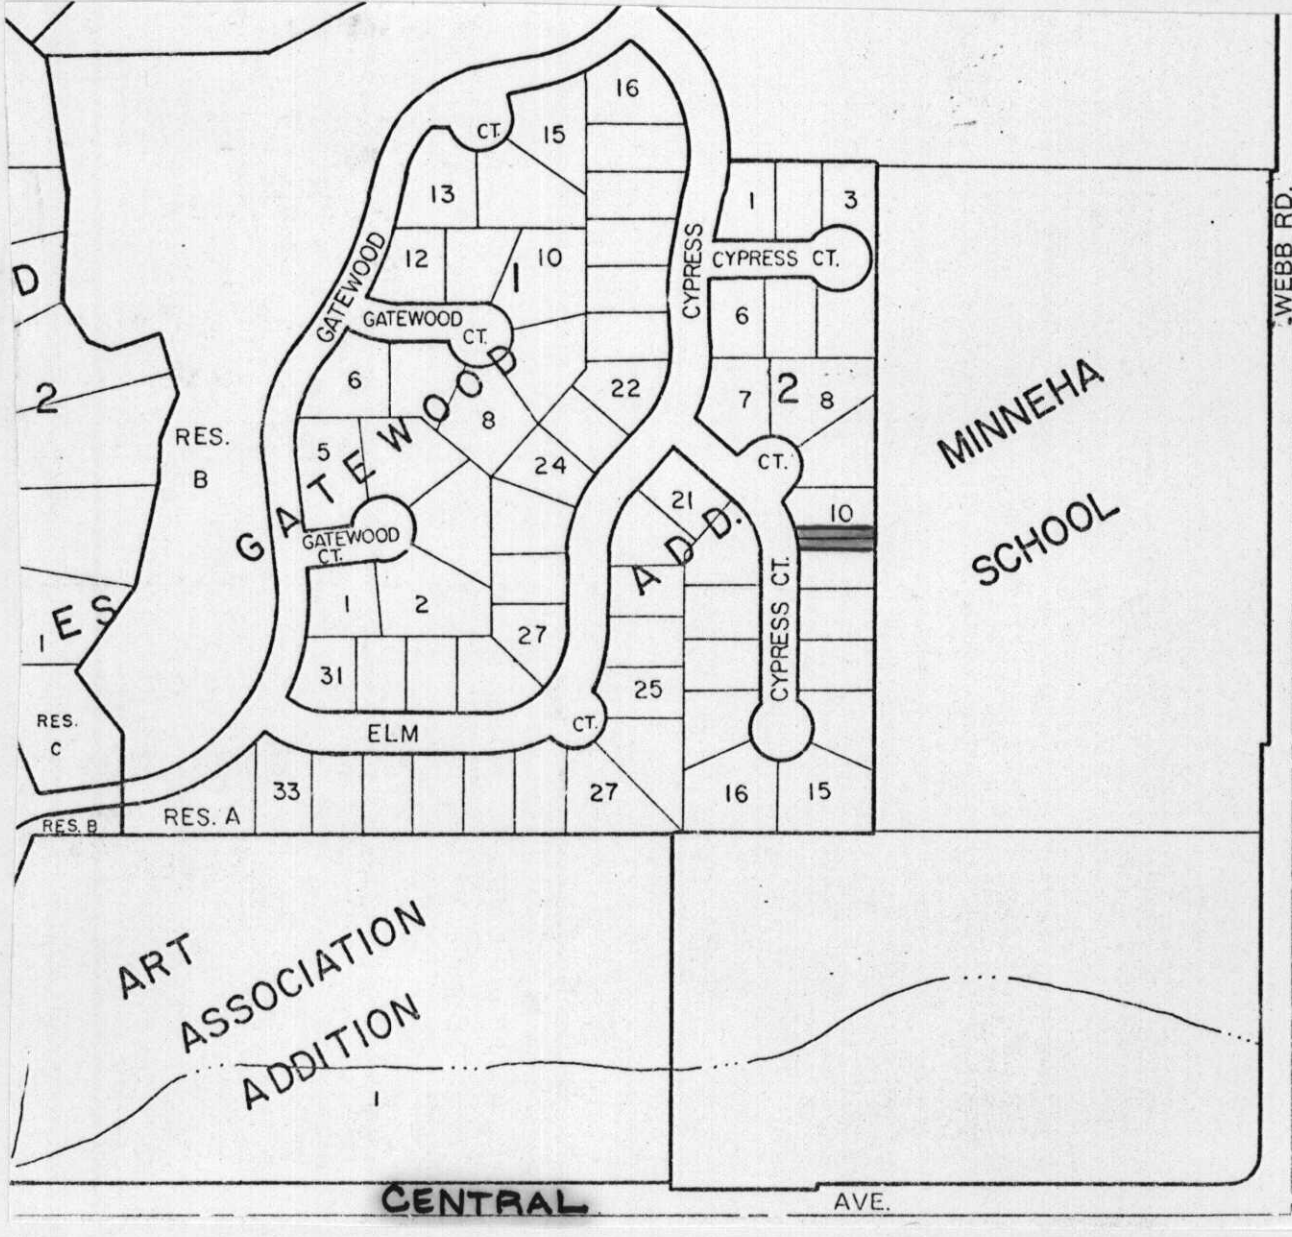

WEBB RD.

MINNEHA  
SCHOOL

ART  
ASSOCIATION  
ADDITION

CENTRAL AVE.