

Planning Agenda # _____

**City of Wichita
City Council Meeting
May 16, 1995**

Agenda Report # _____

TO: Mayor and City Council

SUBJECT: PUBLIC HEARING V-1903 REQUEST TO VACATE A PORTION OF A
BUILDING SETBACK IN AN AREA NORTH OF CENTRAL AND EAST
OF BEBE. (District #5)

INITIATED BY: Metropolitan Area Planning Department

AGENDA ACTION: Planning



Staff Recommendation: Approve vacation subject to limiting access on Central to one driveway.

MAPC Recommendation: Approve vacation of building setback. (7 - 5)

Background: This case was originally heard and approved by the City Council April 25, 1995. However, a proper publication of the legal notice did not take place and a rehearing of the case is necessary. As noted previously, this vacation of a portion of a platted building setback is being requested to allow for construction of a banking drive through facility. As a condition of the vacation it was recommended that the site be limited to the one opening presently in use for access out to Central. Two openings were originally platted, however, out to Central. At the April 25, 1995 Council's review of this case the vacation of the setback was approved without requiring a limitation on the site's access to one opening. The vacation request has been reviewed and approved by the Planning Commission, subject to conditions.

Legal Considerations: The City Clerk needs to certify as to proper notification and no filing of written protest.

Recommendations/Actions:

Close the public hearing; approve the vacation as recommended by the Planning Commission; authorize the Mayor to sign the Vacation Order; and record the certified copy of the Vacation Order; recording costs to be billed to: 150029-2909

This MAY 16 1995

Page 1 of 2

MICROFILMED
OF RECORD

**BEFORE THE CITY COUNCIL OF THE
CITY OF WICHITA, SEDGWICK COUNTY, KANSAS**

IN THE MATTER OF THE VACATION OF A	)	
BUILDING SETBACK	)	
	)	
GENERALLY LOCATED NORTH OF CENTRAL	)	Case No. V-1903
AND EAST OF BEBE	)	
	)	
<u>MORE FULLY DESCRIBED BELOW</u>	)	

VACATION ORDER

NOW on this 16th day of May, 1995, comes on for hearing the petition for vacation filed by Central National Bank, etal, praying for the vacation of the following described building setback, to-wit:

Beginning 30 feet East and 38 feet South of the Northwest corner of Lot 1, William G. Farha Addition to Wichita, Kansas; Thence West 13 feet; Thence South 28 feet; Thence East 13 feet; Thence 28 feet to beginning. (V-1903)

The City Council, after being duly and fully informed as to fully understand the true nature of this petition and the propriety of granting the same, makes the following findings:


1. That due and legal notice has been given by publication as required by law, by publication in the Daily Reporter of notice of this vacation proceeding for consecutive weeks on 4/25/95 + 5/5/95.
2. No private rights will be injured or endangered by the vacation of the above-described building setback, and the public will suffer no loss or inconvenience thereby.
3. In justice to the petitioner(s), the prayer of the petition ought to be granted.
4. No written objection to said vacation has been filed with the City Clerk by any owner or adjoining owner who would be a proper party to the petition.
5. The vacation of the building setback described herein should be approved.

Rock


Vacation Order
V - 1903


Page 2 of 2

IT IS, THEREFORE, BY THE CITY COUNCIL, on this MAY 16 1995
ordered that the above-described building setback is hereby vacated. IT IS FURTHER
ORDERED that the City Clerk shall certify a copy of this order to the Register of Deeds of
Sedgwick County.

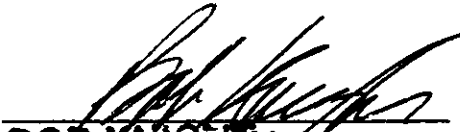
BOB KNIGHT Mayor

ATTEST:

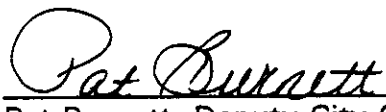

Pat Burnett, Deputy City Clerk

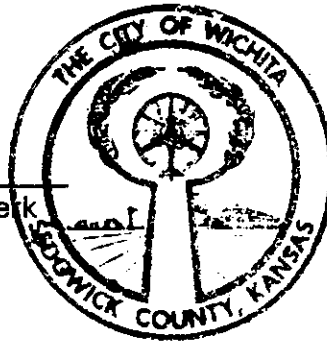

Approved as to Form:


Gary Rebenstorf, Director of Law

State of Kansas)
Sedgwick County) ☒
City of Wichita)
I, Tom Schneider, Deputy City Clerk of the City
of Wichita, Kansas, hereby certify that the document
to which this is affixed is a true and correct copy of
the original on file in the office the the City Clerk.
Given under my hand and seal of the City of
Wichita, this May 19, 1995
Tom Schneider Deputy City Clerk

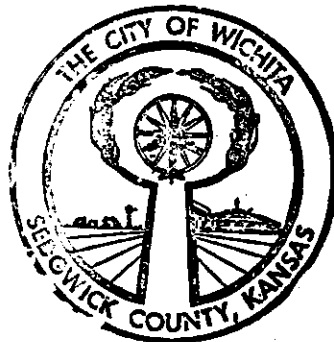

STATE OF KANSAS) SS
SEDGWICK COUNTY)
FILED FOR RECORD AT
10-00

1455565 $\pm$ 26 $\frac{55}{100}$
PAT KETTLER
REGISTER OF DEEDS


Handwritten signature/initials

BEBE

30' R/W

142.5'

132.5'

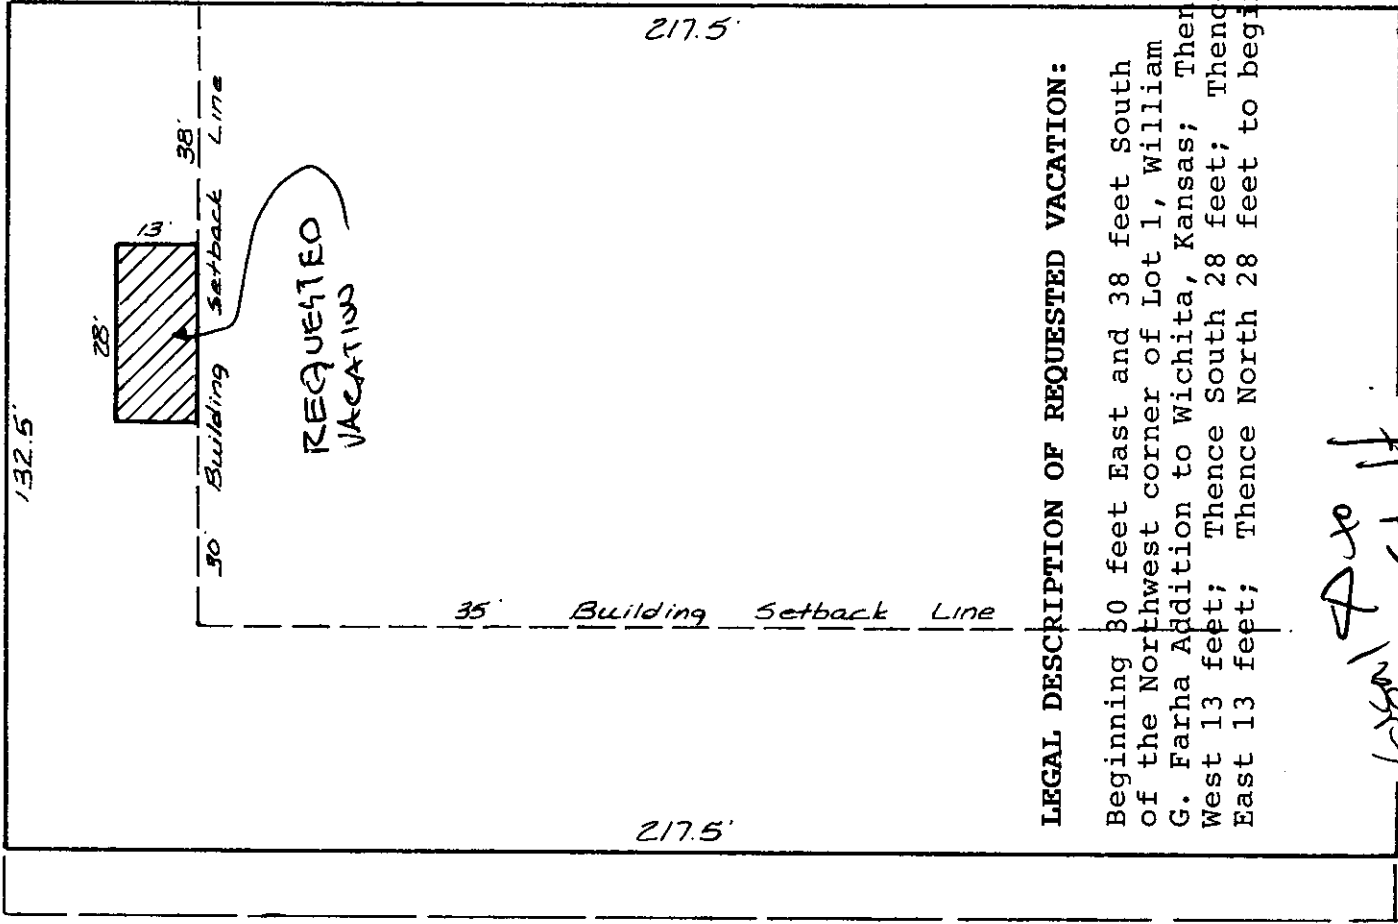

LEGAL DESCRIPTION OF REQUESTED VACATION:

Beginning 30 feet East and 38 feet South of the Northwest corner of Lot 1, William G. Farha Addition to Wichita, Kansas; Thence West 13 feet; Thence South 28 feet; Thence East 13 feet; Thence North 28 feet to beginning.

Legal Description
Use as
Report etc.

40' R/W

CENTRAL

