



Wichita-Sedgwick County Metropolitan Area Planning Department

February 9, 2011

Richard Lopez
1020 N. Main St.
Wichita, KS 67203

Tom Arnold
354 S. Lulu
Wichita, KS 67211

Re: BZA2011-00003: City Administrative Adjustment to reduce parking by 14% on NR Neighborhood Retail ("NR") zoned site.

Legal Description: Lots 39-45 & the North 17' of Lot 46 on Main Street; North Main Street 2nd Addition, Wichita, Sedgwick County, Kansas. Generally located north of 9th Street east of Main Street, approximately 250 feet north of 9th Street North (1020 N. Main St.).

Dear Applicants:

We have reviewed your request for a Zoning Adjustment to reduce the parking requirement for the building remodel on the site of the aforementioned property. From reviewing your application we understand that you propose to remodel an existing structure on the site that will be required to have 44 parking spaces. The resulting parking requirement is 6 more spaces that the site can provide resulting in only 38 available spaces. Therefore, you have requested a Zoning Adjustment to reduce the parking requirement for the remodel from 44 spaces to 38 spaces.

Sec. V-I.2.i of the Code allows up to a 25% reduction of parking requirements for remodeling/expansion projects when the conditions required by Sec. V-I.6 of the Code are met. We find that reducing the parking requirement for the new retail use from 44 spaces to 38 spaces meet the four conditions required by Section V-I.6 of the Code as set out below:

- 1) Impact on safety and convenience of vehicular and pedestrian circulation: The extent of the parking requirement reduction is less than the allowable limit of 25%; therefore, sufficient on-site parking should be provided such that on-street parking for the use should not and will not be necessary. Since all parking for the use should be off-street, there should not be negative impacts

City Hall • 10th Floor • 455 North Main • Wichita, Kansas 67202-1688

T 316.268.4421 **F** 316.268.4390

www.wichita.gov


on the safety and convenience of vehicular and pedestrian circulation in the area.

- 2) Impact on existing uses in surrounding areas: There should not be a negative impact on the existing uses in the surrounding areas as a result of reducing the parking requirement. Parking for the use should not encroach or encumber any uses adjacent to this property and will be appropriately landscaped.
- 3) Compatibility with existing or permitted uses on abutting sites: Reducing the parking requirement should not compromise existing or permitted uses on abutting commercial sites due to the minor nature of the reduction of the parking requirement.
- 4) Effect on public health, safety or welfare: There will be no encroachment into public utility easements or right-of-way; therefore, there should not be a negative impact on the public health, safety or welfare nor will properties or improvements in the vicinity be materially injured.


Our signatures below indicate that a Zoning Adjustment to reduce the parking requirement for the remodel of the existing structure on the site from 44 spaces to 38 spaces is hereby granted subject to the following conditions:

- 1) The site shall be developed in accordance with the approved site plan.
- 2) The parking area shall be paved and marked in accordance with the site plan.
- 3) If the Zoning Administrator finds that there is a violation of any of the conditions of the Zoning Adjustment, the Zoning Administrator, in addition to enforcing the other remedies set forth in Article VIII of the Unified Zoning Code, may, with the concurrence of the Planning Director, declare that the Zoning Adjustment is null and void.

The zoning adjustment sign may now be removed from the property.

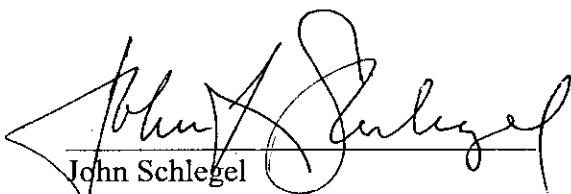

John Schlegel
Planning Director

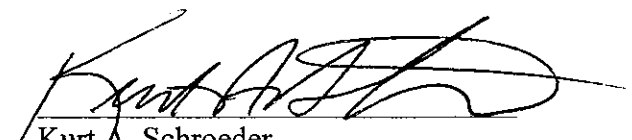


Kurt A. Schroeder
Superintendent of Central Inspection

cc: Paul Hays, Office of Central Inspection
Richard Chamberlin, Office of Central Inspection
Leonard Fox, Office of Central Inspection
JR Cox, Office of Central Inspection
Dale Miller, MAPD

APPROVED

BZH2011-000003

Date: 2-9-11

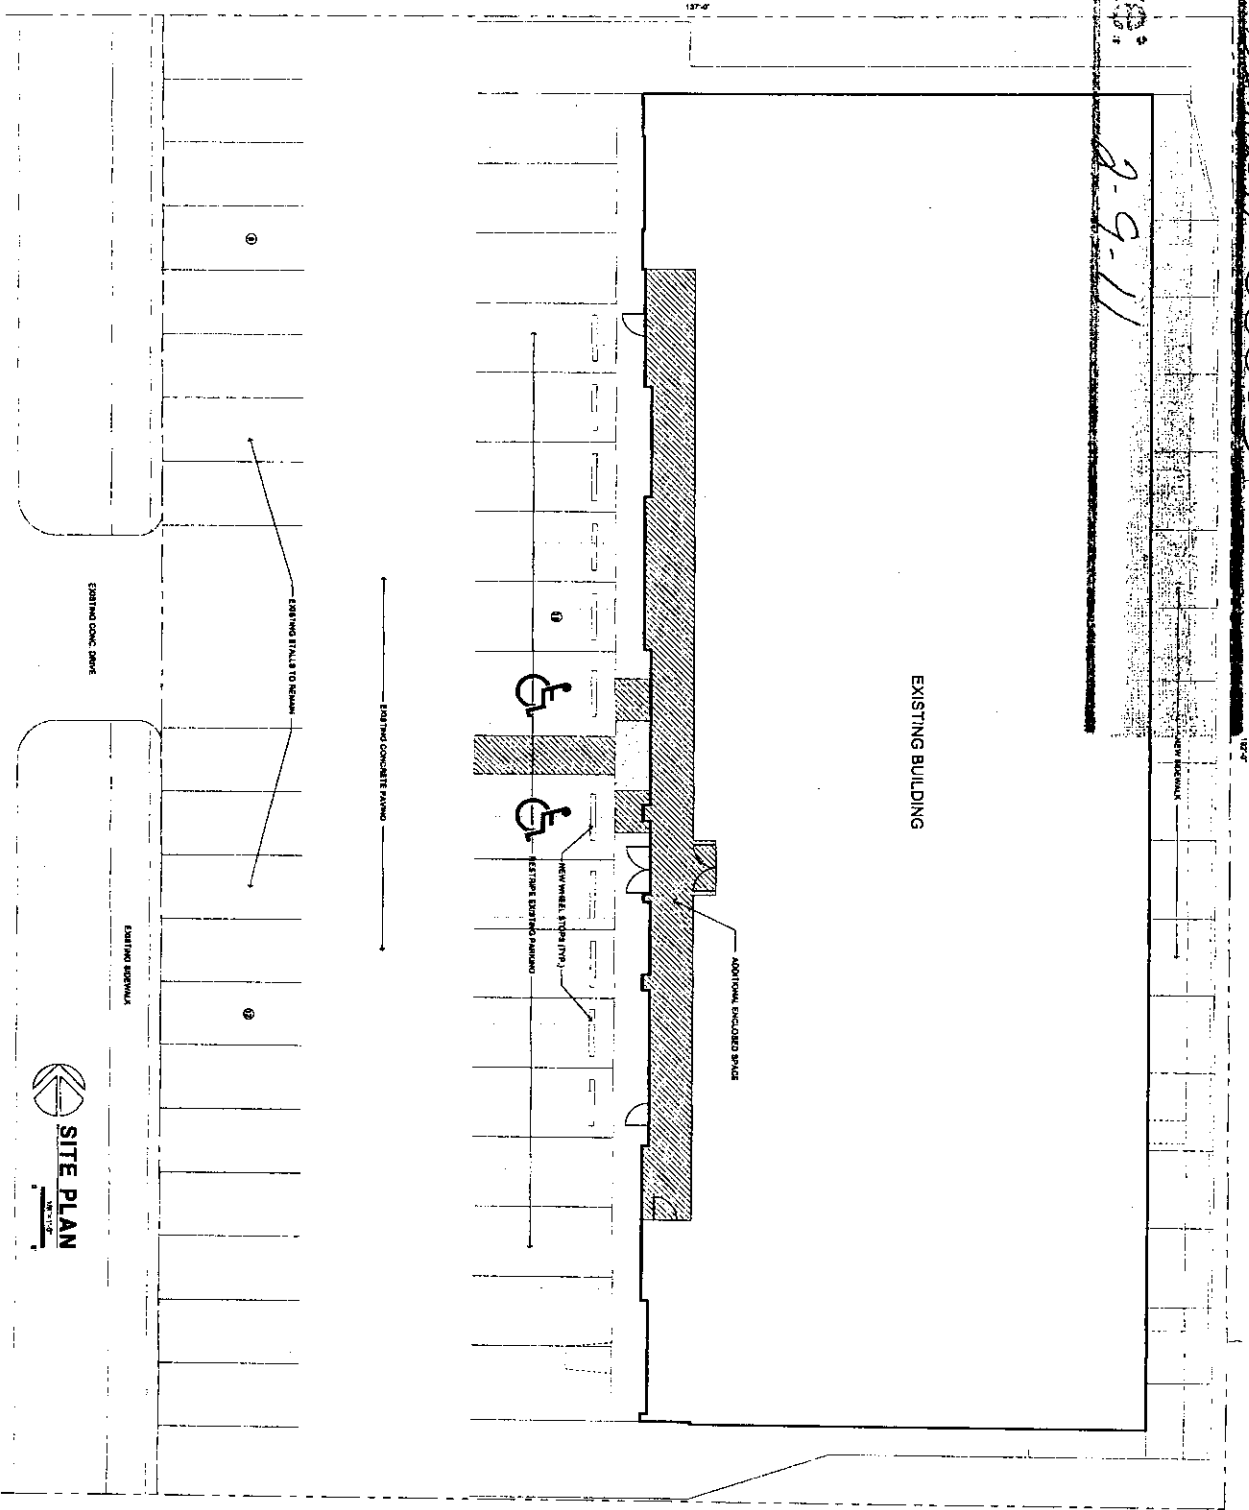

EXISTING BUILDING

ADDITIONAL ENCLOSED SPACE

NEW WHEEL STOP (175')

EXISTING EXTERIOR PARKING

EXISTING CONC DRIVE

EXISTING SIDEWALK


EXISTING SIDEWALK

EXISTING CONC DRIVE

MAIN STREET

SITE PLAN
SCALE: 1/8" = 1'-0"

VICINITY MAP

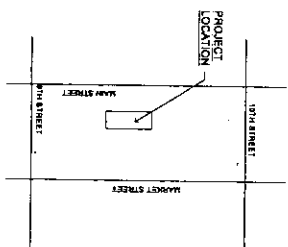

BUILDING AREA
8,841 S.F. ORIGINAL
8,841 S.F. TOTAL
10,079 S.F. TOTAL

PARKING SPACES
EXISTING
31 STANDARD STALLS
21 ACCESSIBLE STALLS
50 TOTAL
PROPOSED
36 STANDARD STALLS
4 ACCESSIBLE STALLS
40 TOTAL

HODGENS - EL ZOCCOLO

1020 N. Main - Wichita, K

SPANGENBERG PHILLIPS TICE
ARCHITECTURE
121 N. Mead Ste 201 Wichita KS 67202
T 316.267.4002 F 316.257.1509
www.sptarchitecture.com



17 JAN 11
SITE PLAN

SP1