SCOTT KNEBEL
8202 E KELLOGG
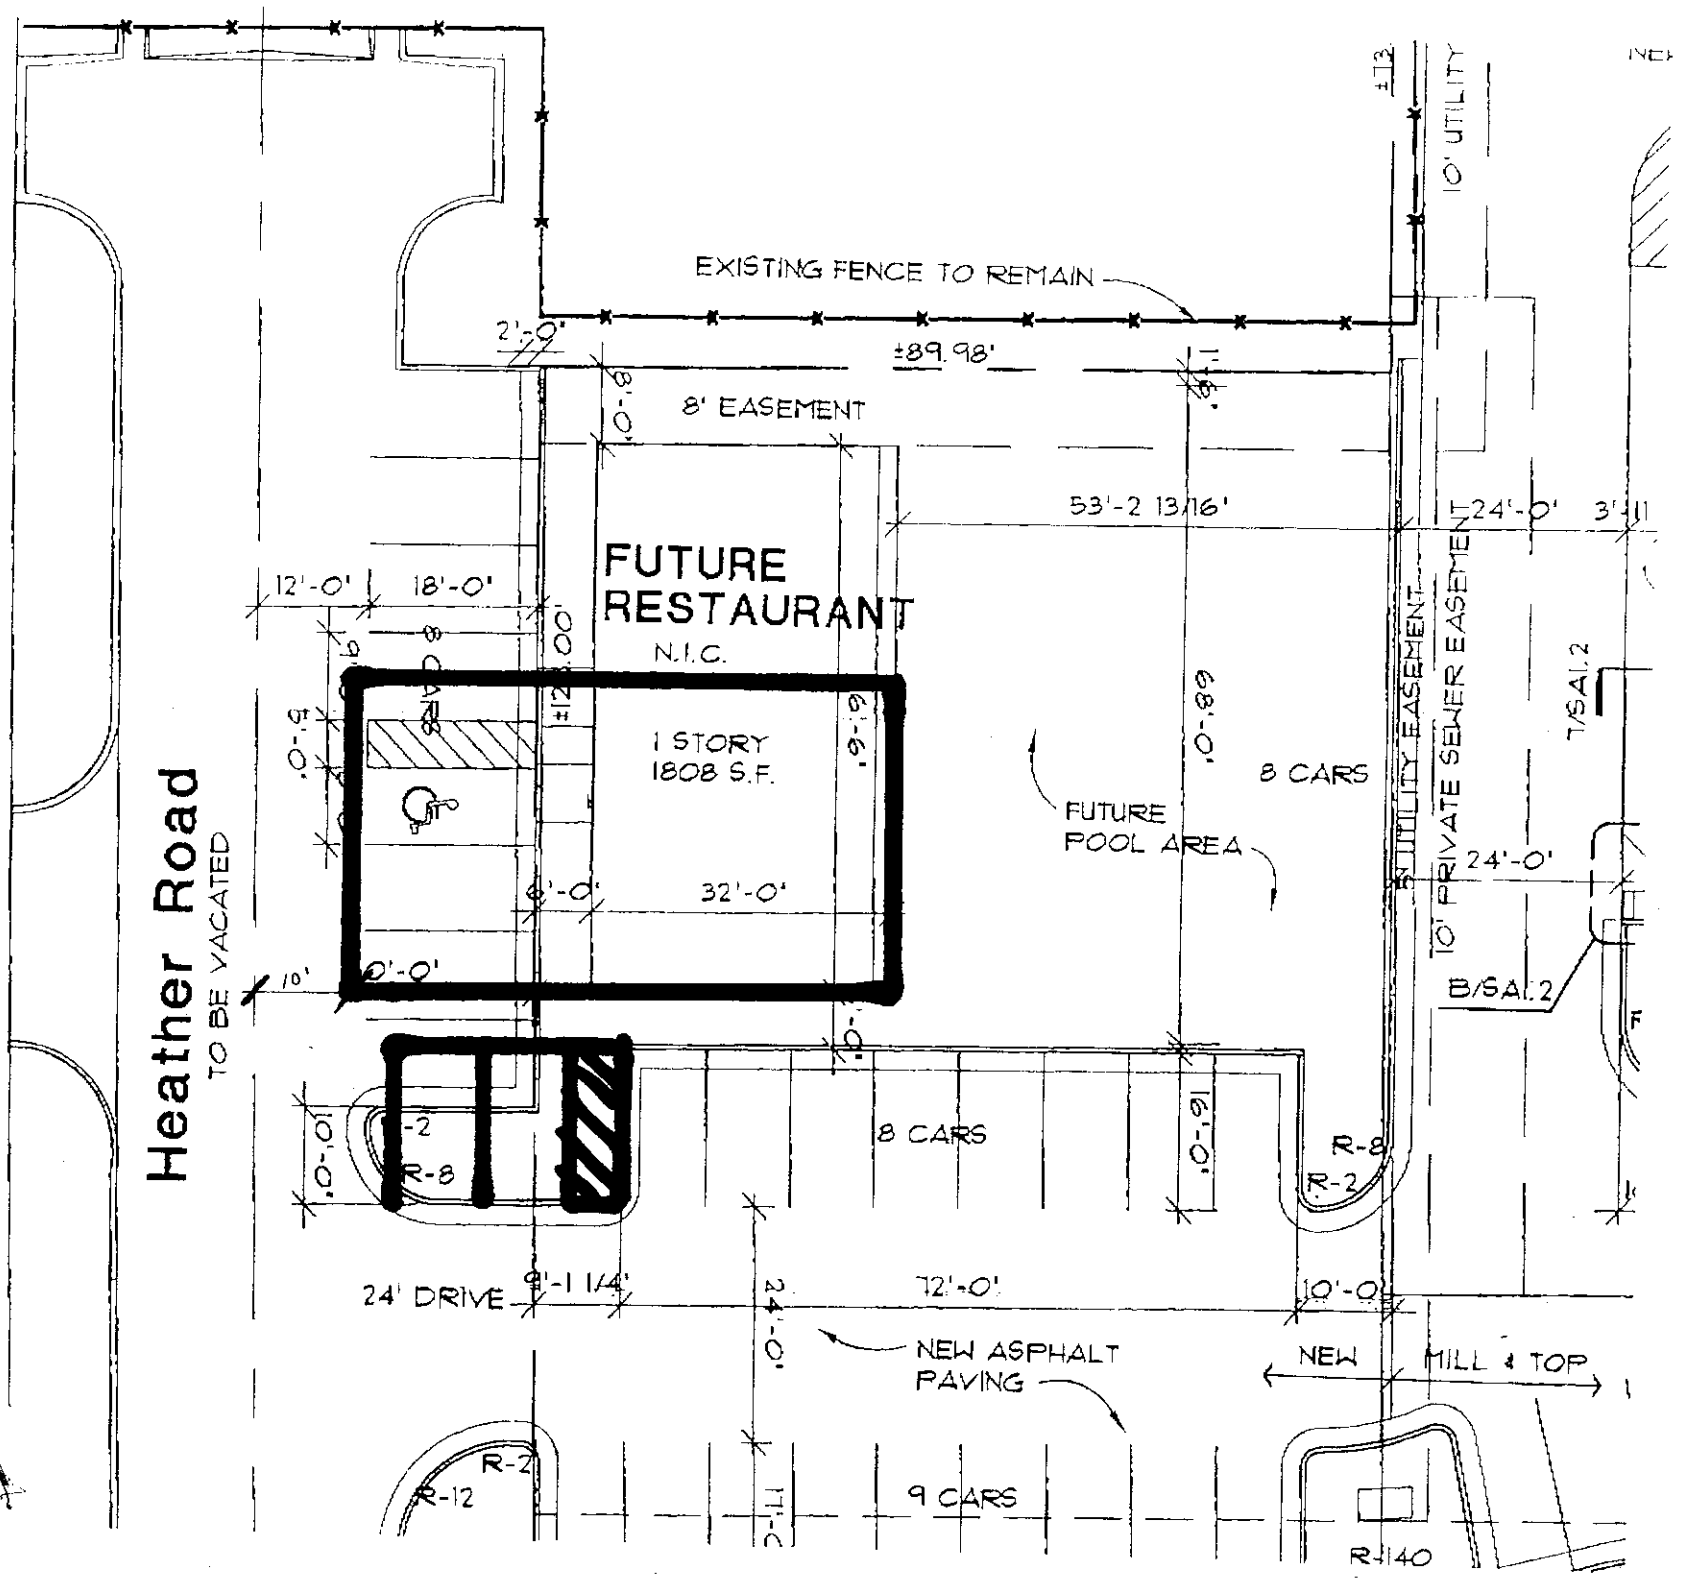
closed due to inactivity