



Wichita-Sedgwick County Metropolitan Area Planning Department

January 10, 2008

William Morris
2020 W Dooley
Wichita, KS 67213

Re: BZA2007-78: Zoning Adjustment to permit an accessory structure to be placed in front of the principal structure on less than five acres.

Legal Description: Lots 73, 75, 77, and 79, Block G, Shearman's Addition to Wichita, Sedgwick County, Kansas. Generally located north of W Dooley and west of Hiram (2020 W Dooley).

Dear Applicant:

We have reviewed your request for a Zoning Adjustment to permit an accessory structure in front of the principal structure on less than five acres. From reviewing your application, we understand that you propose to construct a 30' x 40' detached garage on a .34-acre lot, south of the primary structure, and therefore technically in front of the primary structure.

Sec. V-I.2.n. of the Unified Zoning Code allows a Zoning Adjustment that would permit an accessory structure to be placed in front of the principal structure on less than five acres of land, when the conditions required by Sec. V-I.6. of the Code are met. We find that permitting an accessory structure in front of the principal structure on your property meets the four conditions required by Sec. V-I.6. of the Unified Zoning Code as set out below:


- 1) Impact on safety and convenience of vehicular and pedestrian circulation: This request is for a detached garage on a residential lot. Public vehicular and pedestrian circulation will not be affected as the garage will provide sufficient space for parking vehicles on the property and will not interfere with traffic circulation patterns.
- 2) Impact on existing uses in surrounding areas: There should be no negative impact on the existing uses in surrounding areas as a result of the garage being placed in front of the house, as the structure will meet the zoning required building setback. The detached garage will not be in the front view of any existing residences; property facing this site from the south is zoned LI and developed with industrial uses.

- 3) Compatibility with existing or permitted uses on abutting sites: Placing an accessory structure in front of a principal structure is within allowable adjustments. The proposed accessory structure should not detract from the existing or permitted uses on abutting sites, as surrounding residences do not face this site.
- 4) Effect on public health, safety or welfare: There will be no encroachment into public utility easements or right-of-way; therefore, there should be no negative impact on the public health, safety or welfare nor will properties or improvements in the vicinity be materially injured.


Our signatures below indicate that a Zoning Adjustment to permit an accessory structure to be placed in front of the principal structure on less than five acres of land for the aforementioned property is hereby GRANTED, subject to the following conditions:

- 1) The site shall be developed in general conformance with the approved site plan, and all permits necessary to construct the improvements shall be acquired.
- 2) The allowance of an accessory structure in front of the principal structure shall apply only to the "detached garage" illustrated on the approved site plan. All other structures or additions on the subject property shall conform to the development standards of the Unified Zoning Code unless a separate Zoning Adjustment or Variance is granted.
- 3) If the Zoning Administrator finds that there is a violation of any of the conditions of the Zoning Adjustment, the Zoning Administrator, in addition to enforcing the other remedies set forth in the Unified Zoning Code, may, with the concurrence of the Planning Director, declare that the Zoning Adjustment is null and void.

The "Development Application" sign should now be removed from the property.

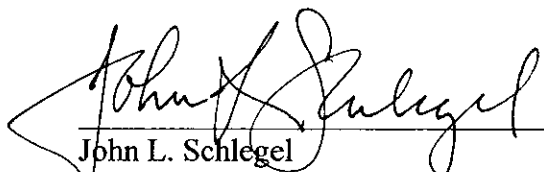

John L. Schlegel
Planning Director

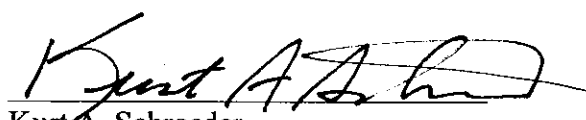

Kurt A. Schroeder
Superintendent of Central Inspection

cc: Kurt Schroeder, Office of Central Inspection
Mike Gable, Office of Central Inspection
Paul Gray, District IV

WALKER
 CM 467.81 S89°40'23"W
 P 462.0

NOT TO SCALE
 SITE PLAN BZA2007-78

Alvin J. Leung


Date: *Jan - 10 - 08*

BONN

HIRAM

M-459.85 S0°00'00"E
 P-460.0

M-459.85 N0°05'59"W
 P-460.0

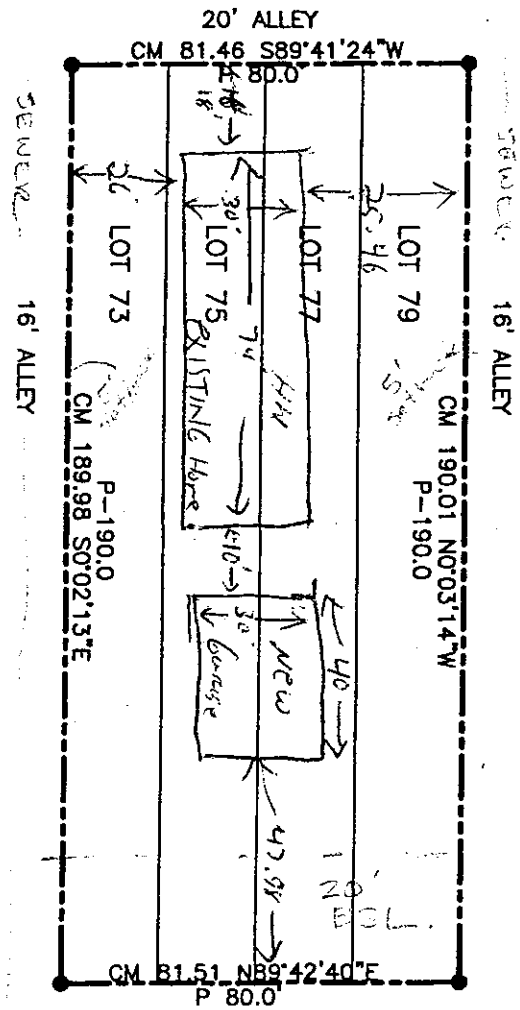

SCALE 1"=20'

- "Armstrong" capped rebar set
- ⊙ iron in thimble found
- 3/4" iron pipe found
- M calculated from measurements
- P plat distance

P 30'
 CM 137.53 N89°42'40"E
 P 135.0

CM 137.53 N89°42'40"E
 P 135.0

DOOLEY
 CM 468.62 N89°42'40"E
 P 462.0

202158.
 3 zoning