K

GRAND TOTALS

	CITY	PROPERTY
	41.8	394.4
	19.7	66.4
	60.5	123.0
	6.1	895.6
+00	66.6	39.6
		855.2
	CU. YDS. EXC.	CU. YDS. F.&C.

NOTE: ALL CURVE DATA FOR BACK OF CURB

CURVE DATA FOR BOTH CURVES
Δ = 14°42'
R = 155.82'
T = 20.09
BK OF CO. -1+38.09 Sta. -77.71 L. 3823'
BK OF CO. -77.71 Sta. -576 L. 3810'
E. BOTH CURVES L. 4190

NOTE:
HORZ. STATIONINGS ARE ON W/E.
VERT. STATIONINGS ARE ON BACK OF WEST CURB FROM 0+00 TO 23+28.09. VERTICAL STATIONINGS ARE ON BACK OF EAST CURB FROM -1+38.09 TO 0+00

NOTE!
STA. 0-576 TO 9+30
N.C.G. ON +1.27%
GRADES

DRIVE

+0.62%
+1.22%
-1.0%
-0.10%
-0.10%

P.I. 2+30 El. 120.95 No V.C.
P.I. 3+45 El. 122.35 No V.C.
P.I. 4+30 El. 121.50 No V.C.

TIES TO TACKSTAKE 1+59 10'N TO E&ON & CL VACATED ALLEY 8.38'W TO "X" ON N SIDE OF DRIVE

BM	124.26	NW CORNER NW WINGWALL BRIDGE 18TH & LITTLE ARKANSAS RIVER
BM	121.02	60" SPIKE GUY POLE SW CORNER 17TH & FERRELL
BM	122.74	SE CORNER STONE PORCHWALL HOUSE 1693 FERRELL
BM	122.25	60" SPIKE E SIDE PP SW CORNER 15TH & FERRELL
BM	126.01	"X" ON TOP OF E. CURB N END OF RADIUS JEANNETTE & FERRELL

K. WHITE LICENSED KANSAS PROFESSIONAL ENGINEER 55

FERRELL DRIVE

EL. JEANETTE TO SL 17TH
30' CONC. & CB.
CITY OF WICHITA KANSAS
L.K. WHITE — CITY ENGINEER
JAN 1951 — PROJ. NO. C11-136

1/4

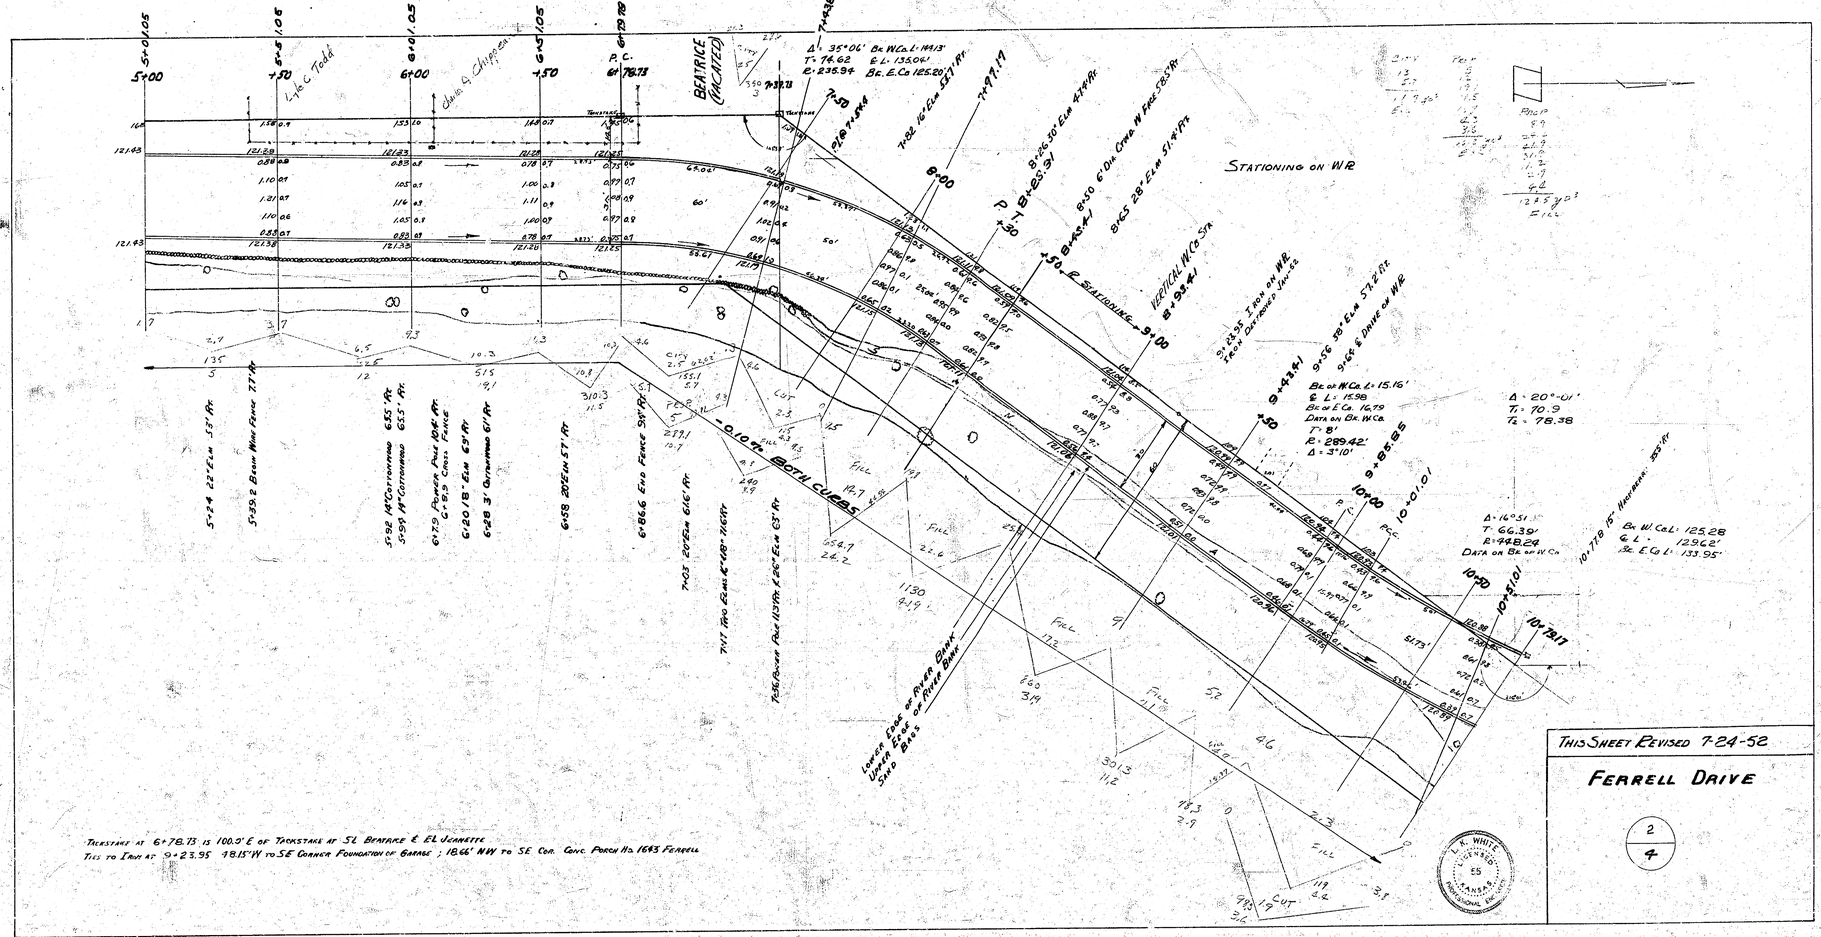

TICKSTAKE AT 6+78.73 IS 100.0' E OF TACKSTAKE AT SL BEATRICE & EL VIGNETTE
TIES TO IRON AT 9+23.95 78.15' W TO SE CORNER FOUNDATION OF GARAGE ; 18.66' NW TO SE COR. CONC. PORCH NO. 1683 FERRELL

THIS SHEET REVISED 7-24-52

FERRELL DRIVE

2/4

HEISERMAN

FERRELL DRIVE

AVE

16TH ST. VACATED

STATIONING ON W'LY OF FERRELL DRIVE 11+62.45 TO 16+81.1
STATIONING ON W'LY OF HEISERMAN 10+79.17 TO 11+62.45

3/4

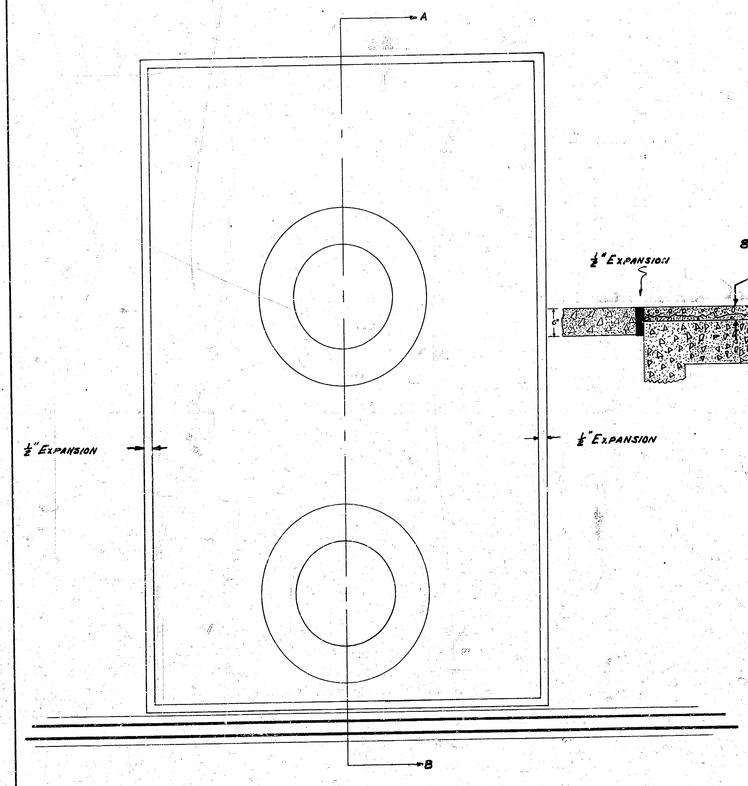

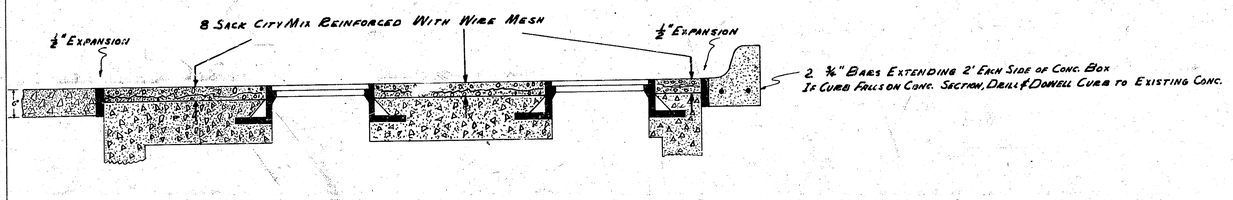

Section AB

DETAIL FOR PAVING OVER 7×11 CONCRETE BOX AT STA. 3+46

FERRELL DRIVE

4/4

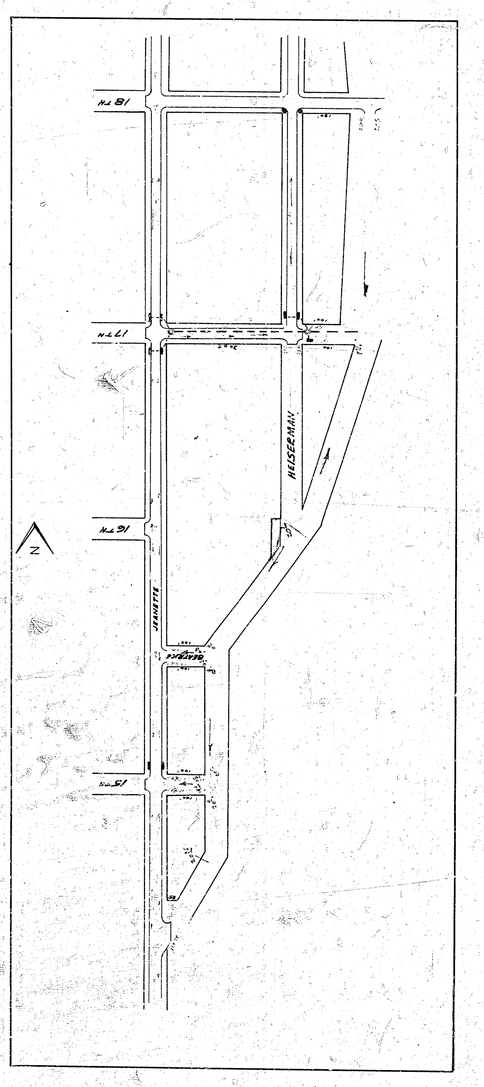
N. 18 TH
N. 17 TH
N. 16 TH
N. 15 TH
JEANETTE
AVENUE
HEISSE MAN
N