



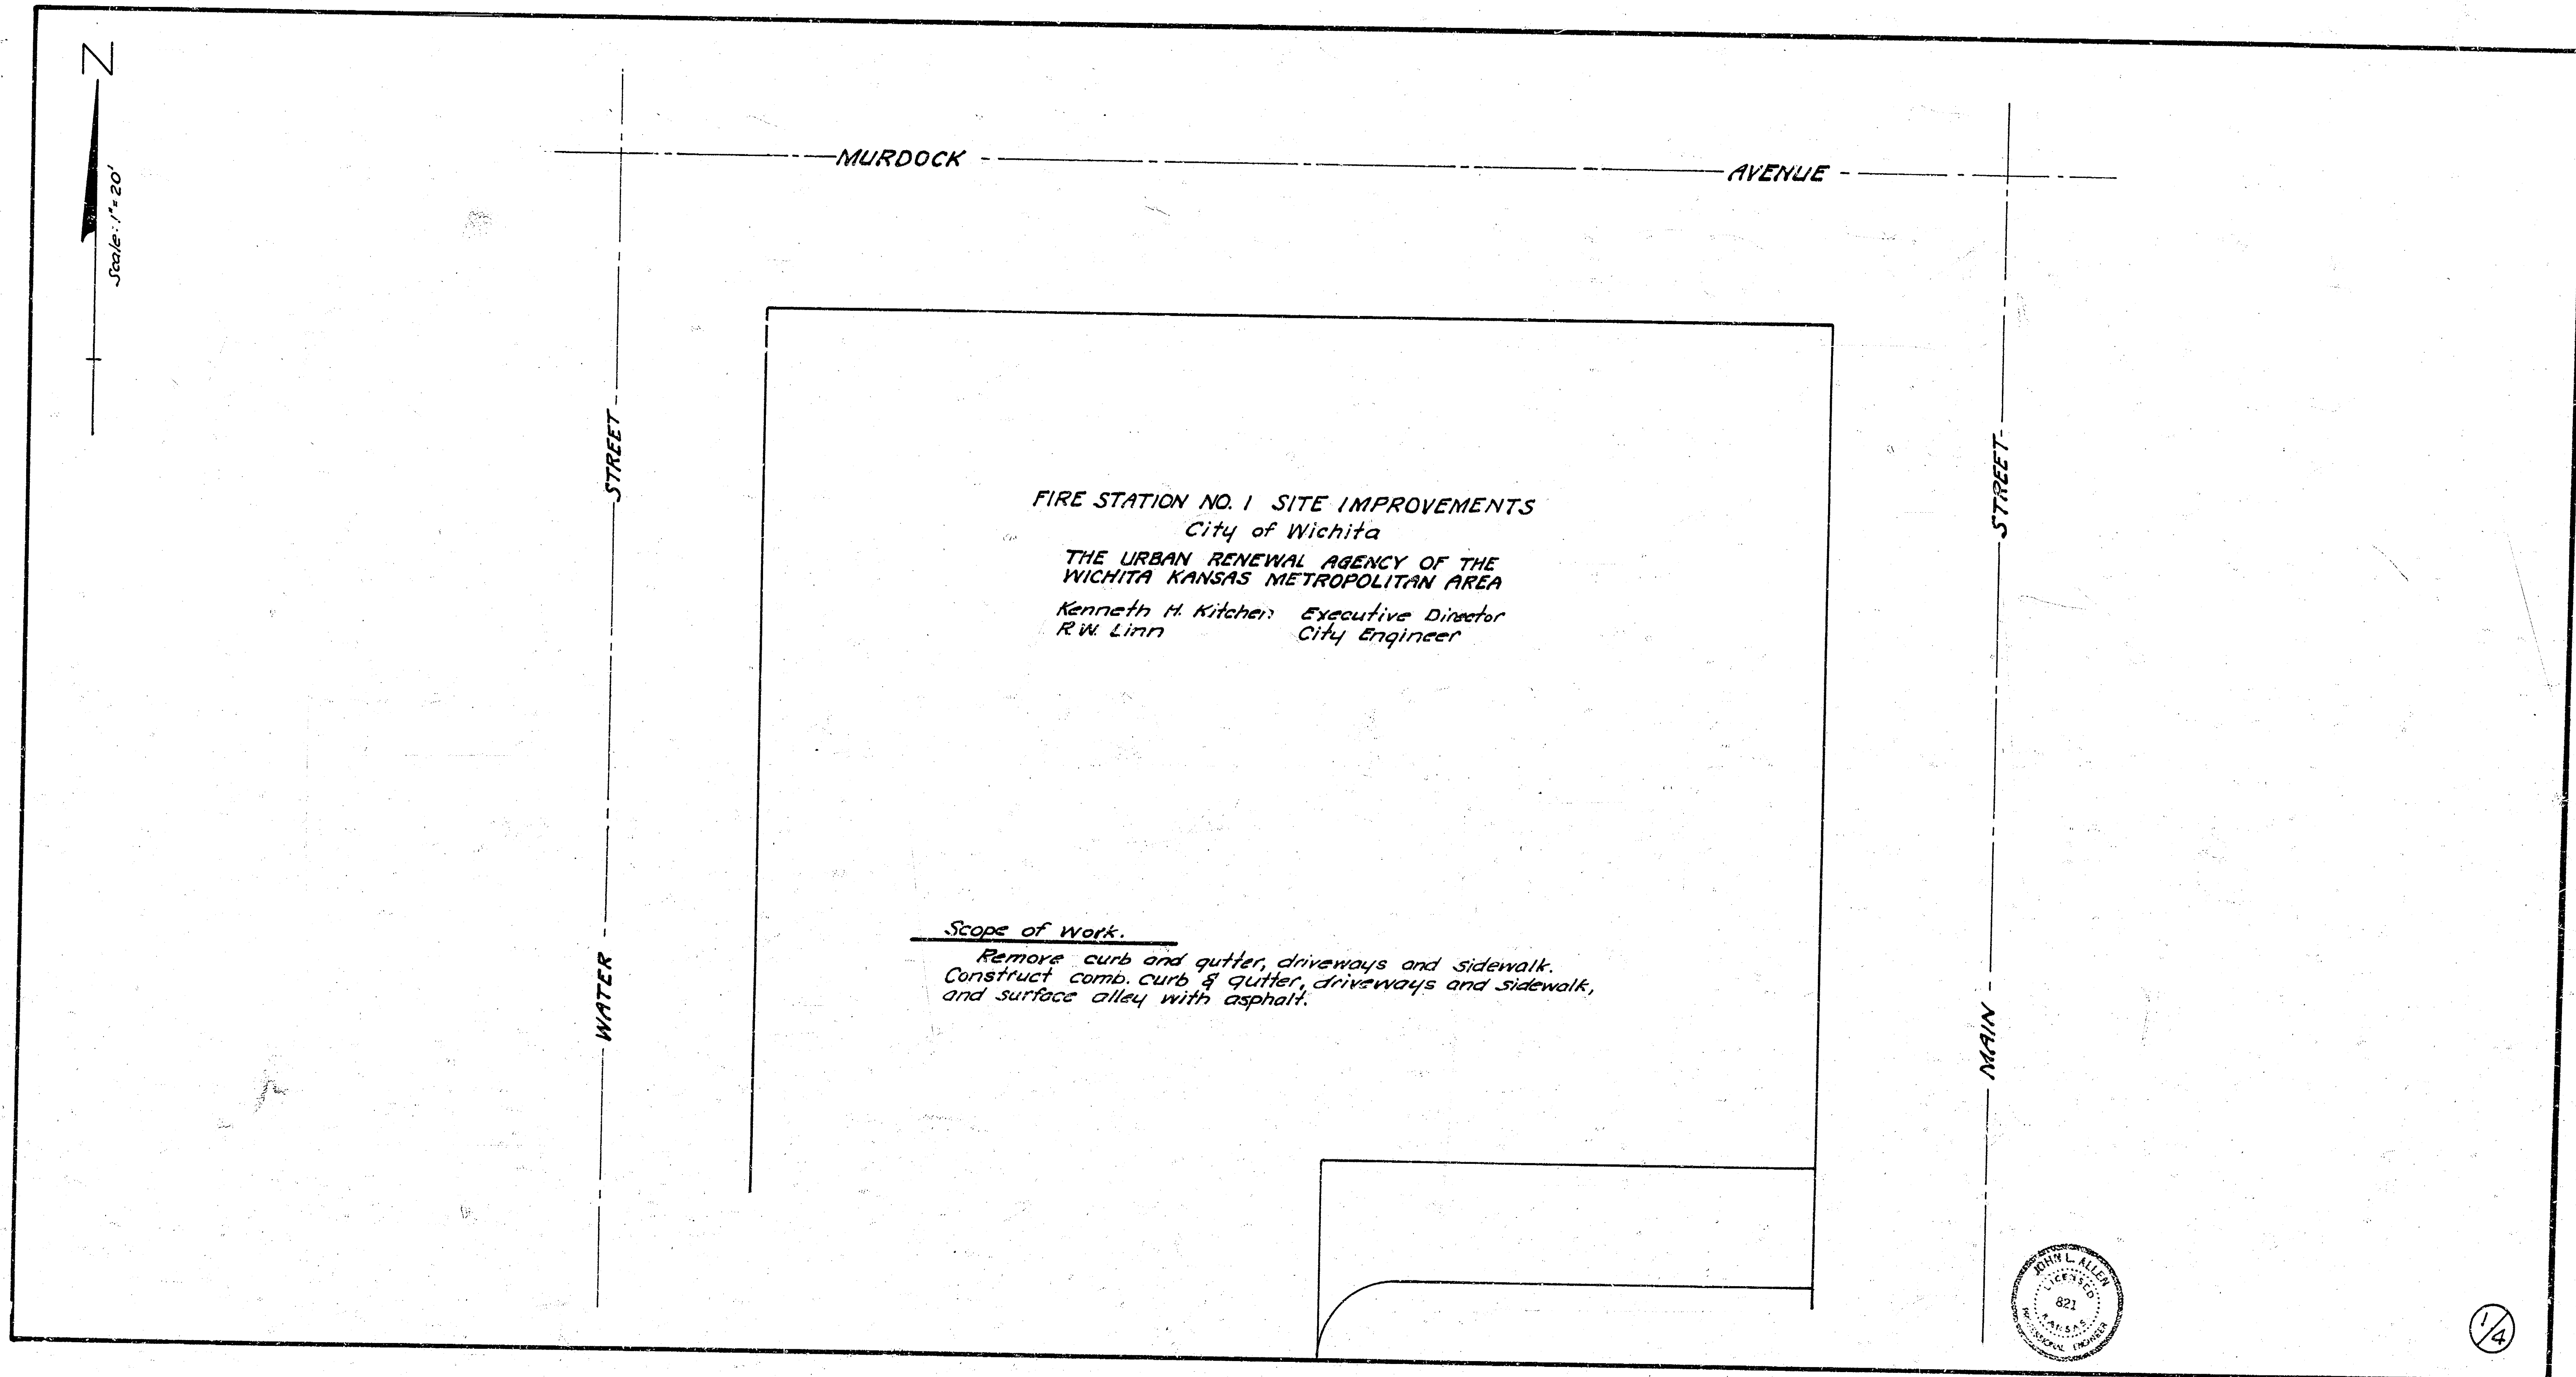


100-170
100-171
Scale: 1"=20'

B.M. 114.71 R.R. Spike S. Side P. Pole
on N.E. corner Water & Murdock

B.M. 114.28 "a" cut top curb of radius N. side
2' x 2' catch basin on NW cor. Main & Murdock

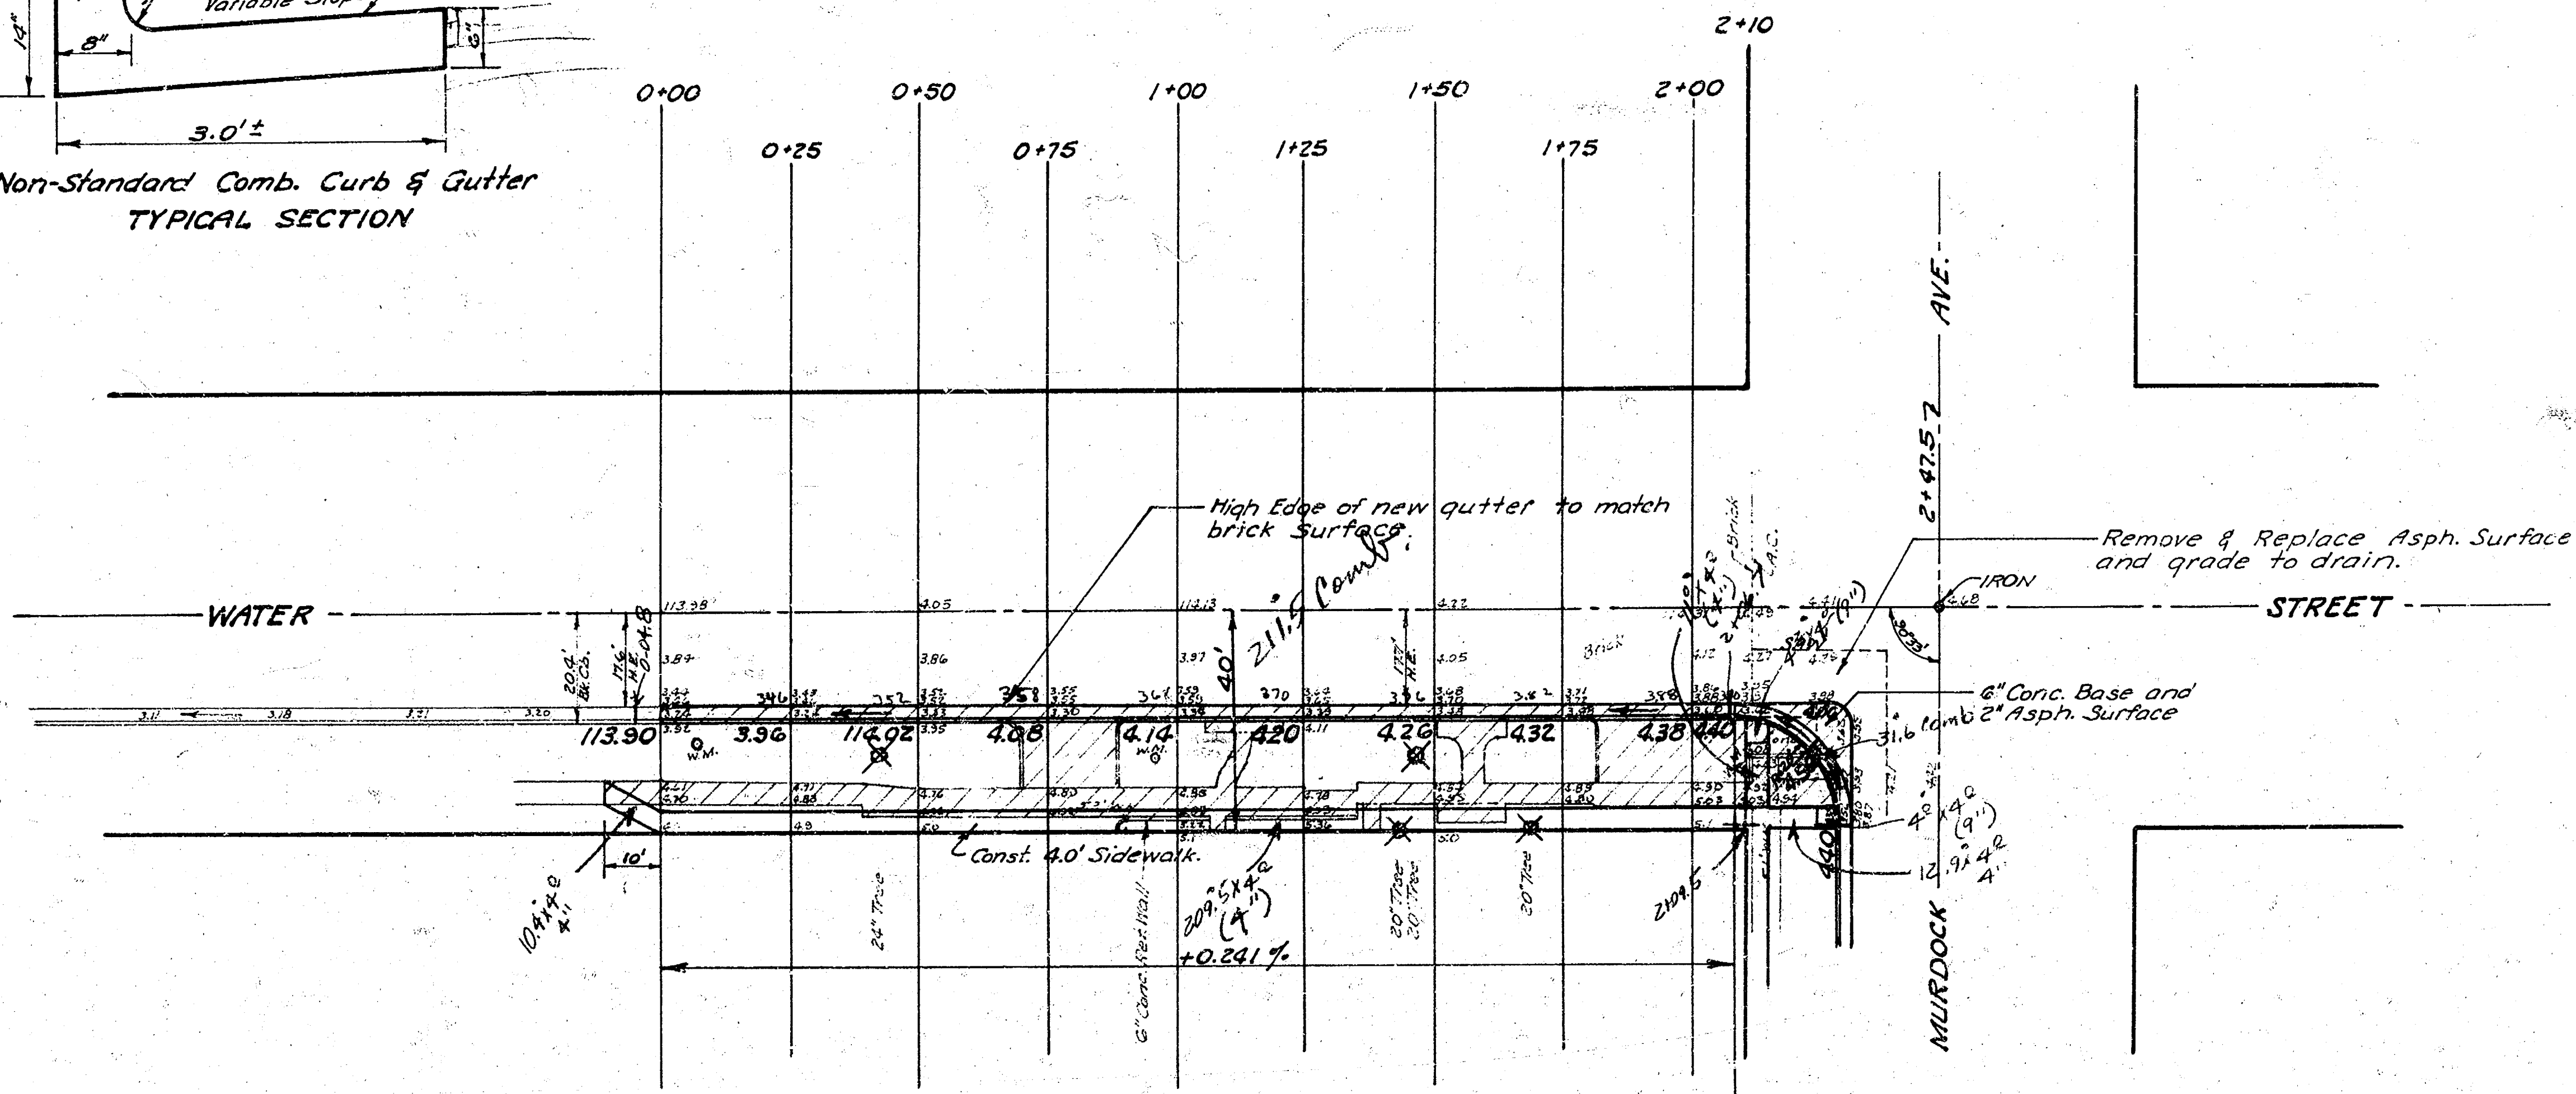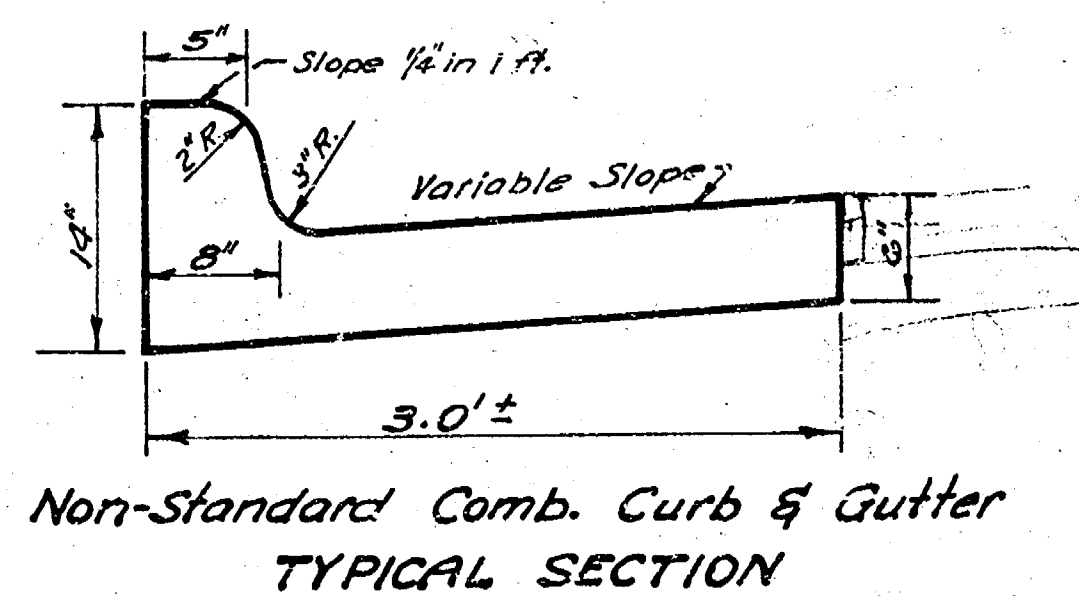

NOTE:
Remove 4 Large Trees

NOTE:
The cost for all excavation & comp. fill necessary to
complete this work shall be considered incidental
to the project.

BHKB502454

FIRE STA. No. 1 SITE IMPROVEMENTS
City of Wichita
THE URBAN RENEWAL AGENCY
OF THE WICHITA KANSAS
METROPOLITAN AREA
KENNETH H. KITCHEN EXECUTIVE DIRECTOR
R.W. LINN CITY ENGINEER
Date: _____

