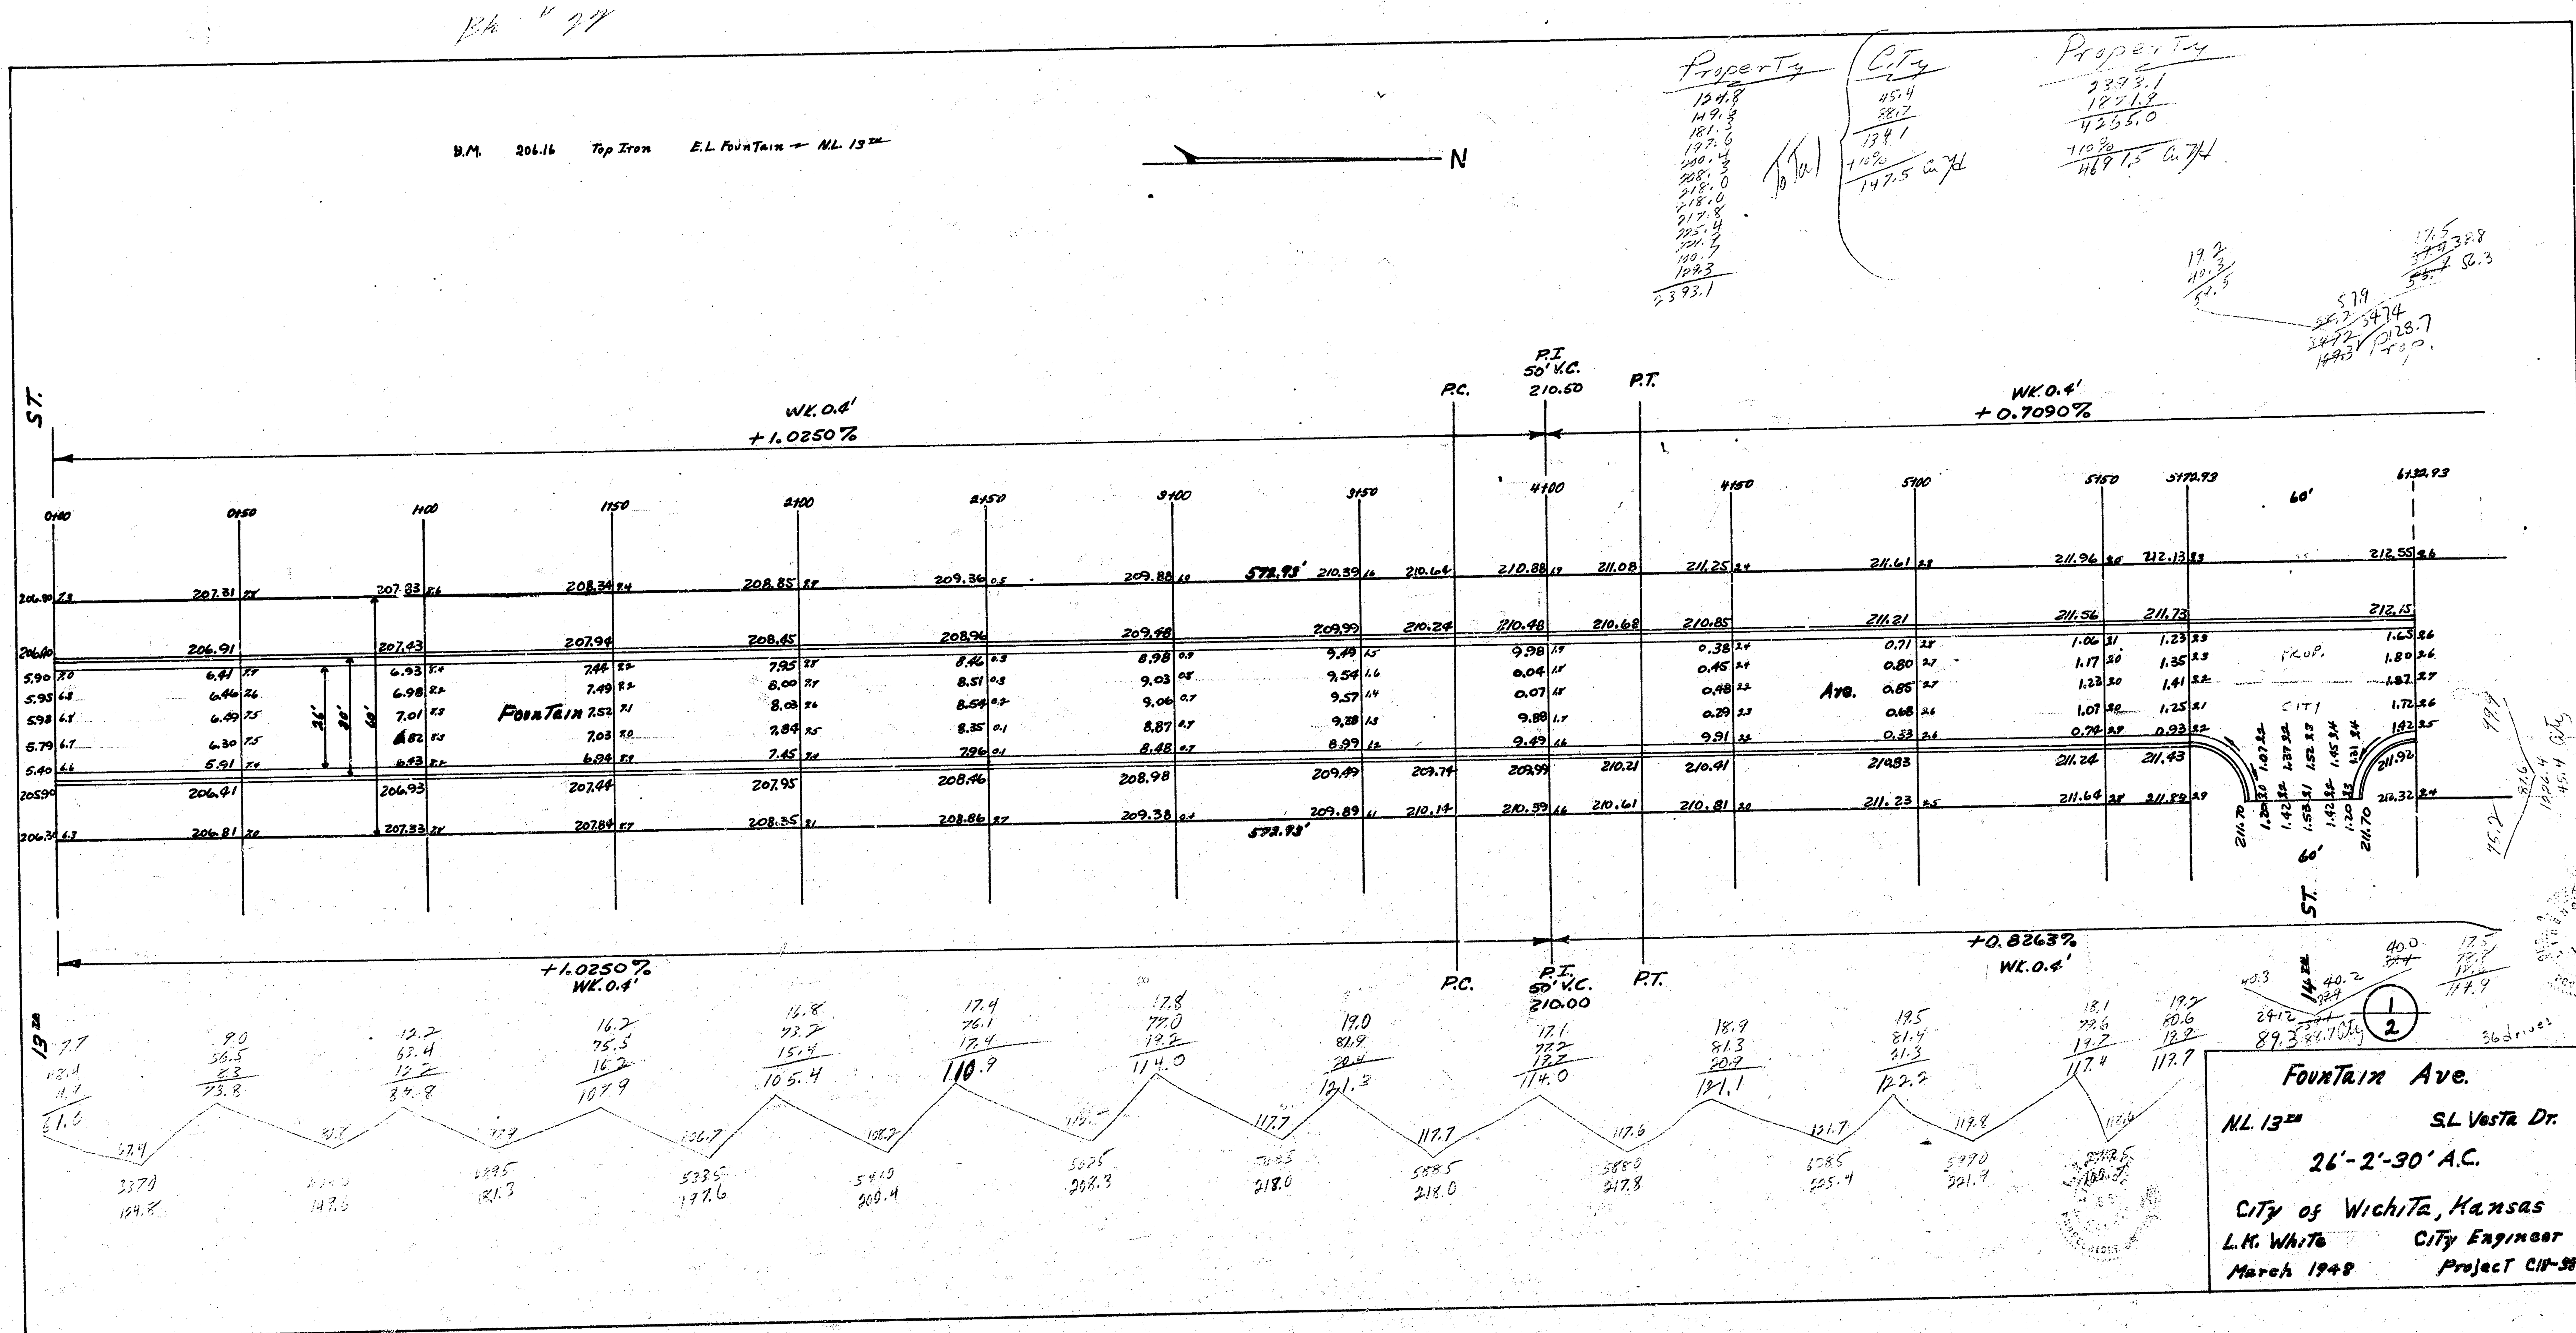

Fountain Ave.

N.L. 13th S.L Vesta Dr.

26'-2'-30' A.C.

City of Wichita, Kansas

L.K. White City Engineer

March 1948 Project C18-38

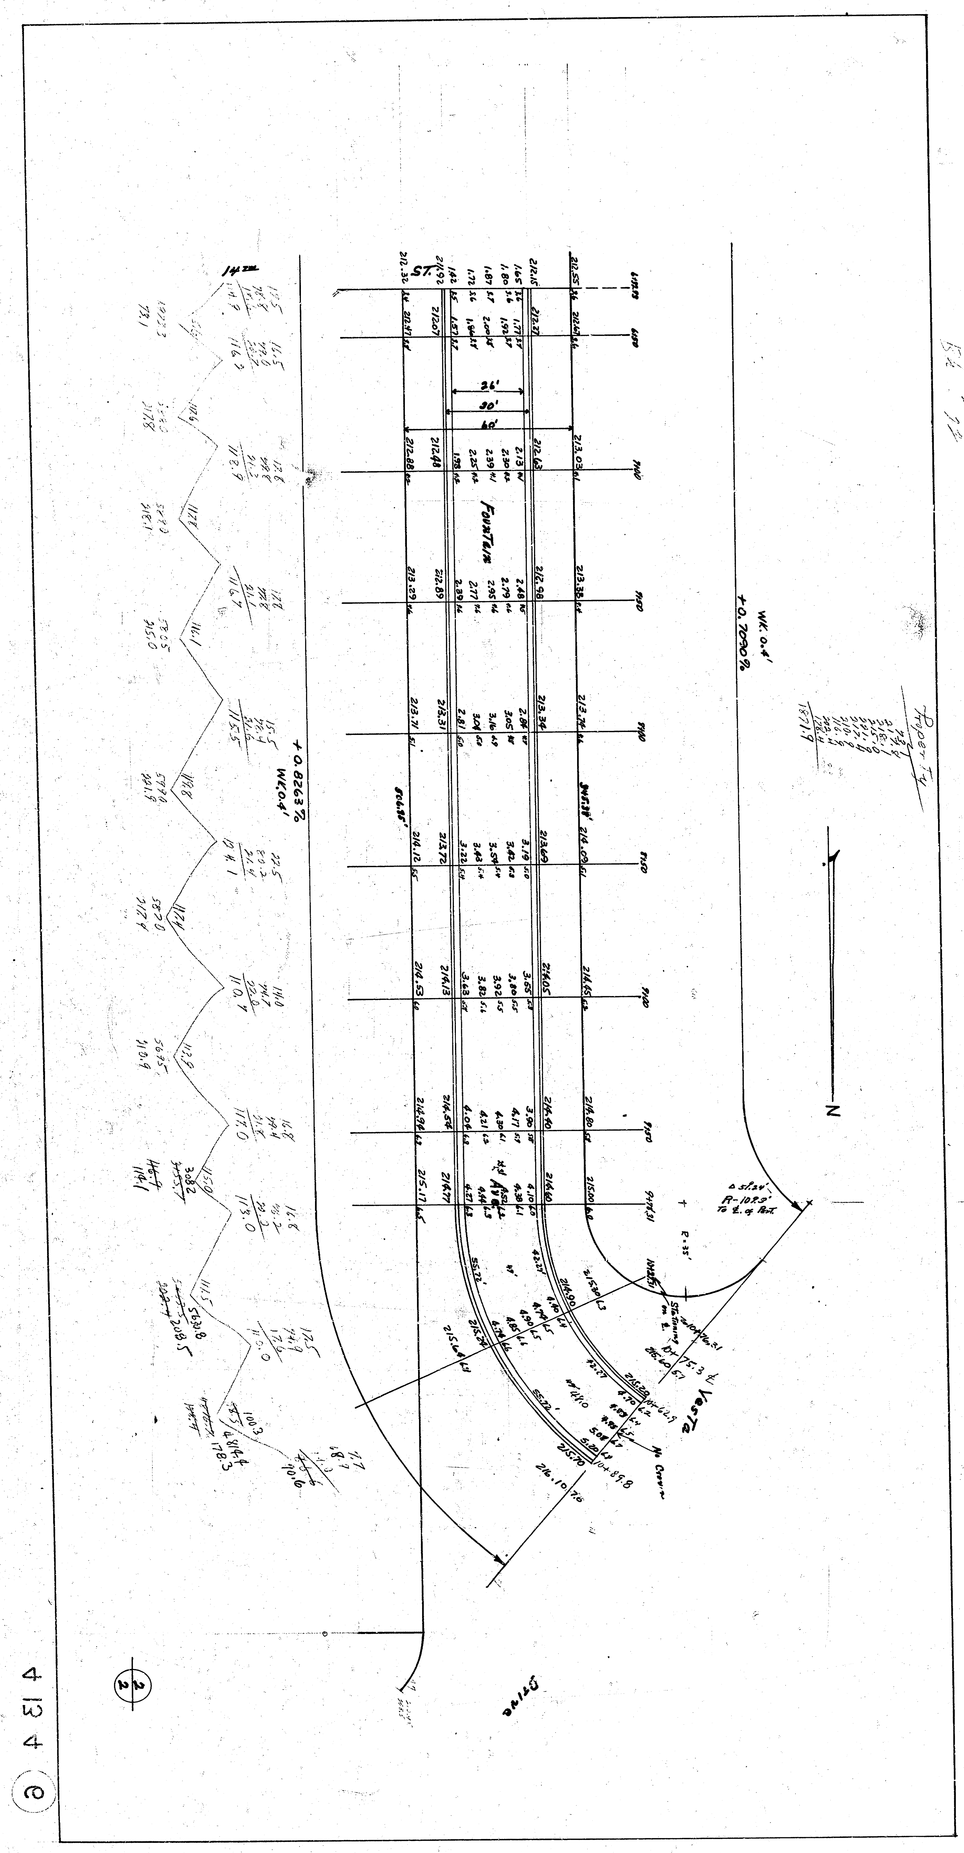

4134 (6)