Bk. 52 Y'

Property Excavation

Property	City
21.1	92.5
86.7	19.7
84.9	3.0
88.4	15.9
119.8	7.0
111.5	13.8
512.4	

+10% 512.4
51.2
Total 563.6 cu yds.

City — 138.L
13.8
151.9 cu yds.

BM 104.25 "M" in Mueller Fireplug west side Geo. Washington Dr. @ Sennet.

NOTE: Properly pays for all of 26' slab. City pays for intersection.

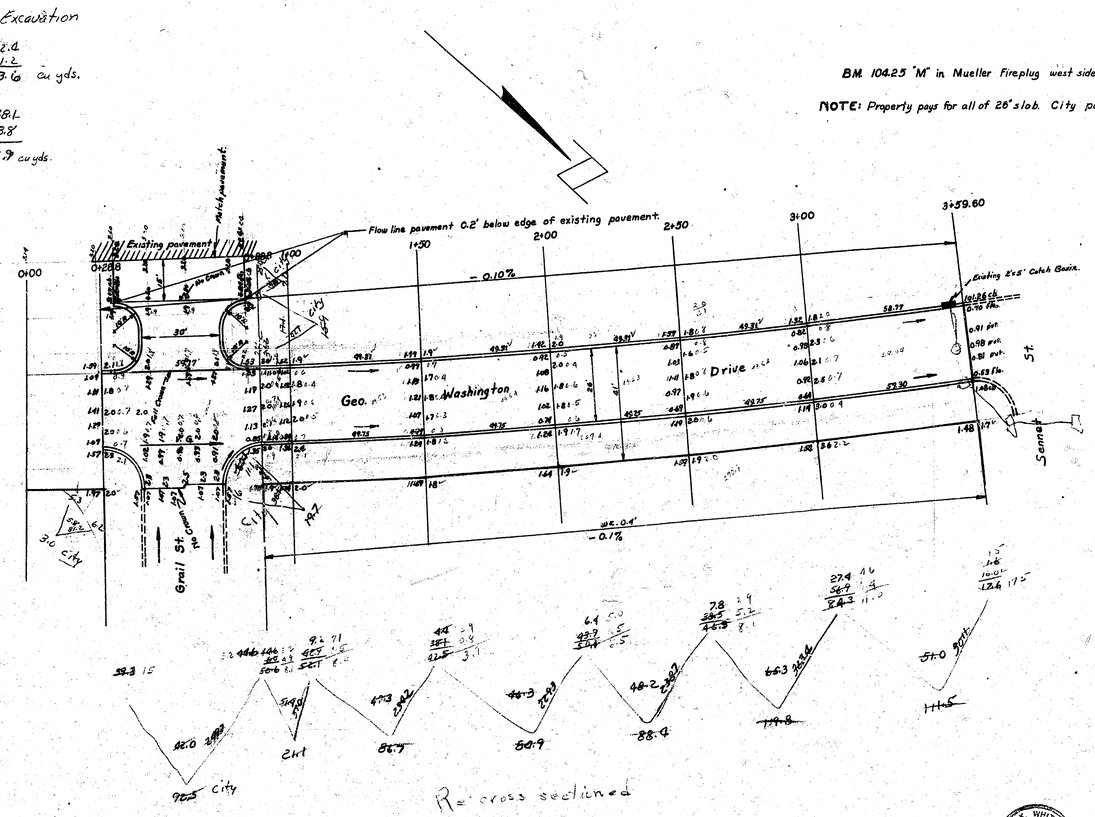

GEO. WASHINGTON DRIVE
SL. Grail St. to SL. Sennet St.
26' Conc. & Cb.

City of Wichita, Kansas
L. K. White City Engineer
January 1951 Proj. No. C10-114.

L. K. WHITE LICENSED 55 KANSAS PROFESSIONAL ENGINEER

S 1 4 (S1)