


B.M. 145.40 End S. Ch. W.L. Clifton S. Side Morris


Prop. Fill	Prop. Exc.	City Fill	City Exc.
20.2	31.1	20.4	10.1
12.0	21.7	20.4	10.1
63.7	7.0	22.4	11.1
99.8	30.2		
87.4	7.4		
38.1	15.7		
20.3			
341.5	131.1		
1106.6	144.2		
3757 cu. yd.			

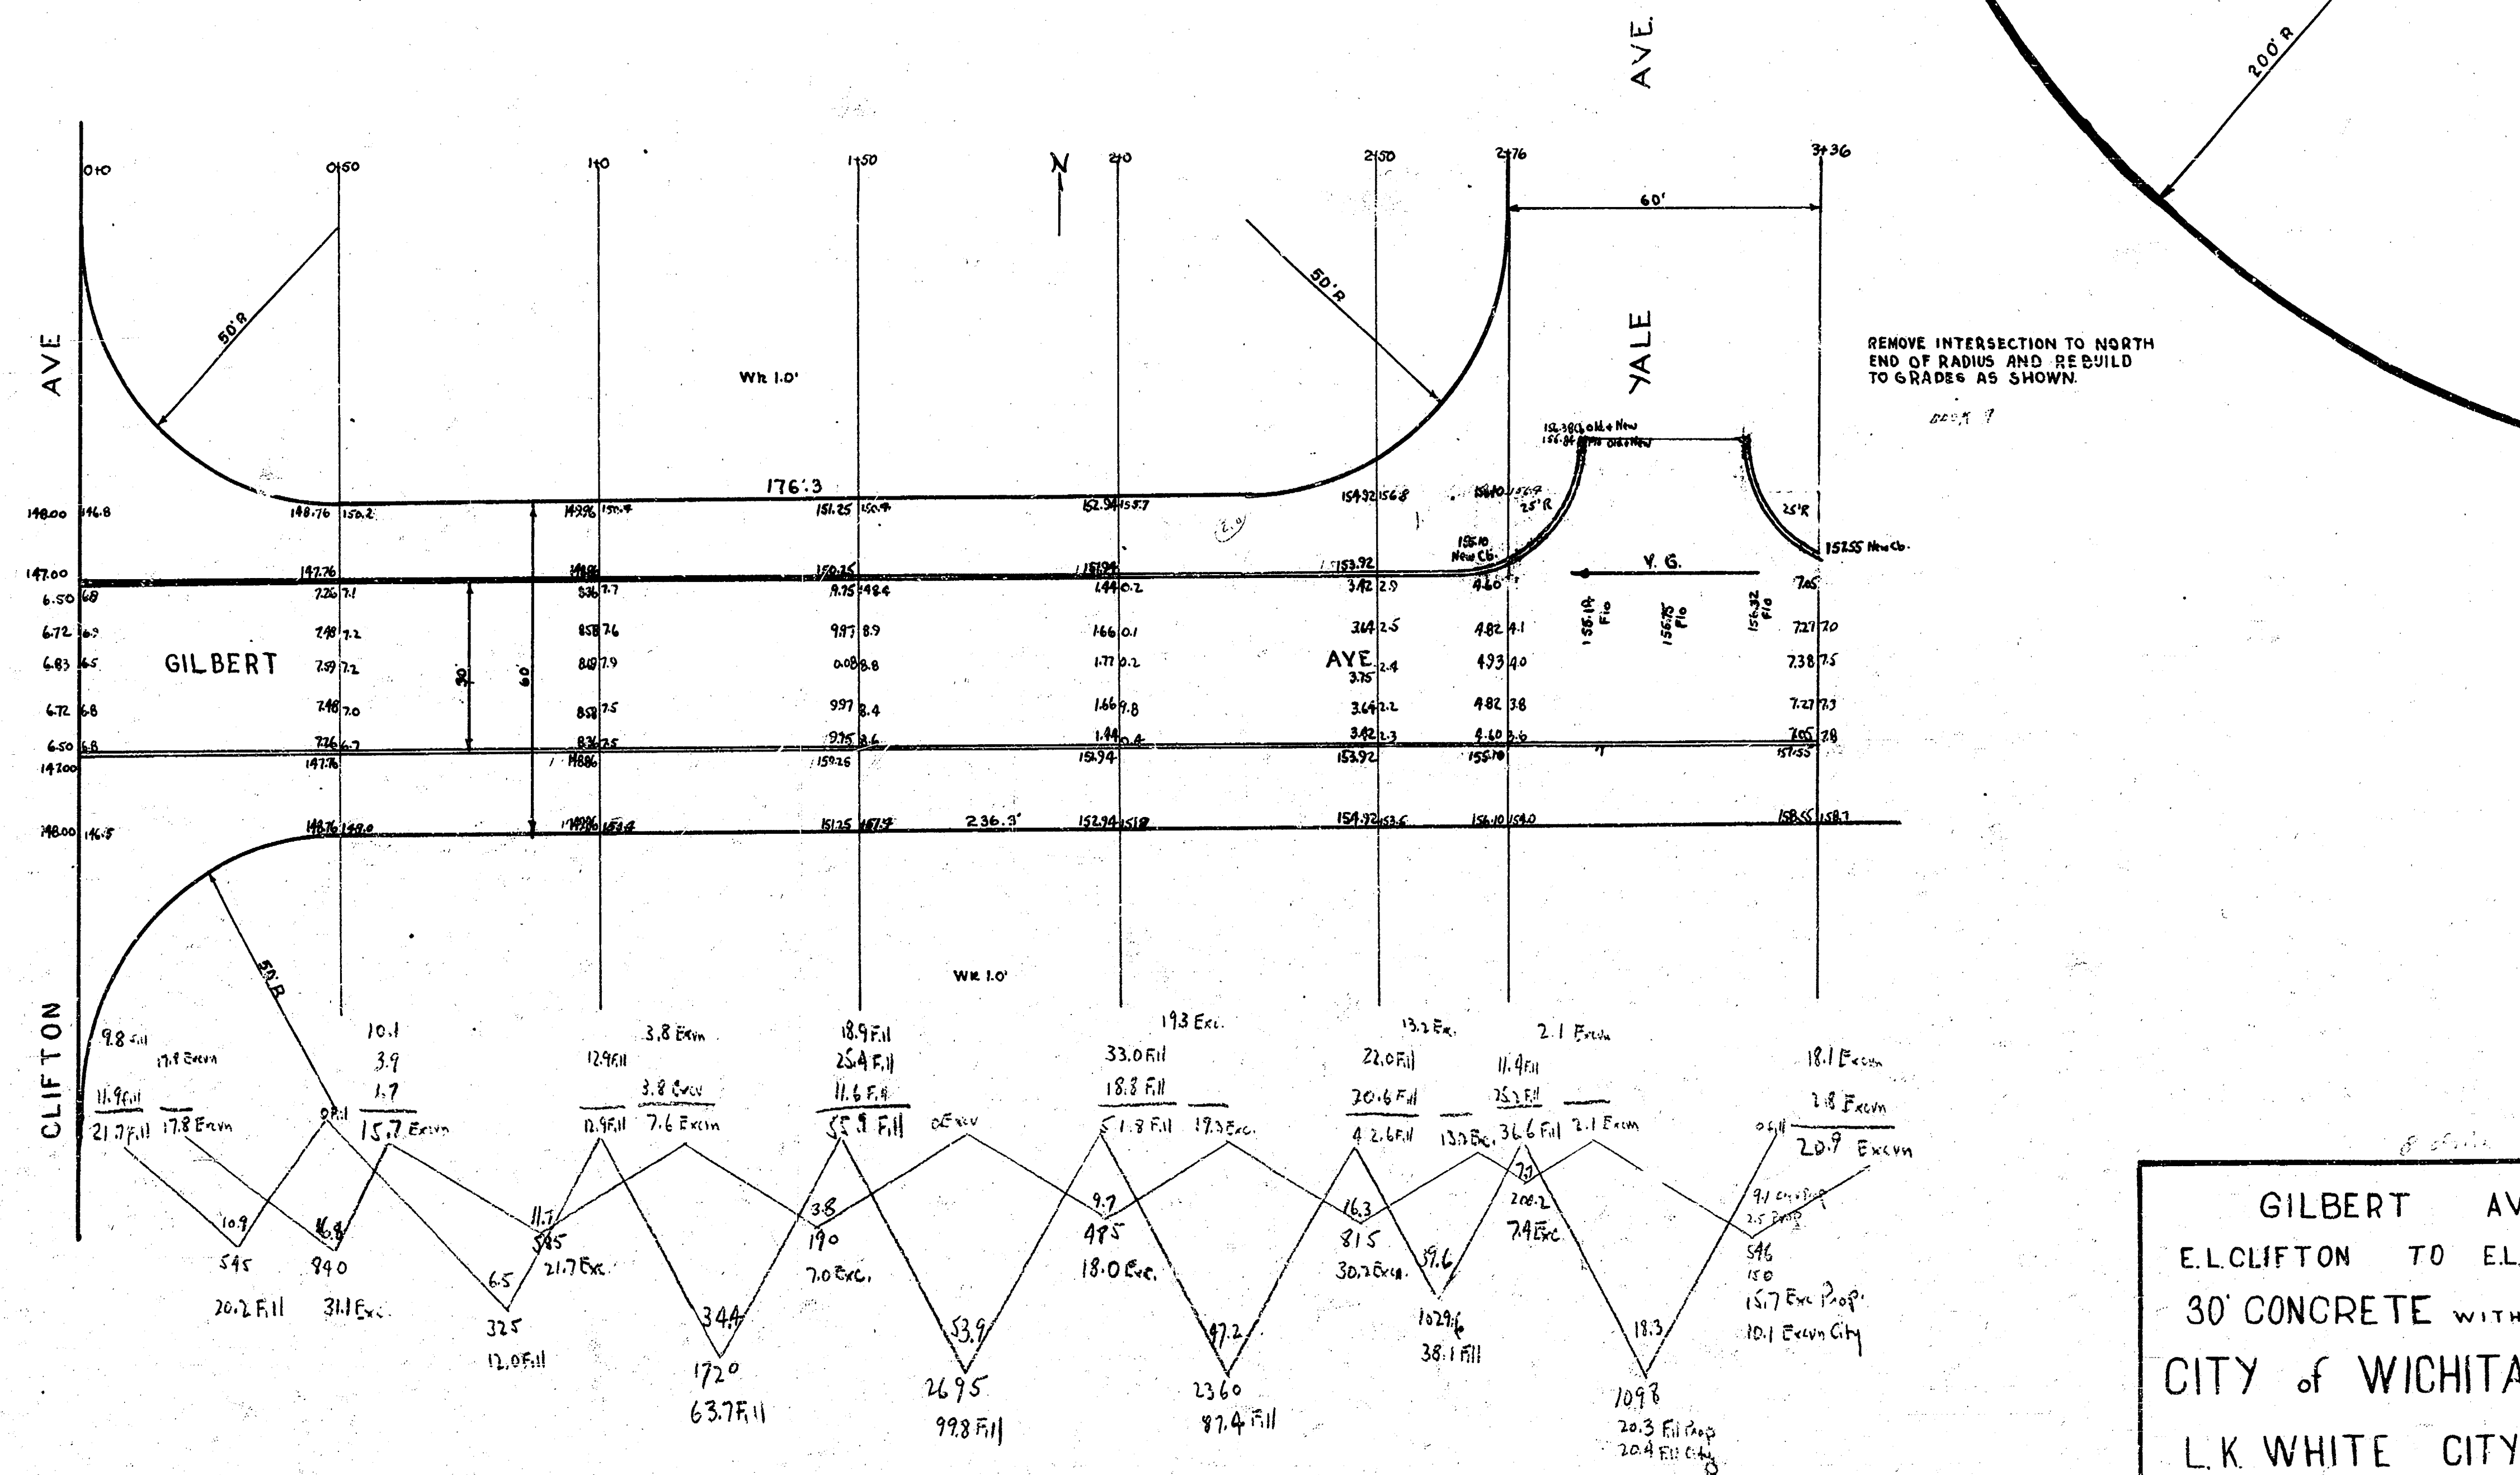

GILBERT AVE.
 EL. CLIFTON TO EL. YALE
 30' CONCRETE WITH INTEGRAL CB
 CITY OF WICHITA, KANS.
 L. K. WHITE CITY ENGINEER
 NOV 1946

B.M. 145.40' End S. Ch. W.L. Clifton & Side Morris

Prop. Fill	Prop. Exc.	C.A. Fill	C.A. Exc.
25.6	51.1	20.4	10.1
12.0	21.7	20.4	10.1
63.7	7.0	7.0	7.0
99.8	18.6	12.4	11.1
87.4	30.2		
38.1	7.4		
20.3	15.7		
34.5	18.1		
40.6	16.4		
375.7	144.2		

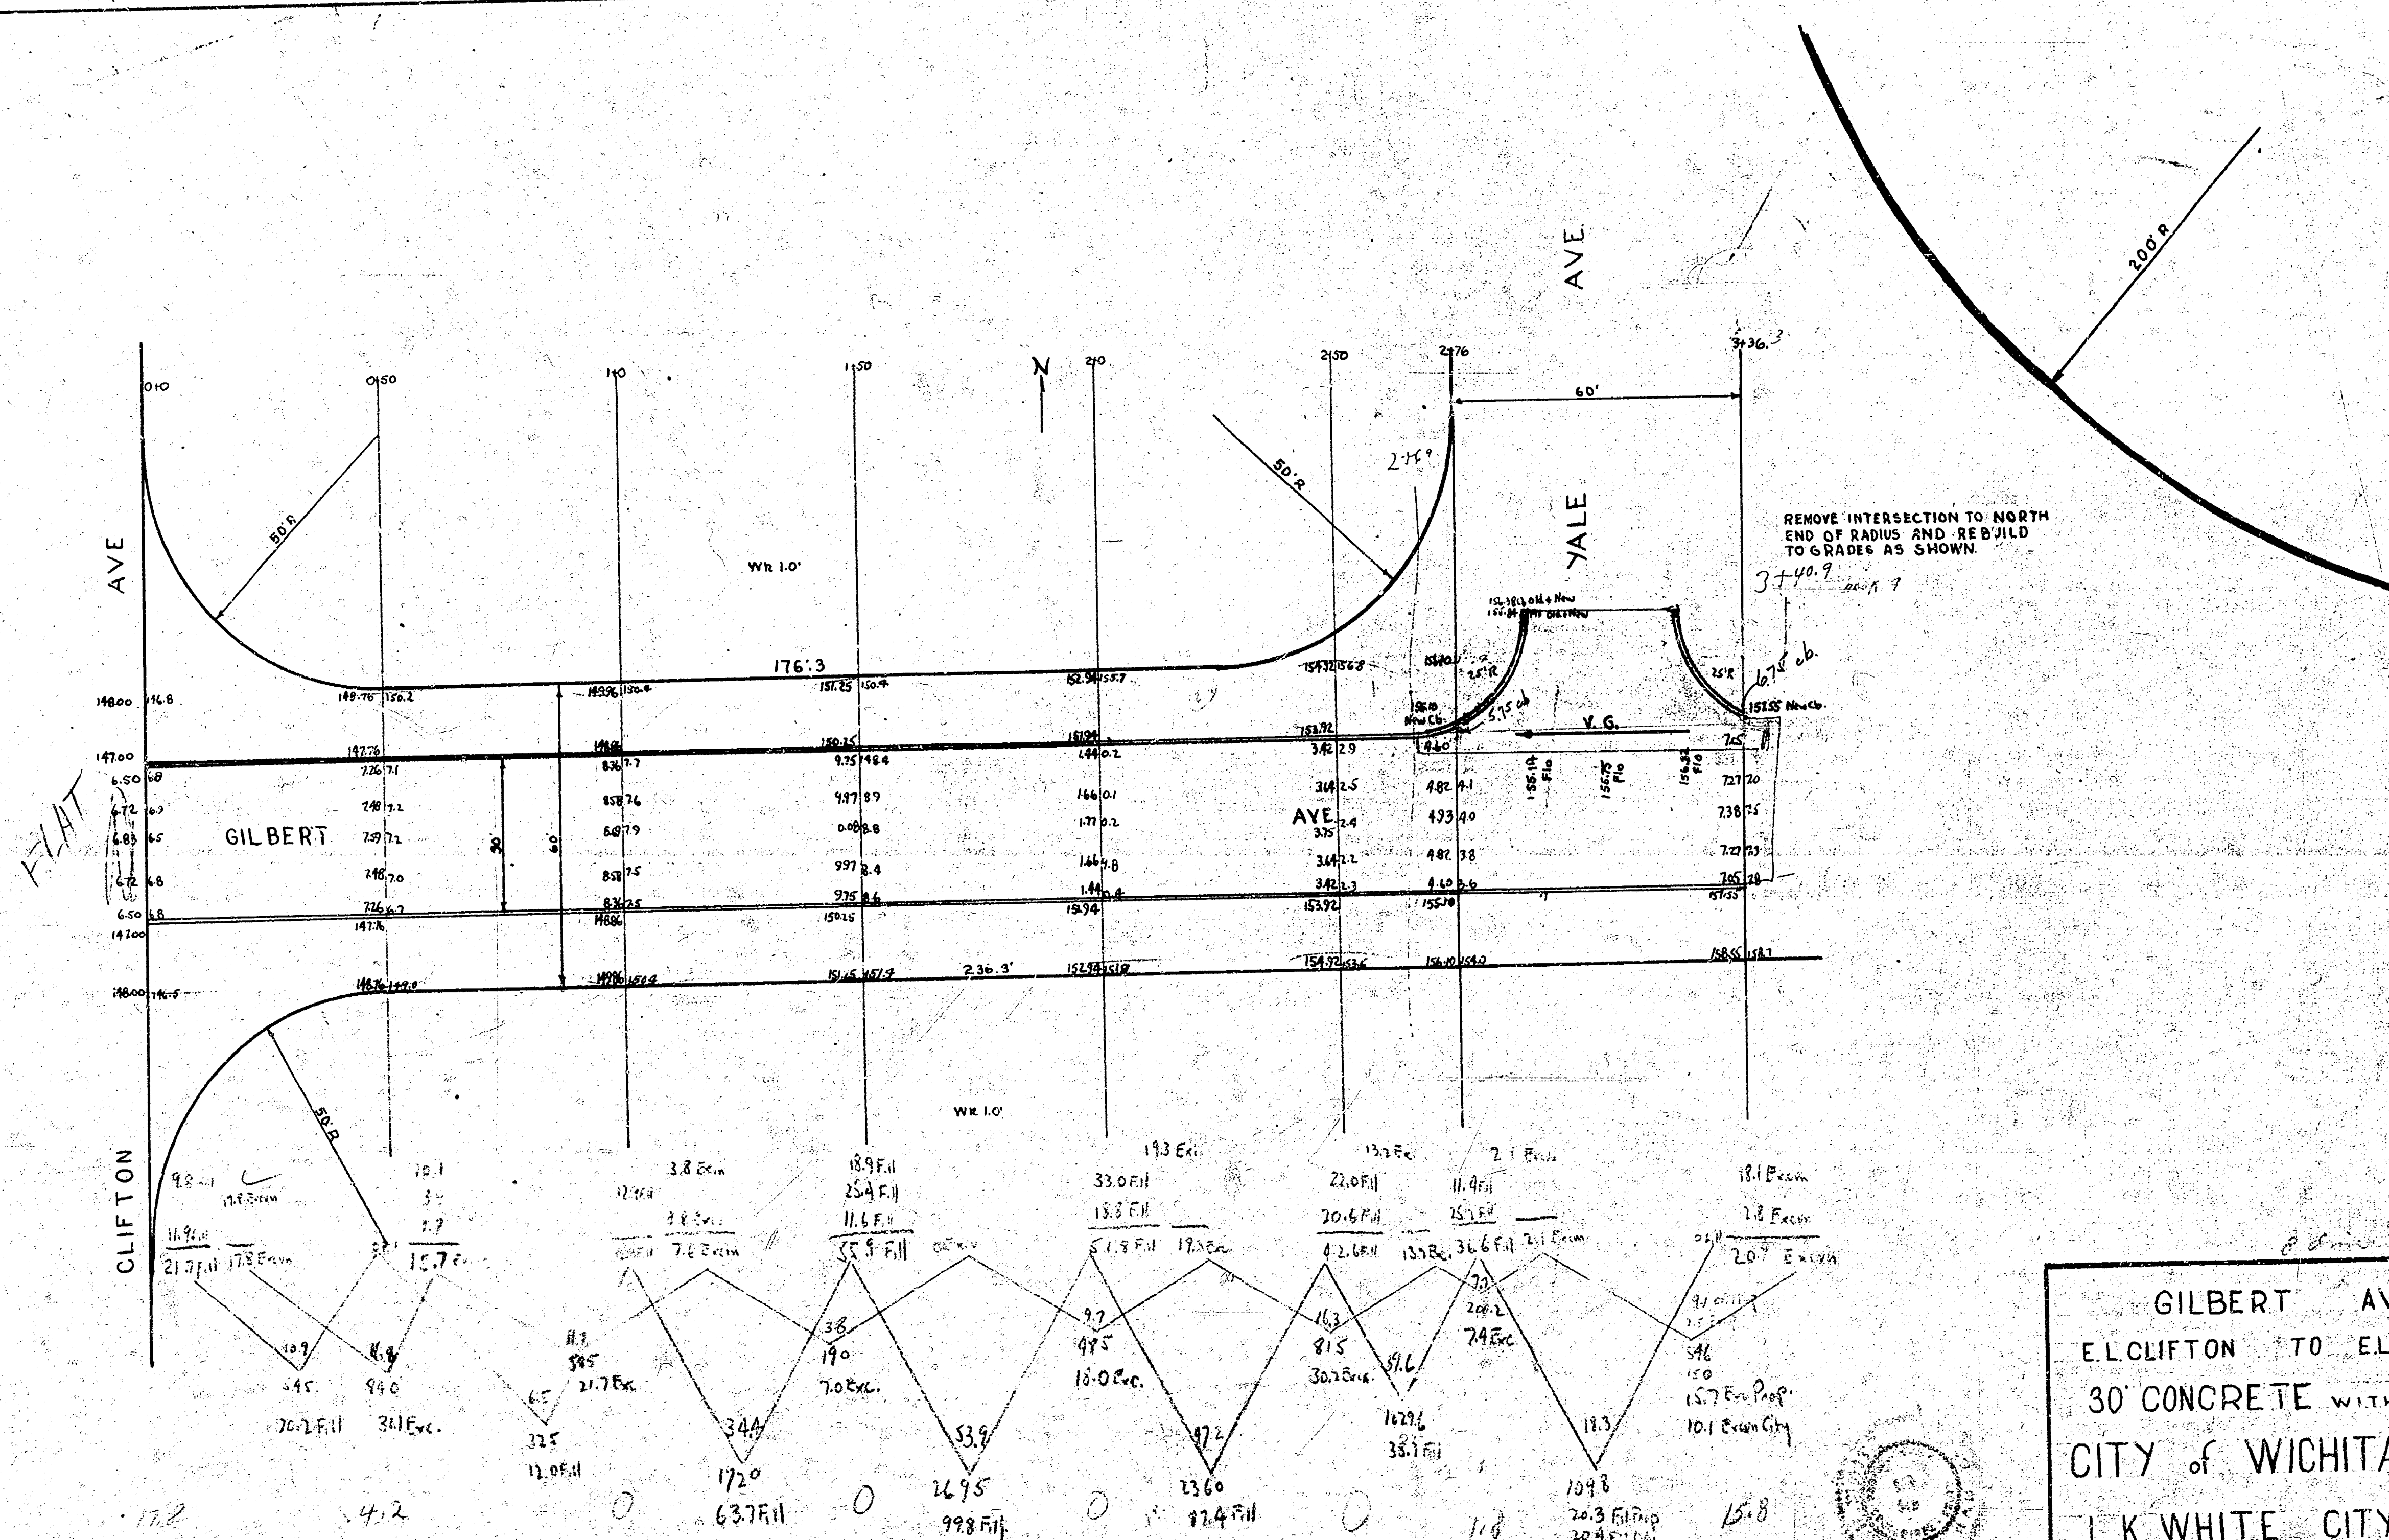

GILBERT AVE
EL CLIFTON TO EL YALE
30' CONCRETE WITH INTEGRAL CB
CITY OF WICHITA, KANS.
L.K. WHITE CITY ENGINEER
NOV 1946