



184

NOTE: STAKES TO BE SET BY THIS ELEVATION ONLY!
BM 162.66 "M" in Mueller F. Hyd. NW Cor. Lightner & Morris

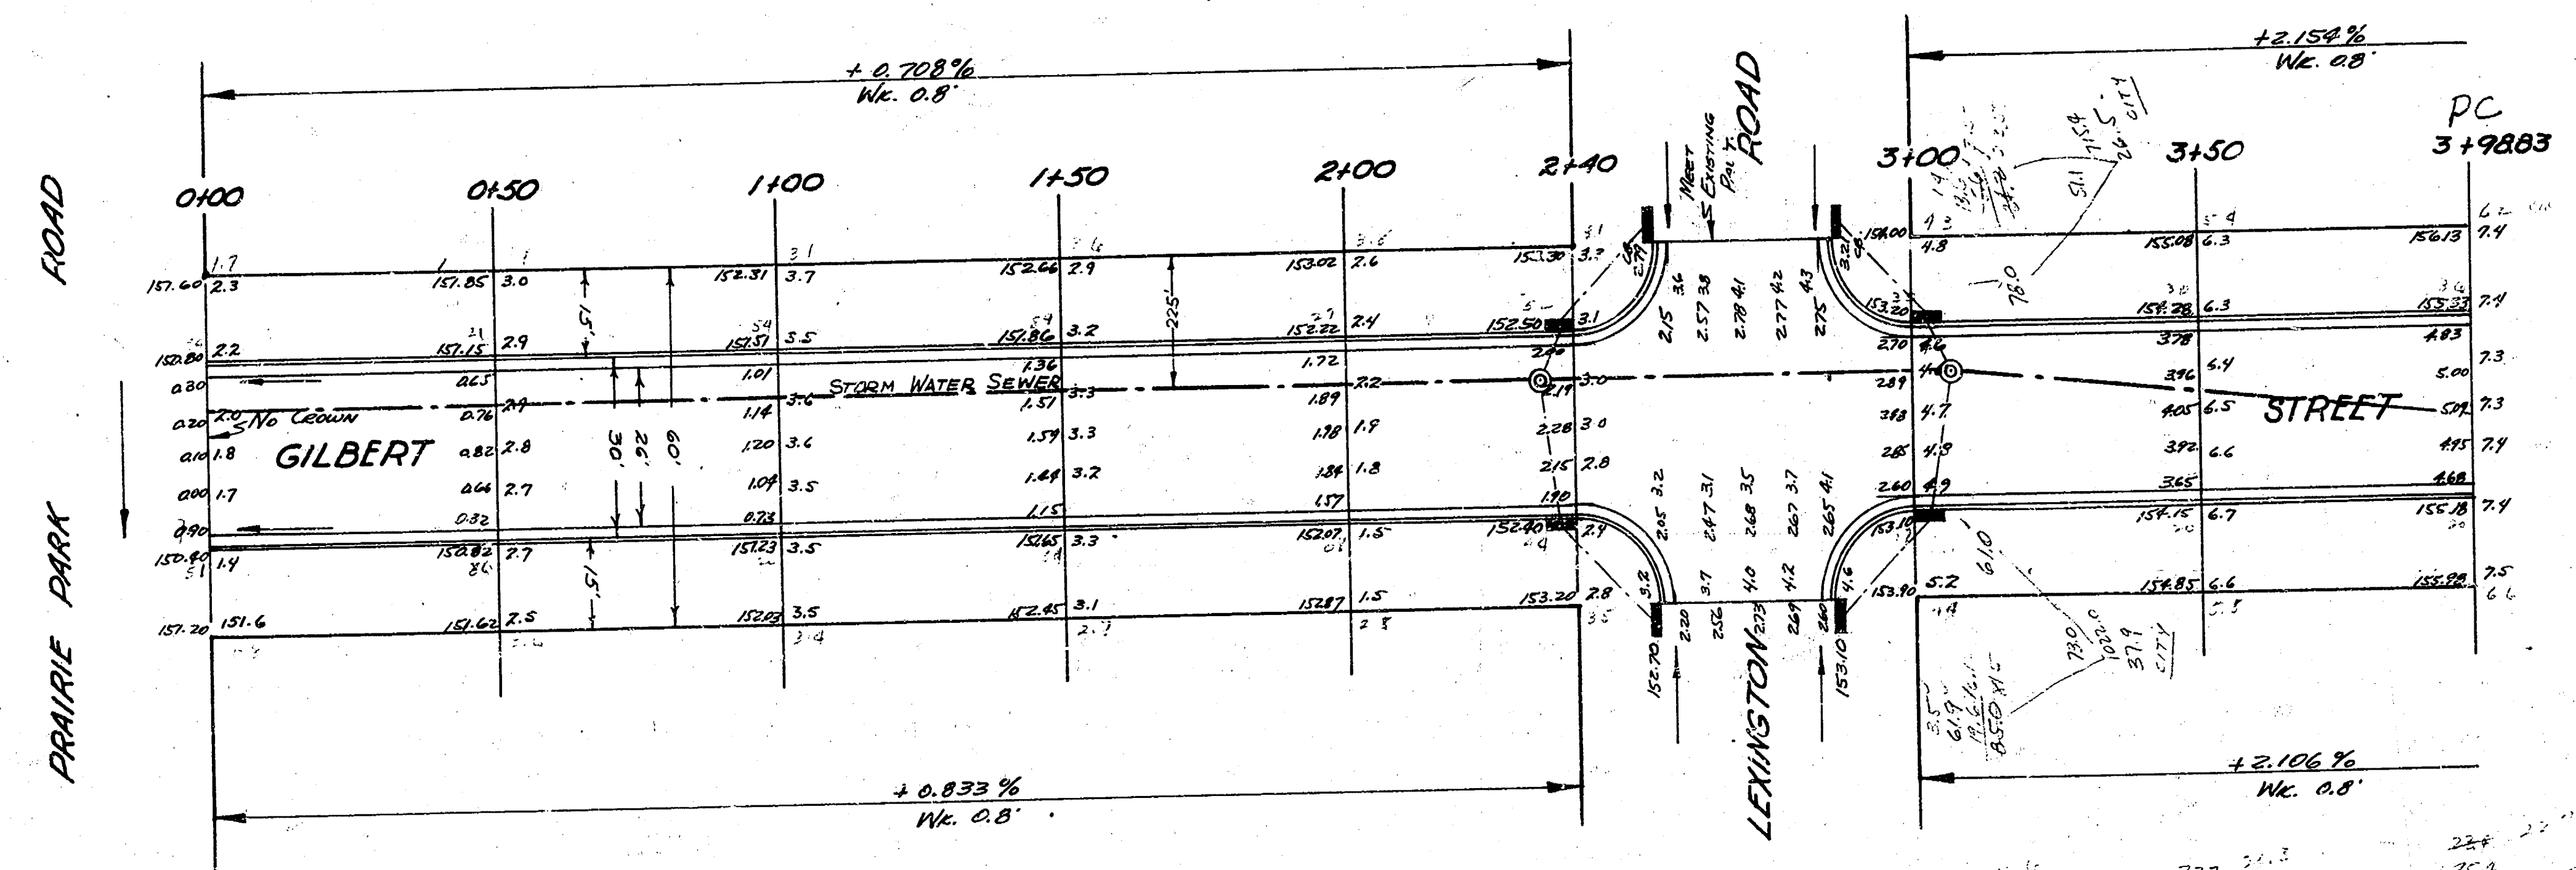


Exc.



Prop.	Exc.

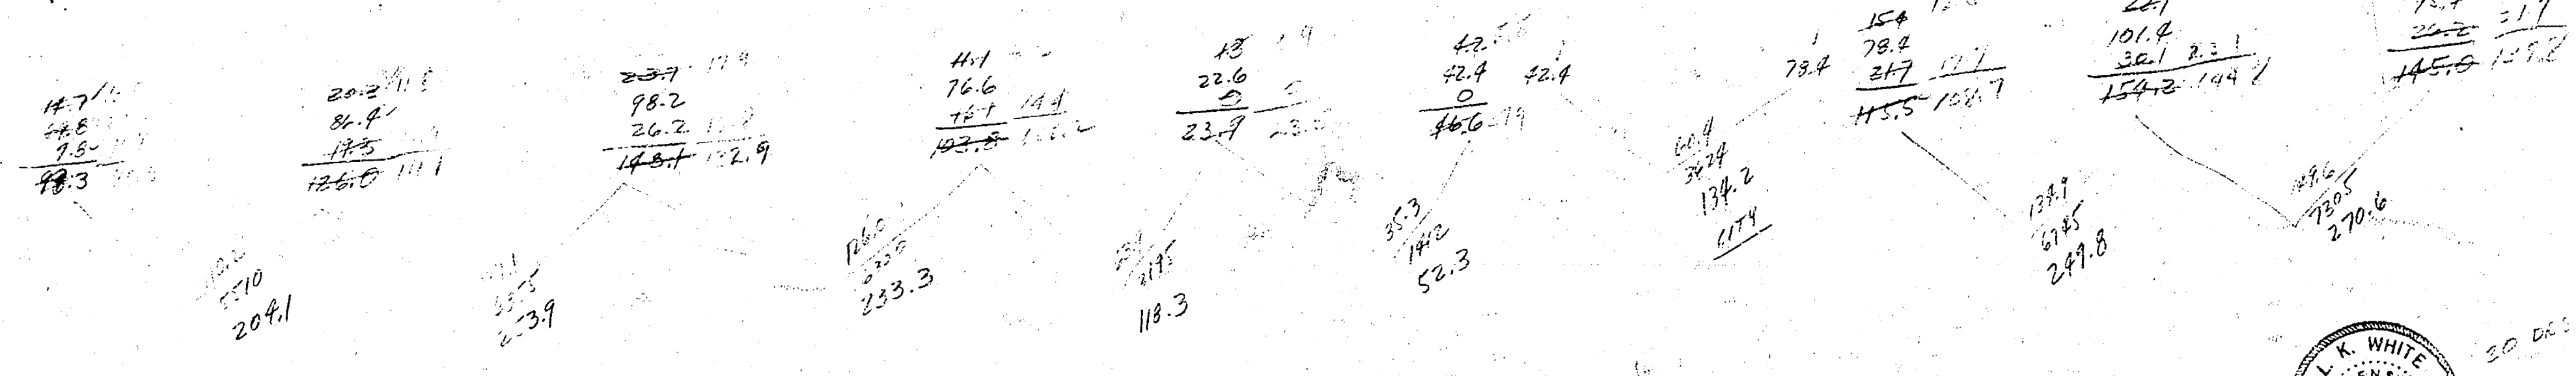

GILBERT STREET
El Prairie Park Rd ~ El Prairie Park Rd
26-2-30 AC
City of Wichita Kansas
LK White City Engineer
April, 1951 Proj No C11-40

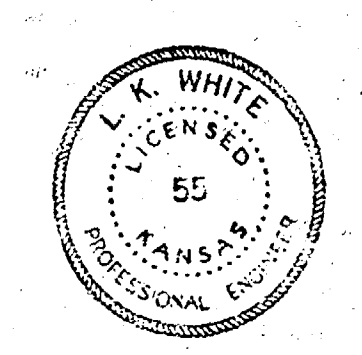

481

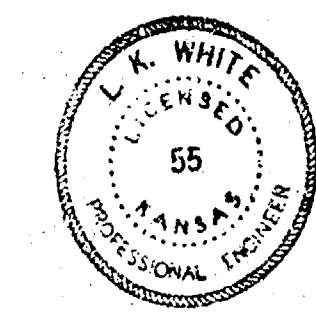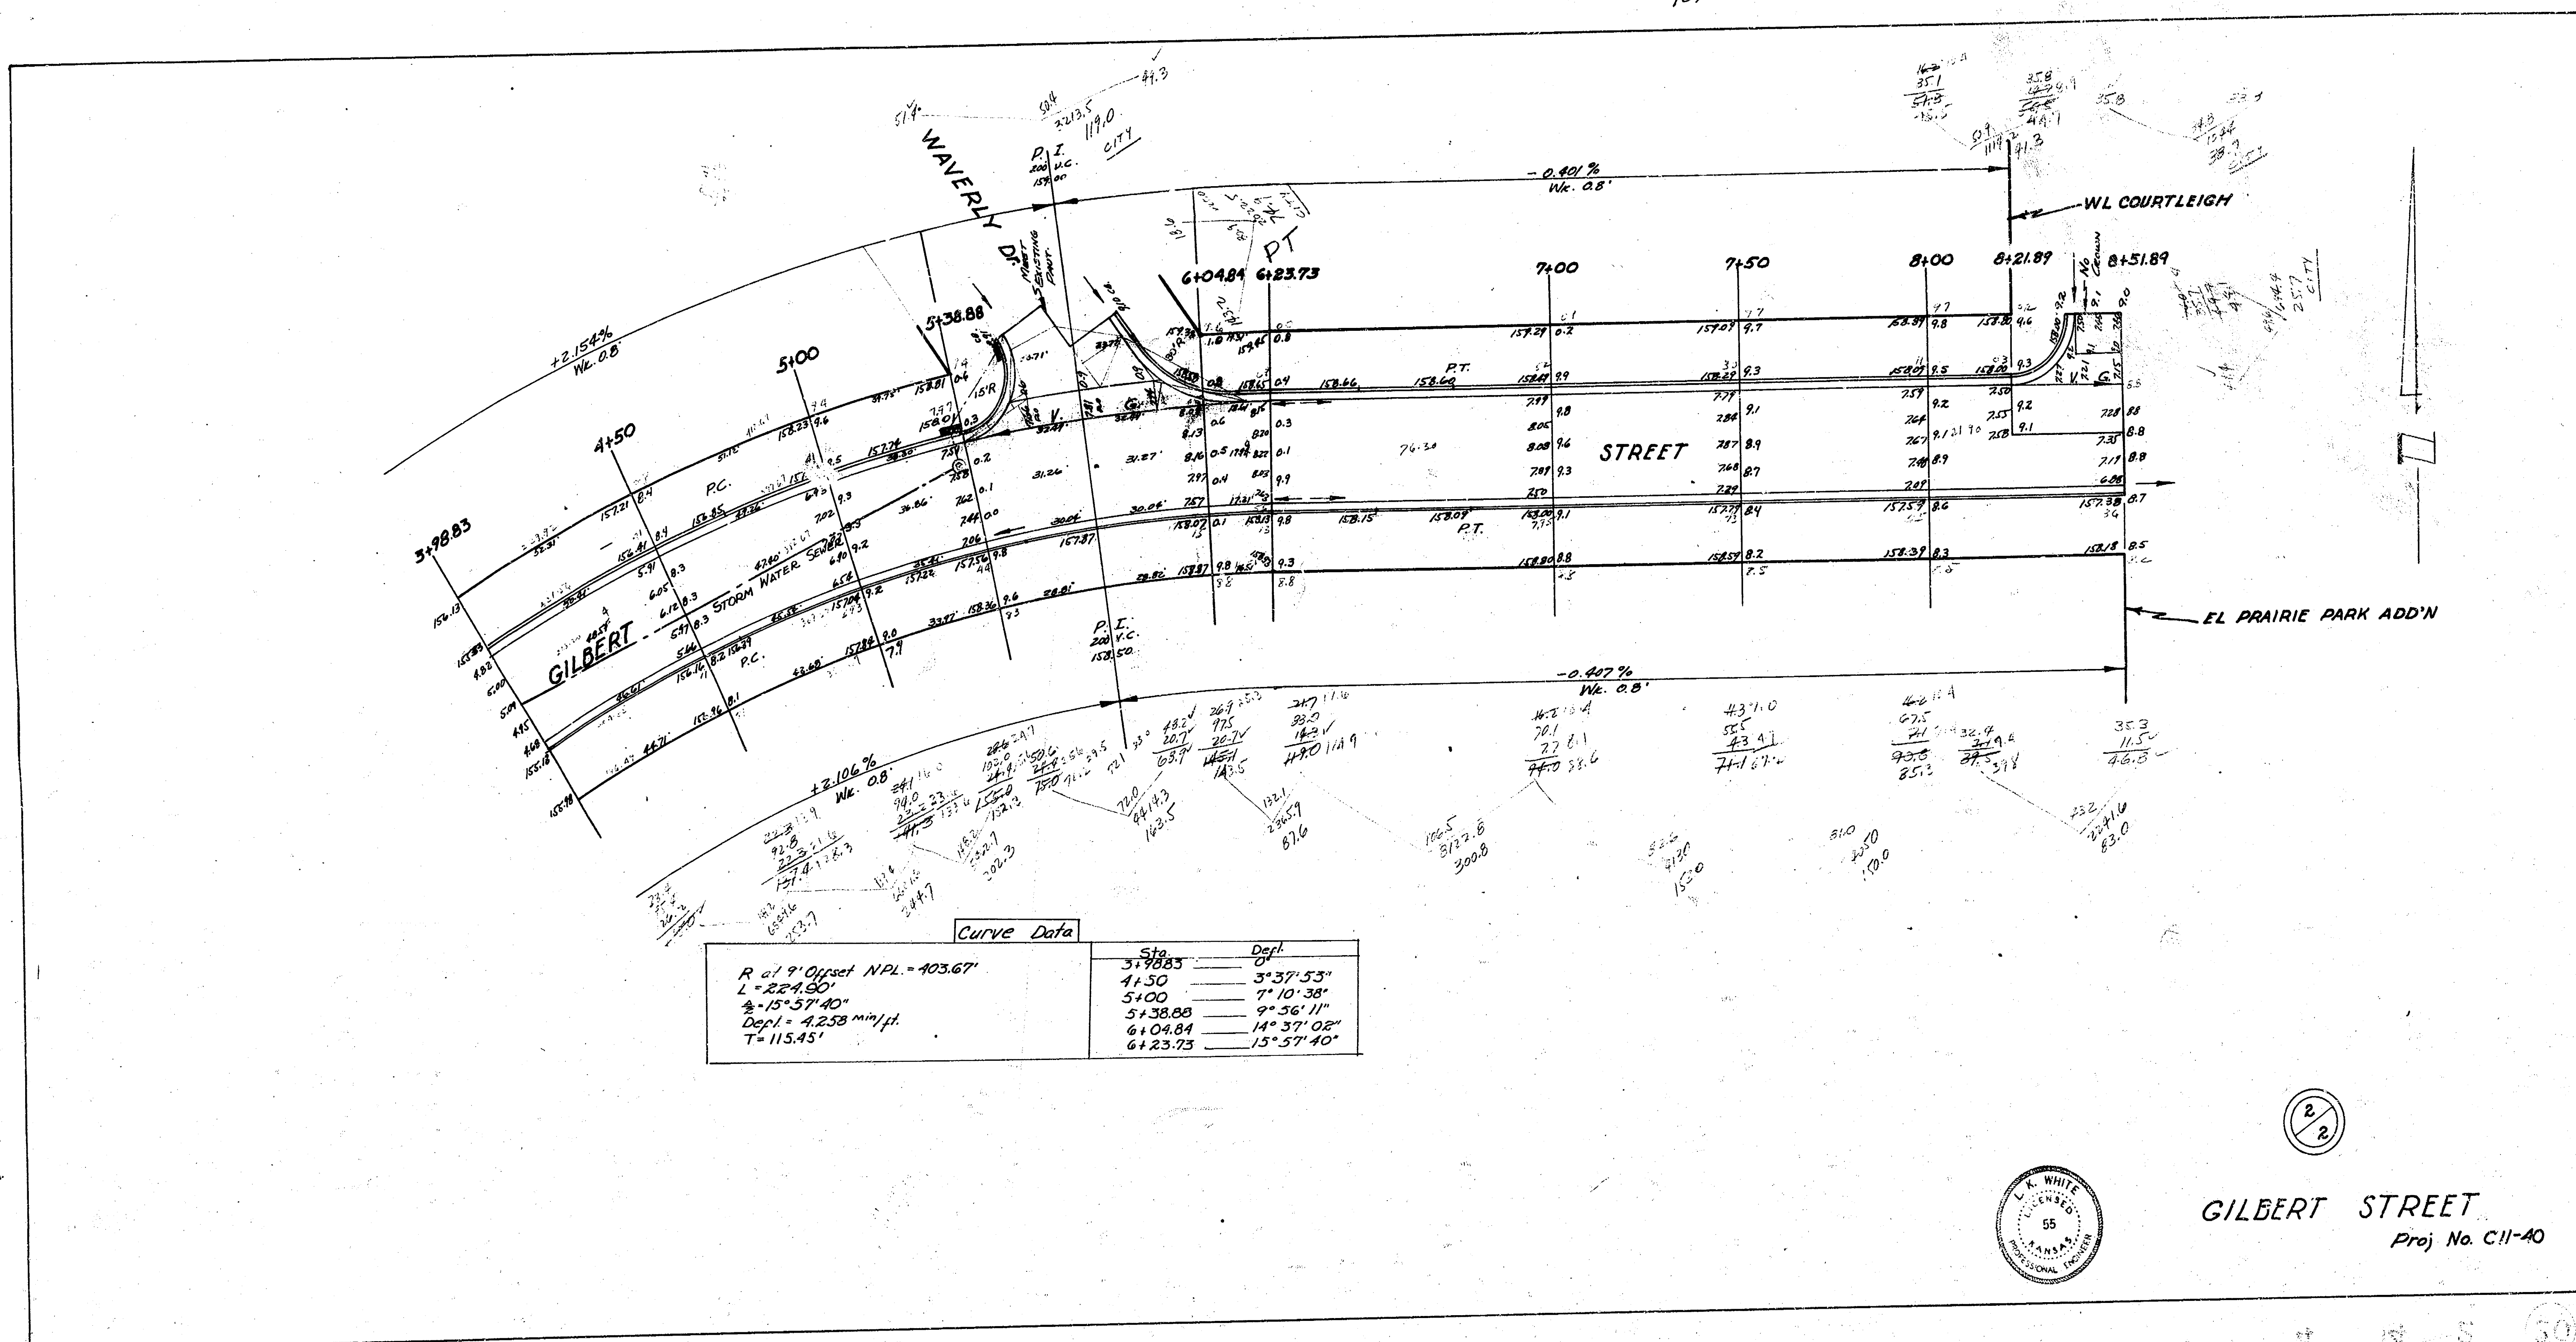

GILBERT STREET
Proj No. C11-40

2
2

4 12 5 50