




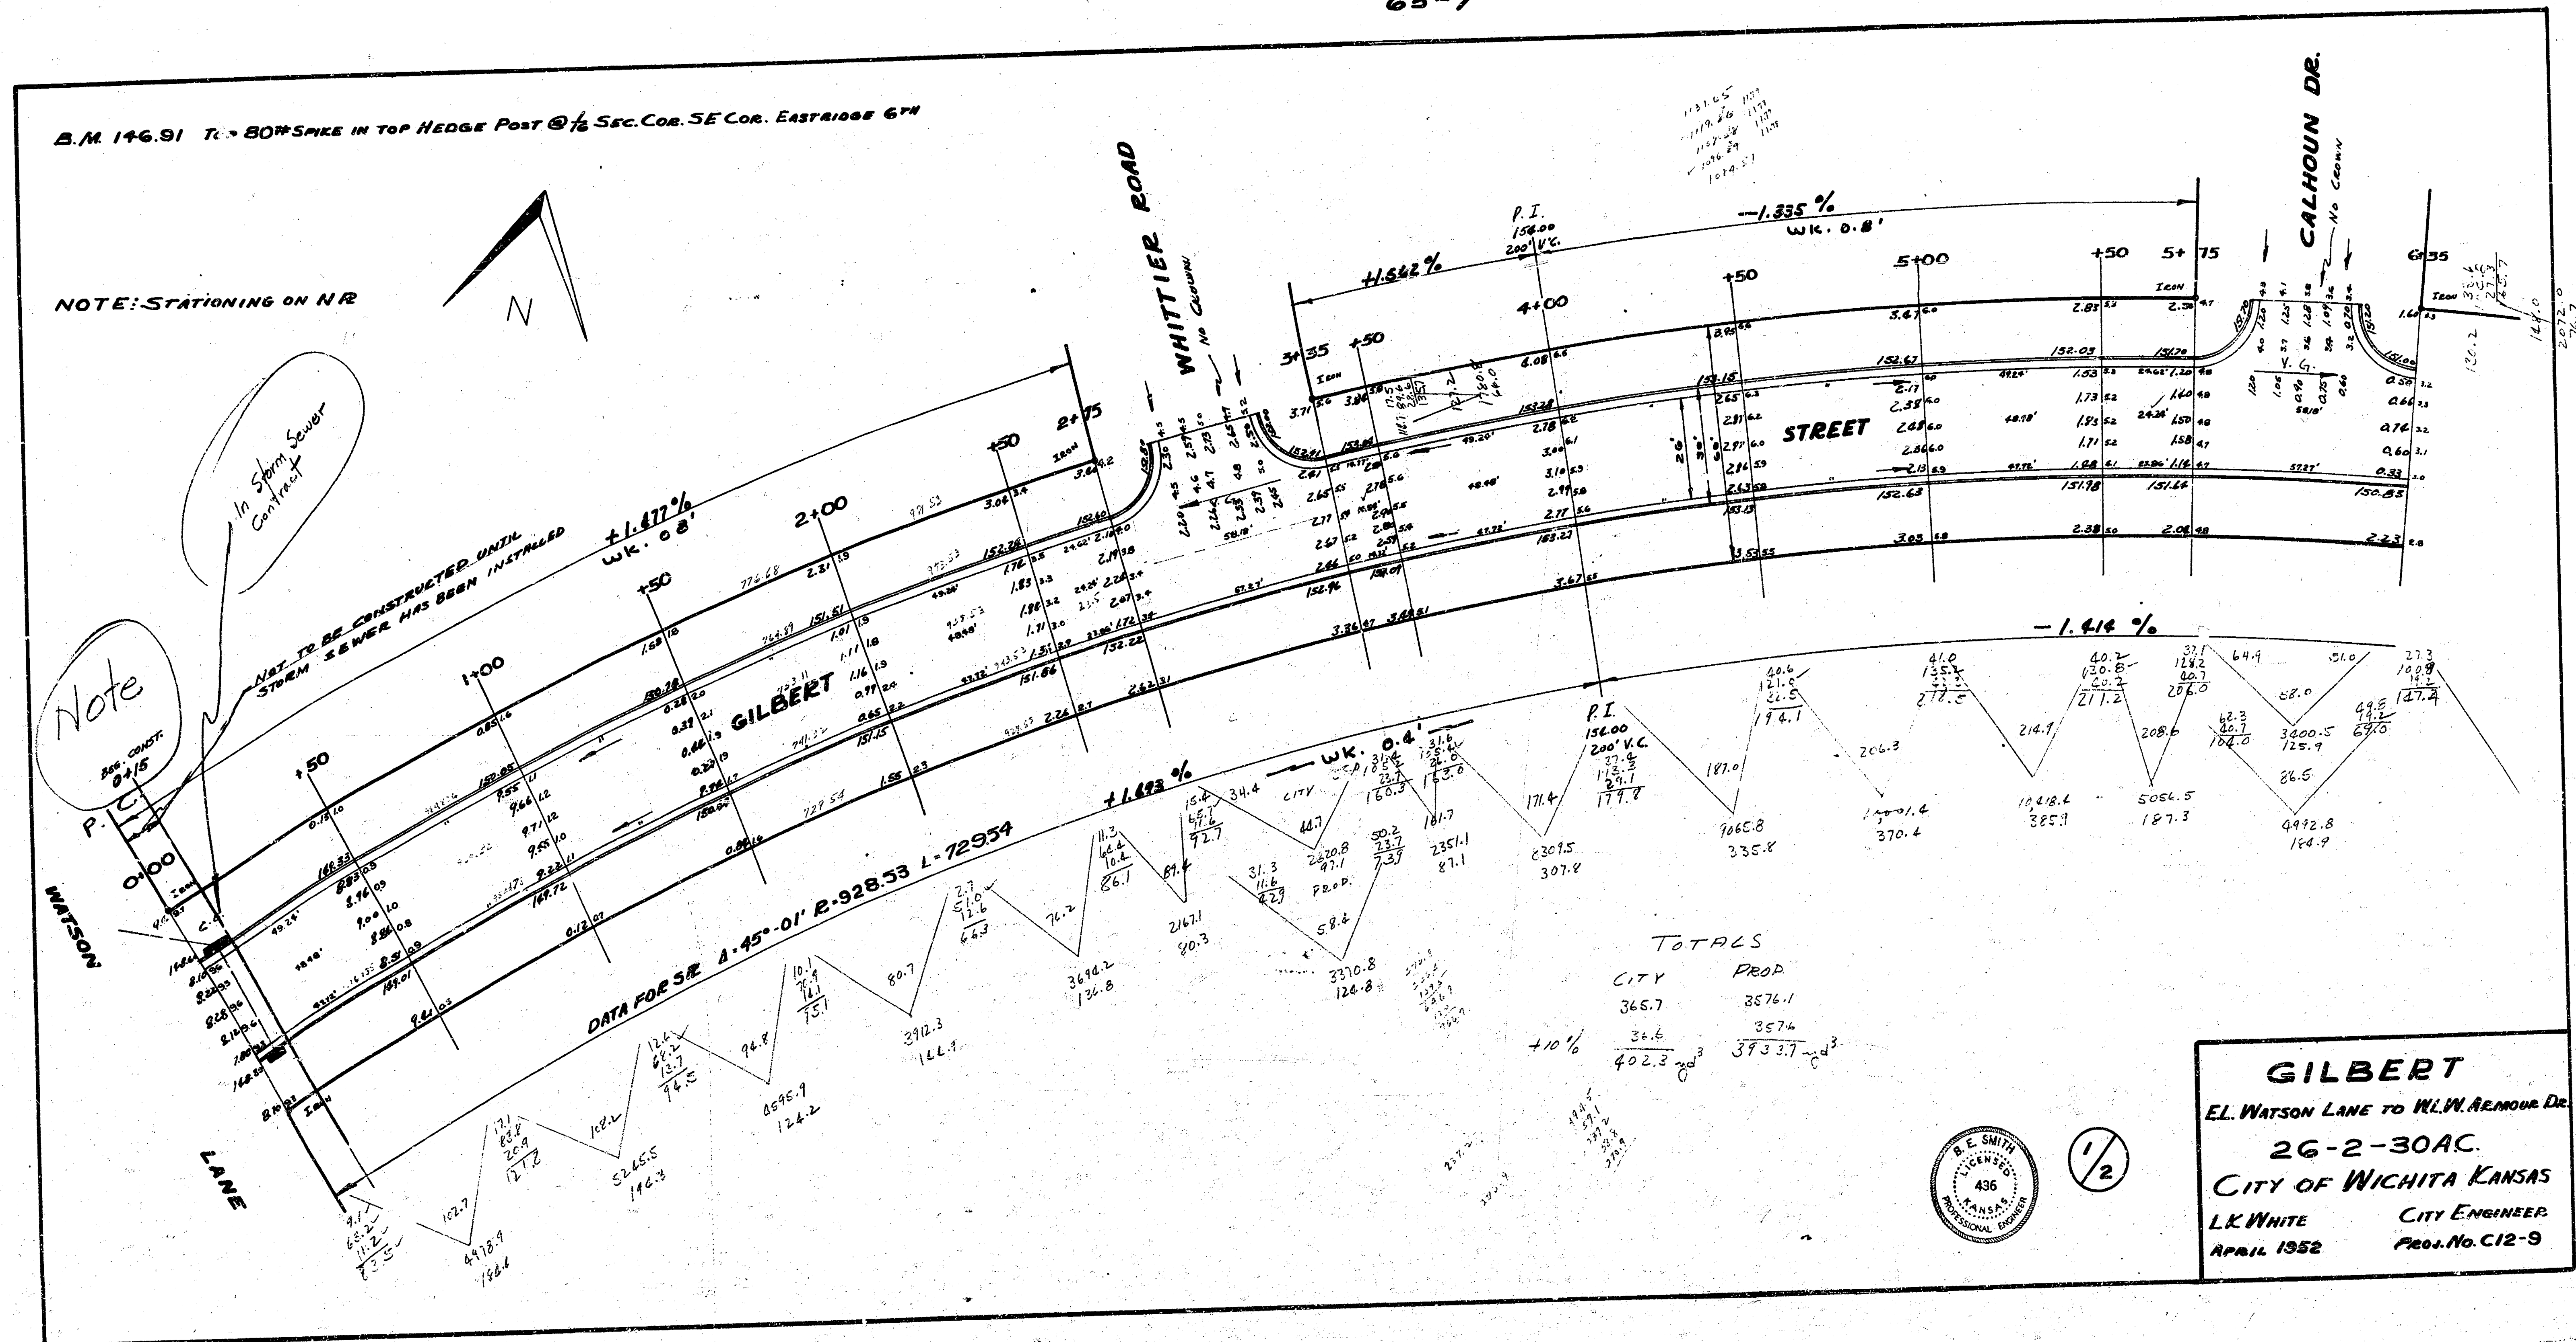

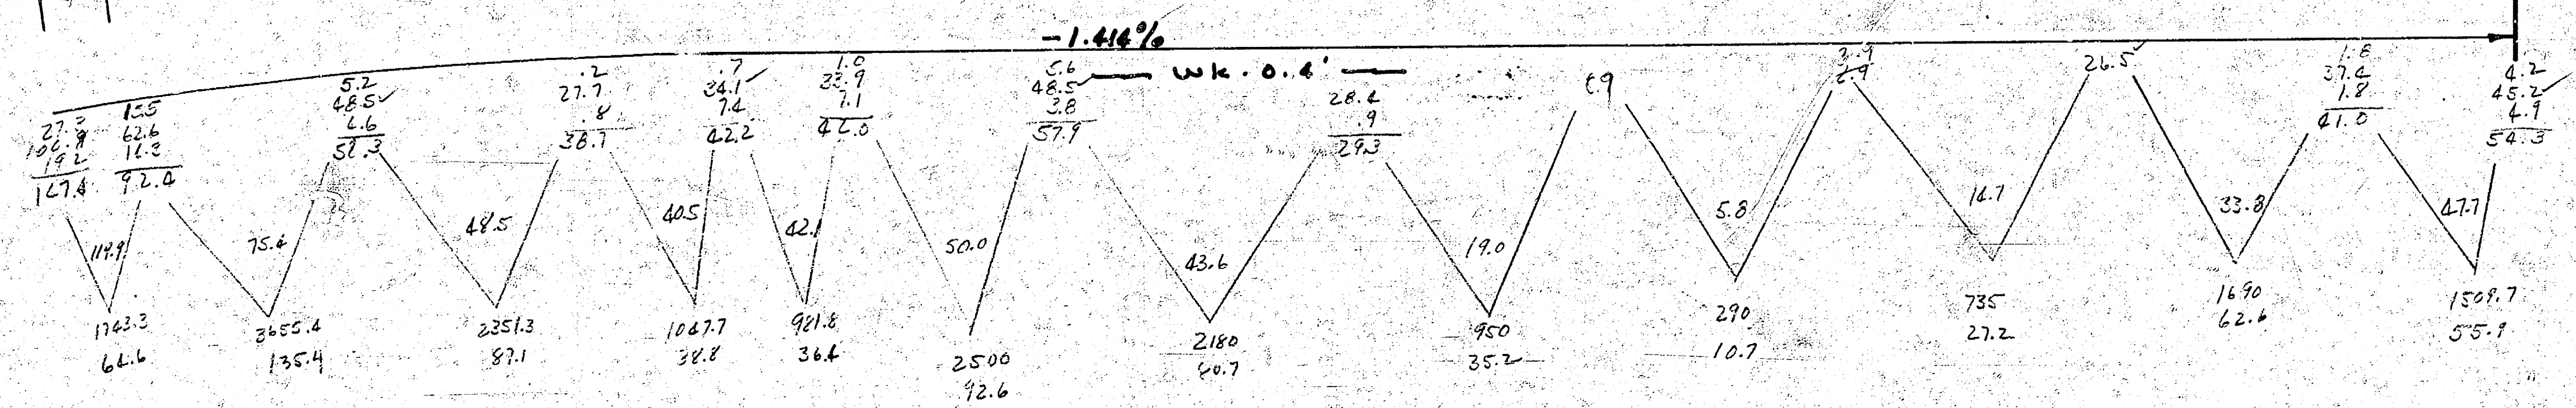


CALHOUN DR.

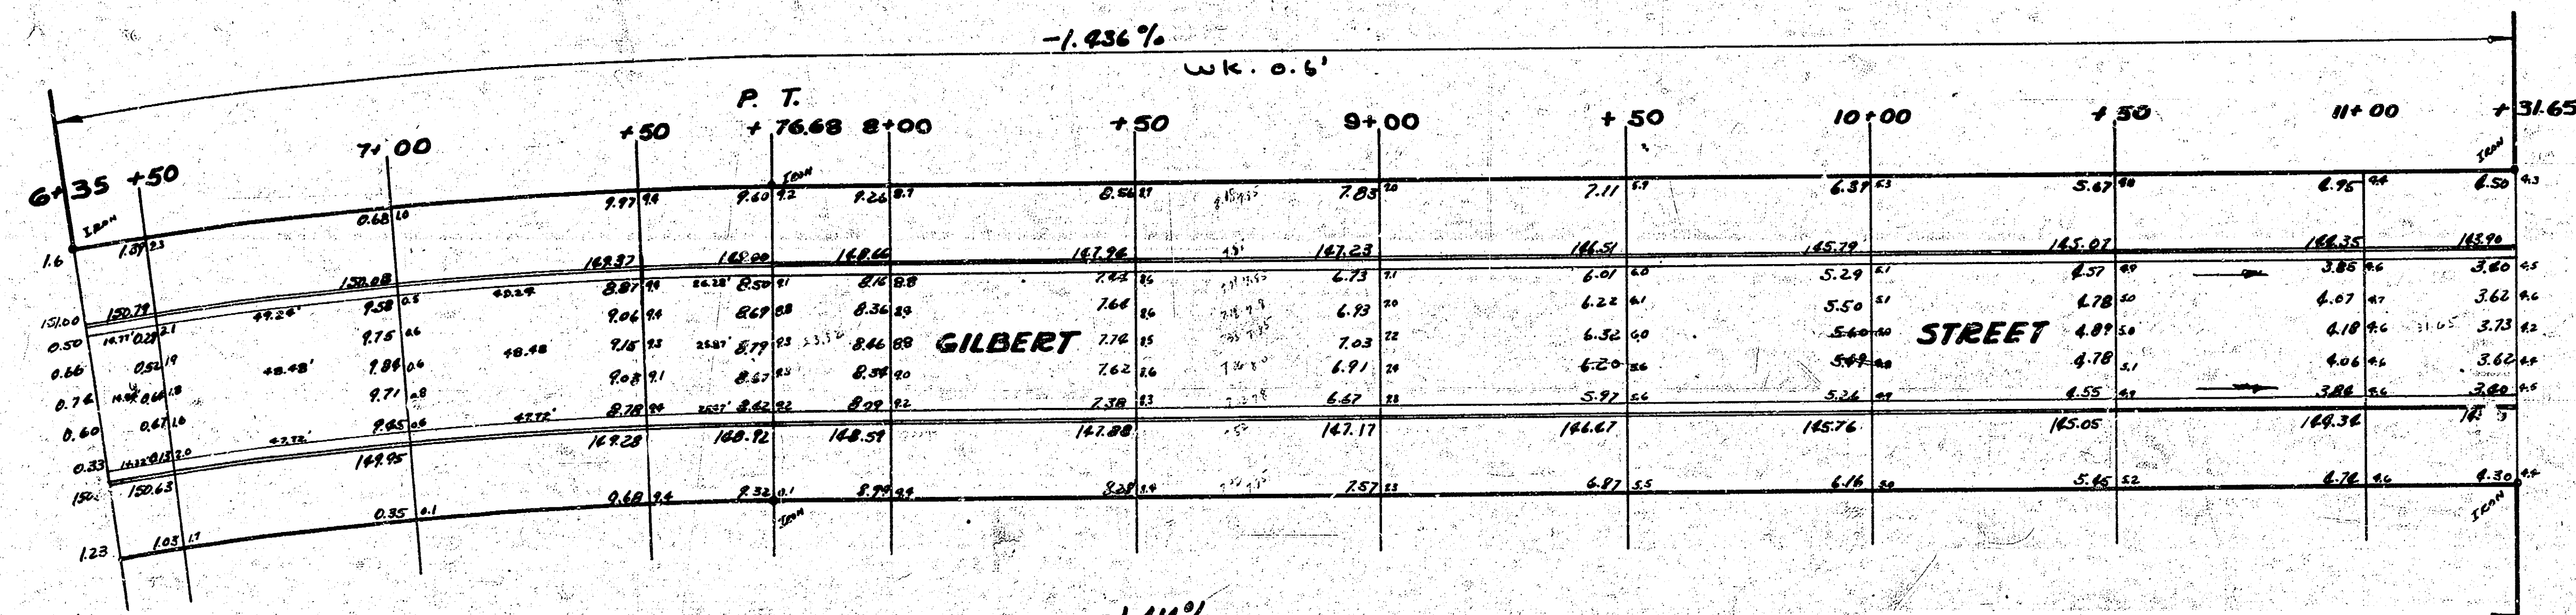

DRIVE

ARMOUR

GILBERT

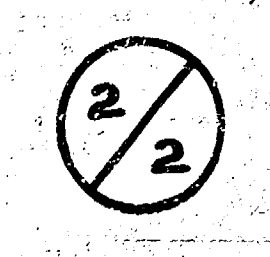

1552