B.M. 166.93 "G" in Globe E.L. Roosevelt, E. end of Rad., S.E. Cor. Roosevelt & Gilbert
B.M. 163.50 "X" on cb. radius, W.S. Bluff, N.S. Quentin

Note: Stationing on curve is on S.P.L.
Cb. grade set on cb. line distances.

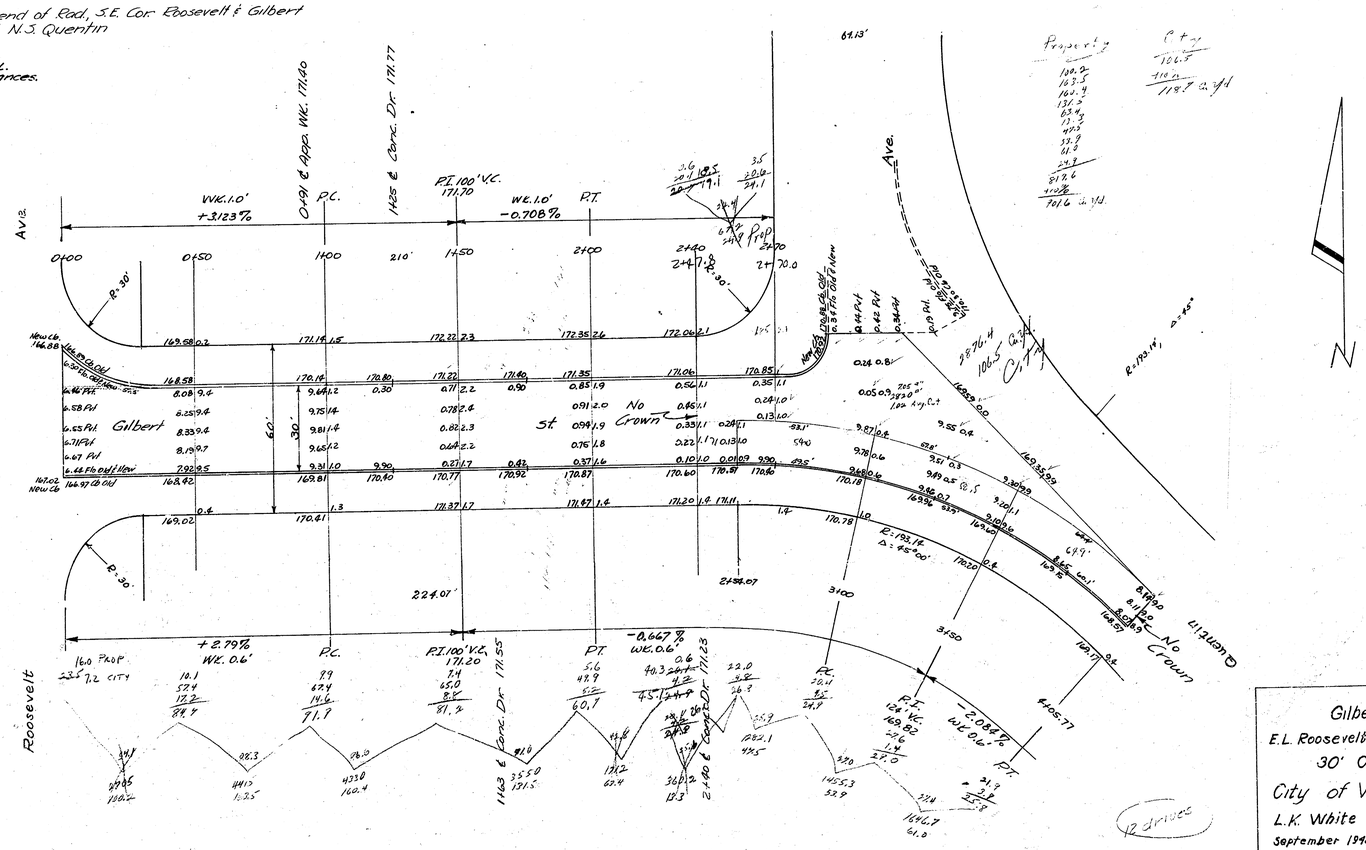

Gilbert St
E.L. Roosevelt ~ E.L. Quentin
30' Conc. & Cb.
City of Wichita, Kansas
L.K. White City Engineer
September 1948 Project C18-135

4 12 1 14