


PHC-WP
20-43
C.M.

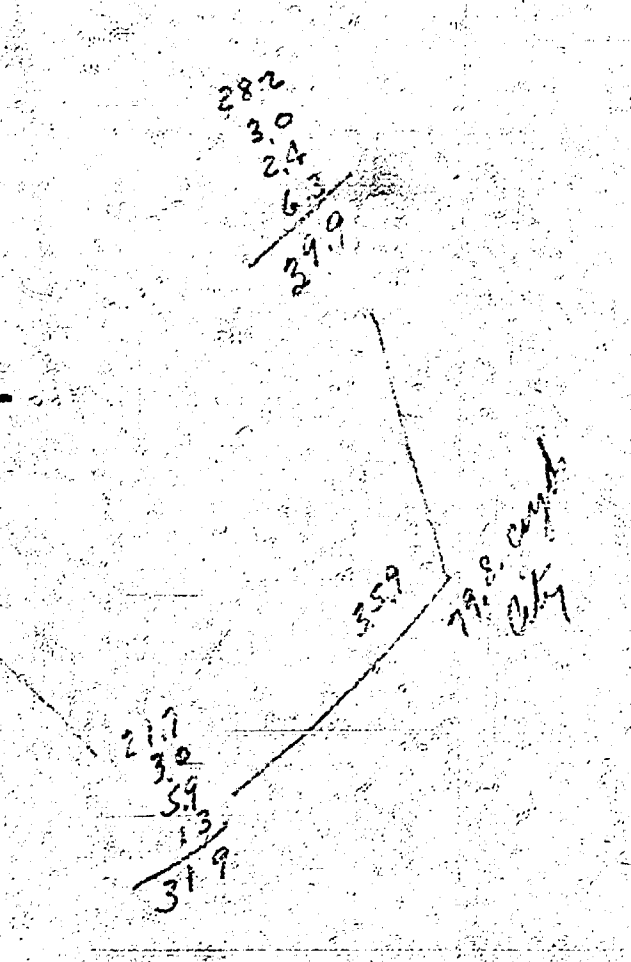

avg	225.1	avg
1070	225	
Total	247.6	avg

