


Note:
 Take new sections on stations indicated
 at Pt. E to E of paving when you
 set cut stakes.

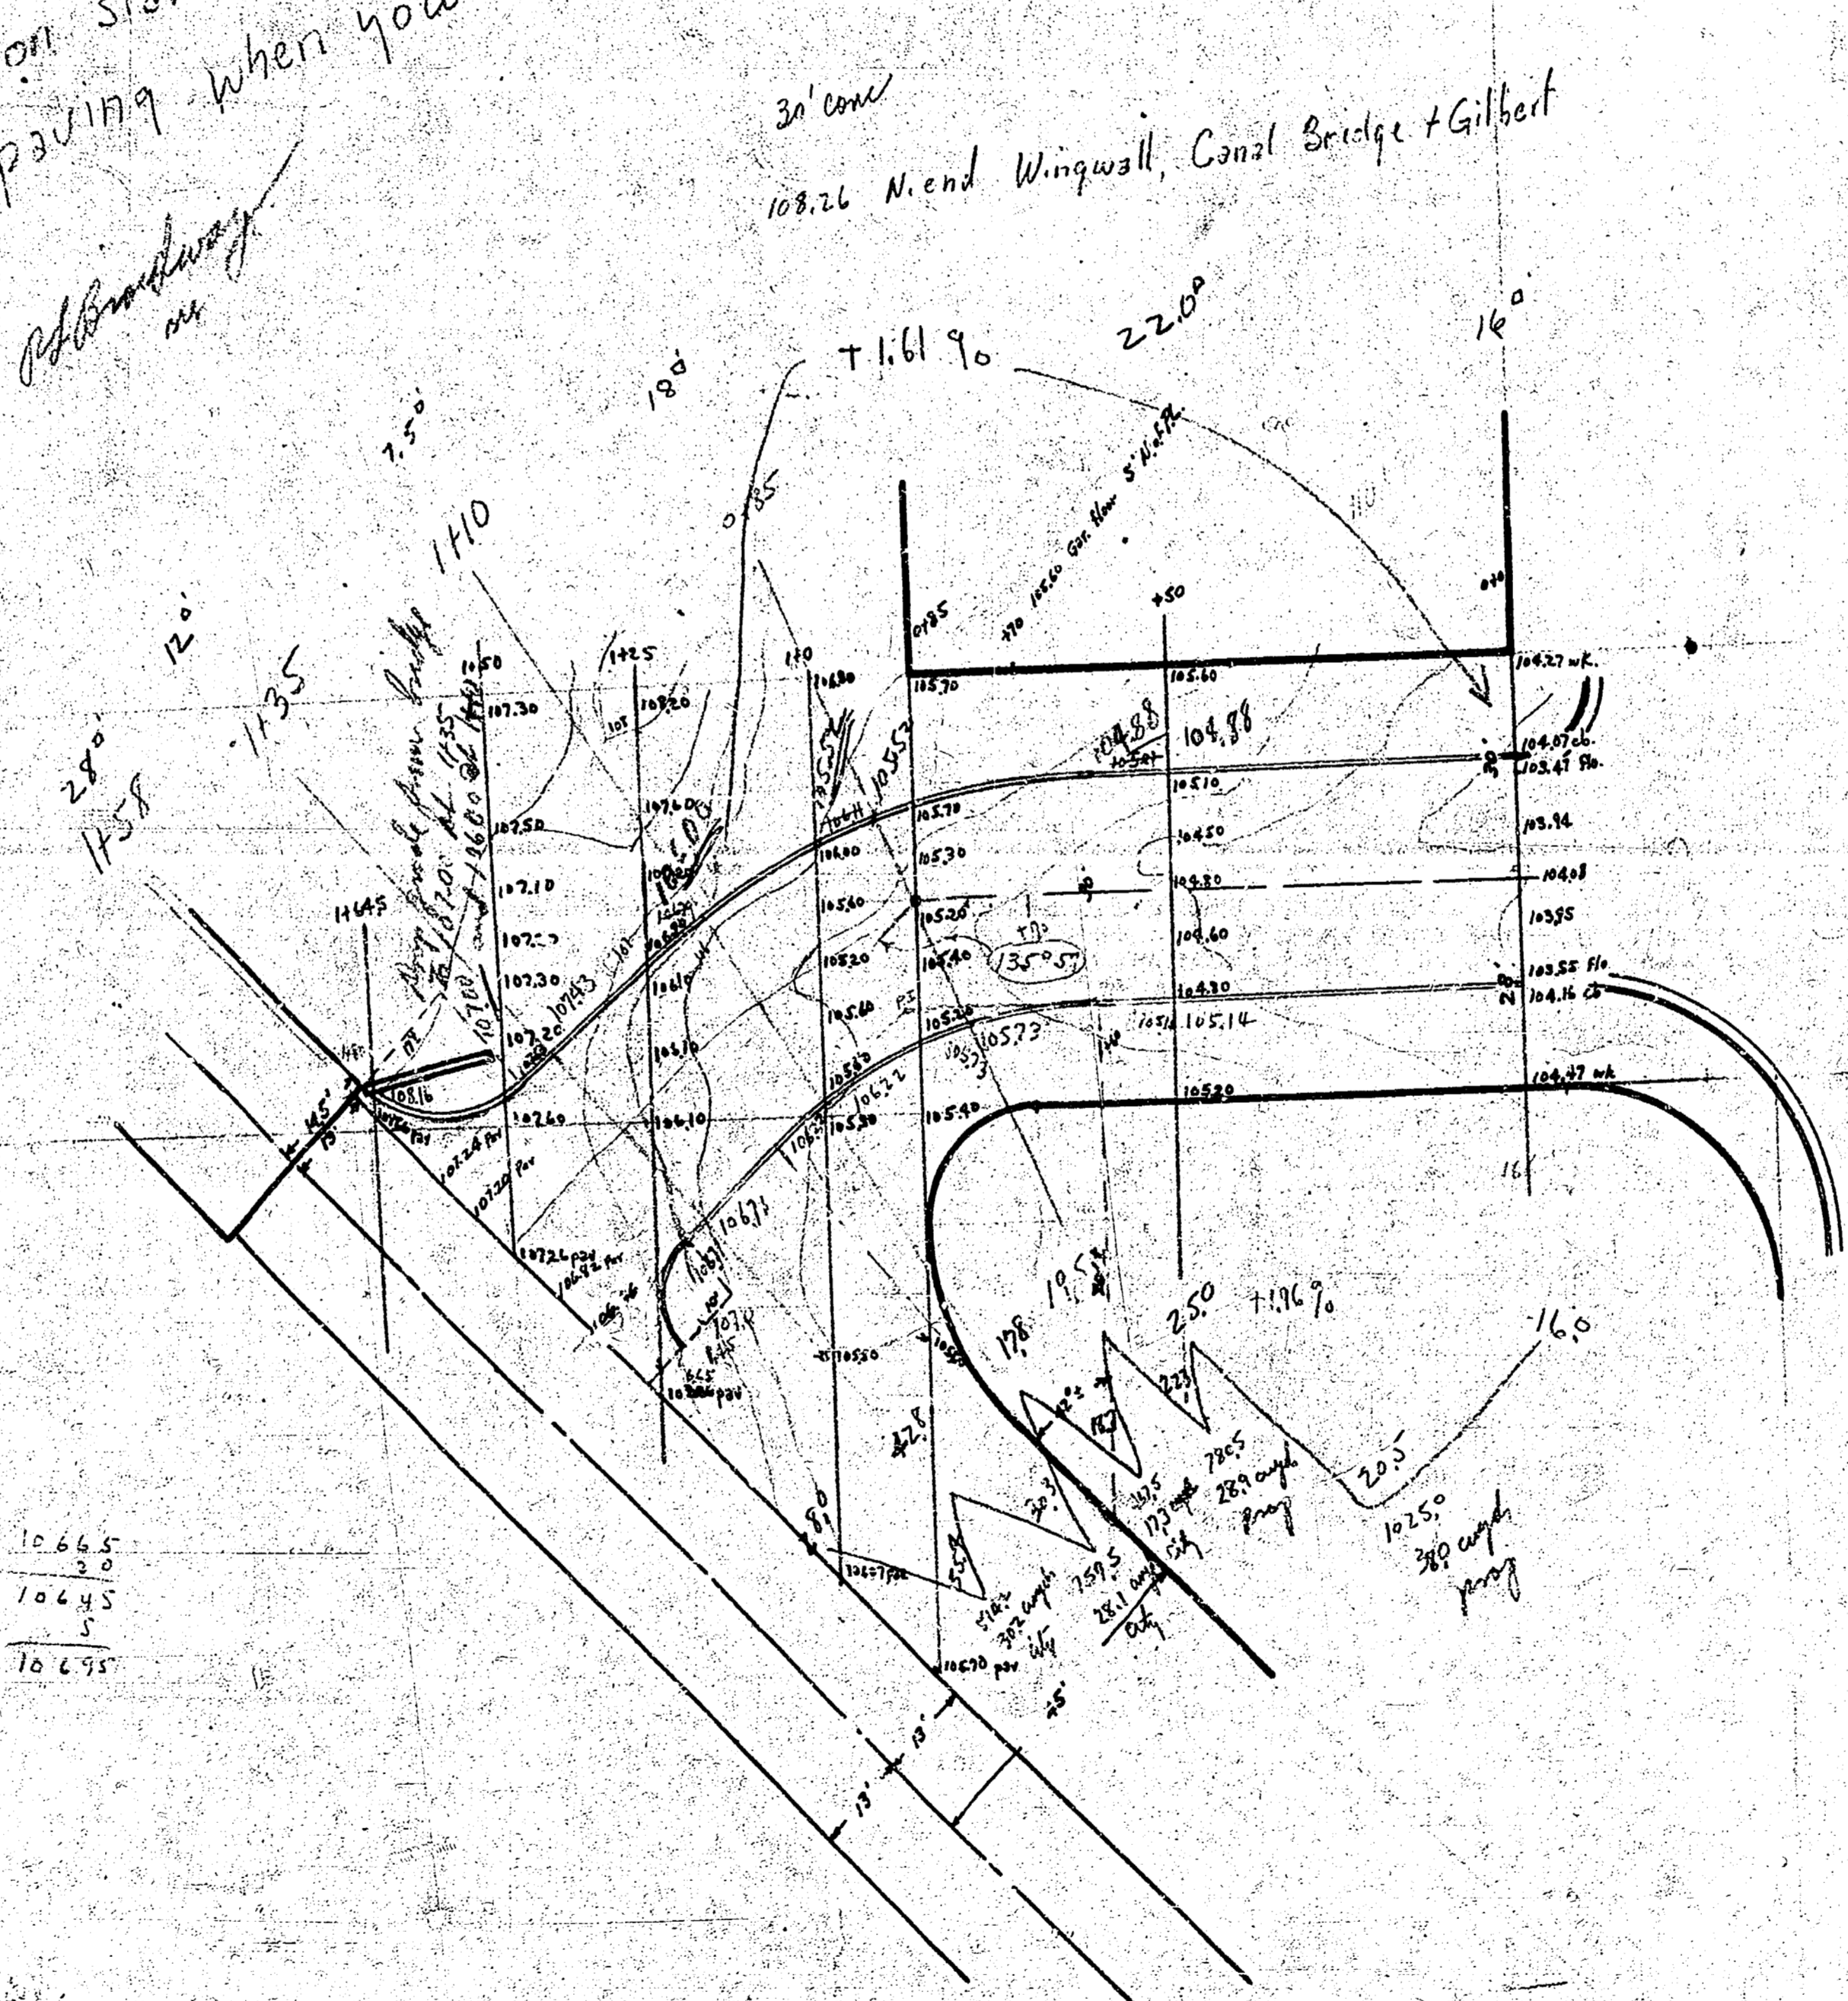

$Prq = 66.9 + 6.7 = 73.6 \text{ angles}$
 $cty = 73.6 + 7.1 = 80.7 \text{ angles}$

136	1066.5
54	5.0
	1064.5
	5
	1064.0

Plan
 1940
 Gilbert St.
 N.E. Ass.
 in
 Grand Blvd.