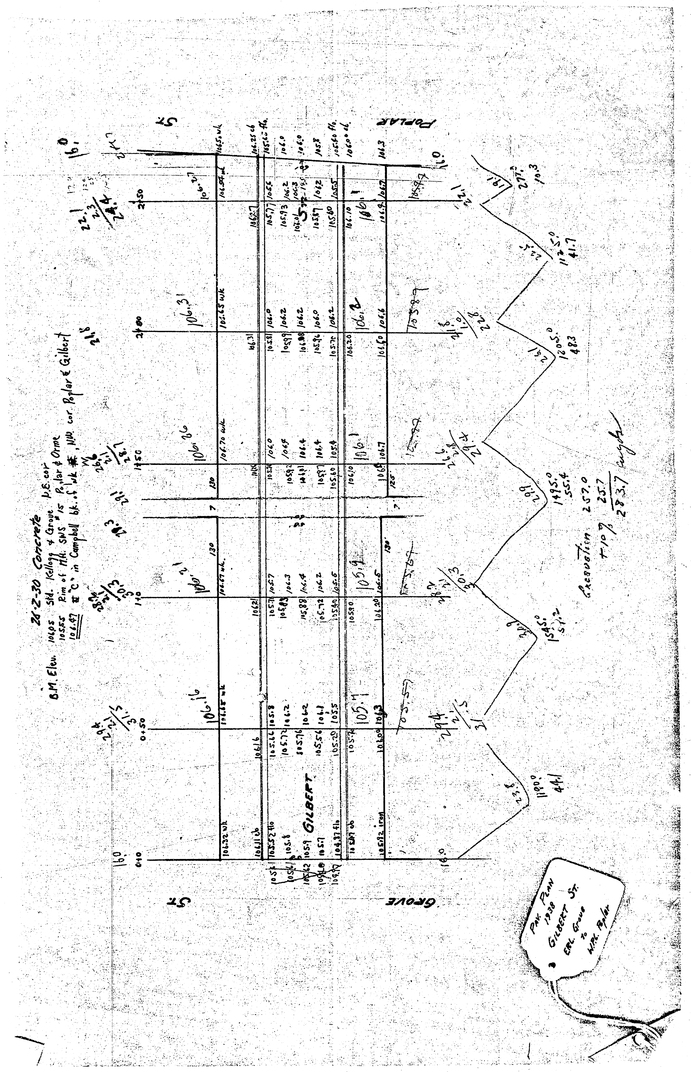
24-2-30 Concrete
B.M. Elev.
Baker & Gilbert
GROVE
GILBERT
POPLAR
Excavation
Pay Point
Gilbert St
Grove
Poplar