


Final Estimate show
not include parking expansion
as nothing shown here 1946

Gilbert E.L. Poplar W.L. Green 30' & Curb Concr.

BM Elev. 105.82 T in Thackeray Fk Wks SW Grove Gilbert
106.07 W in Whaley St S. of Gilbert E.L. Poplar
106.77 K in Keeler C App. W. of N. of Gilbert E.L. Green

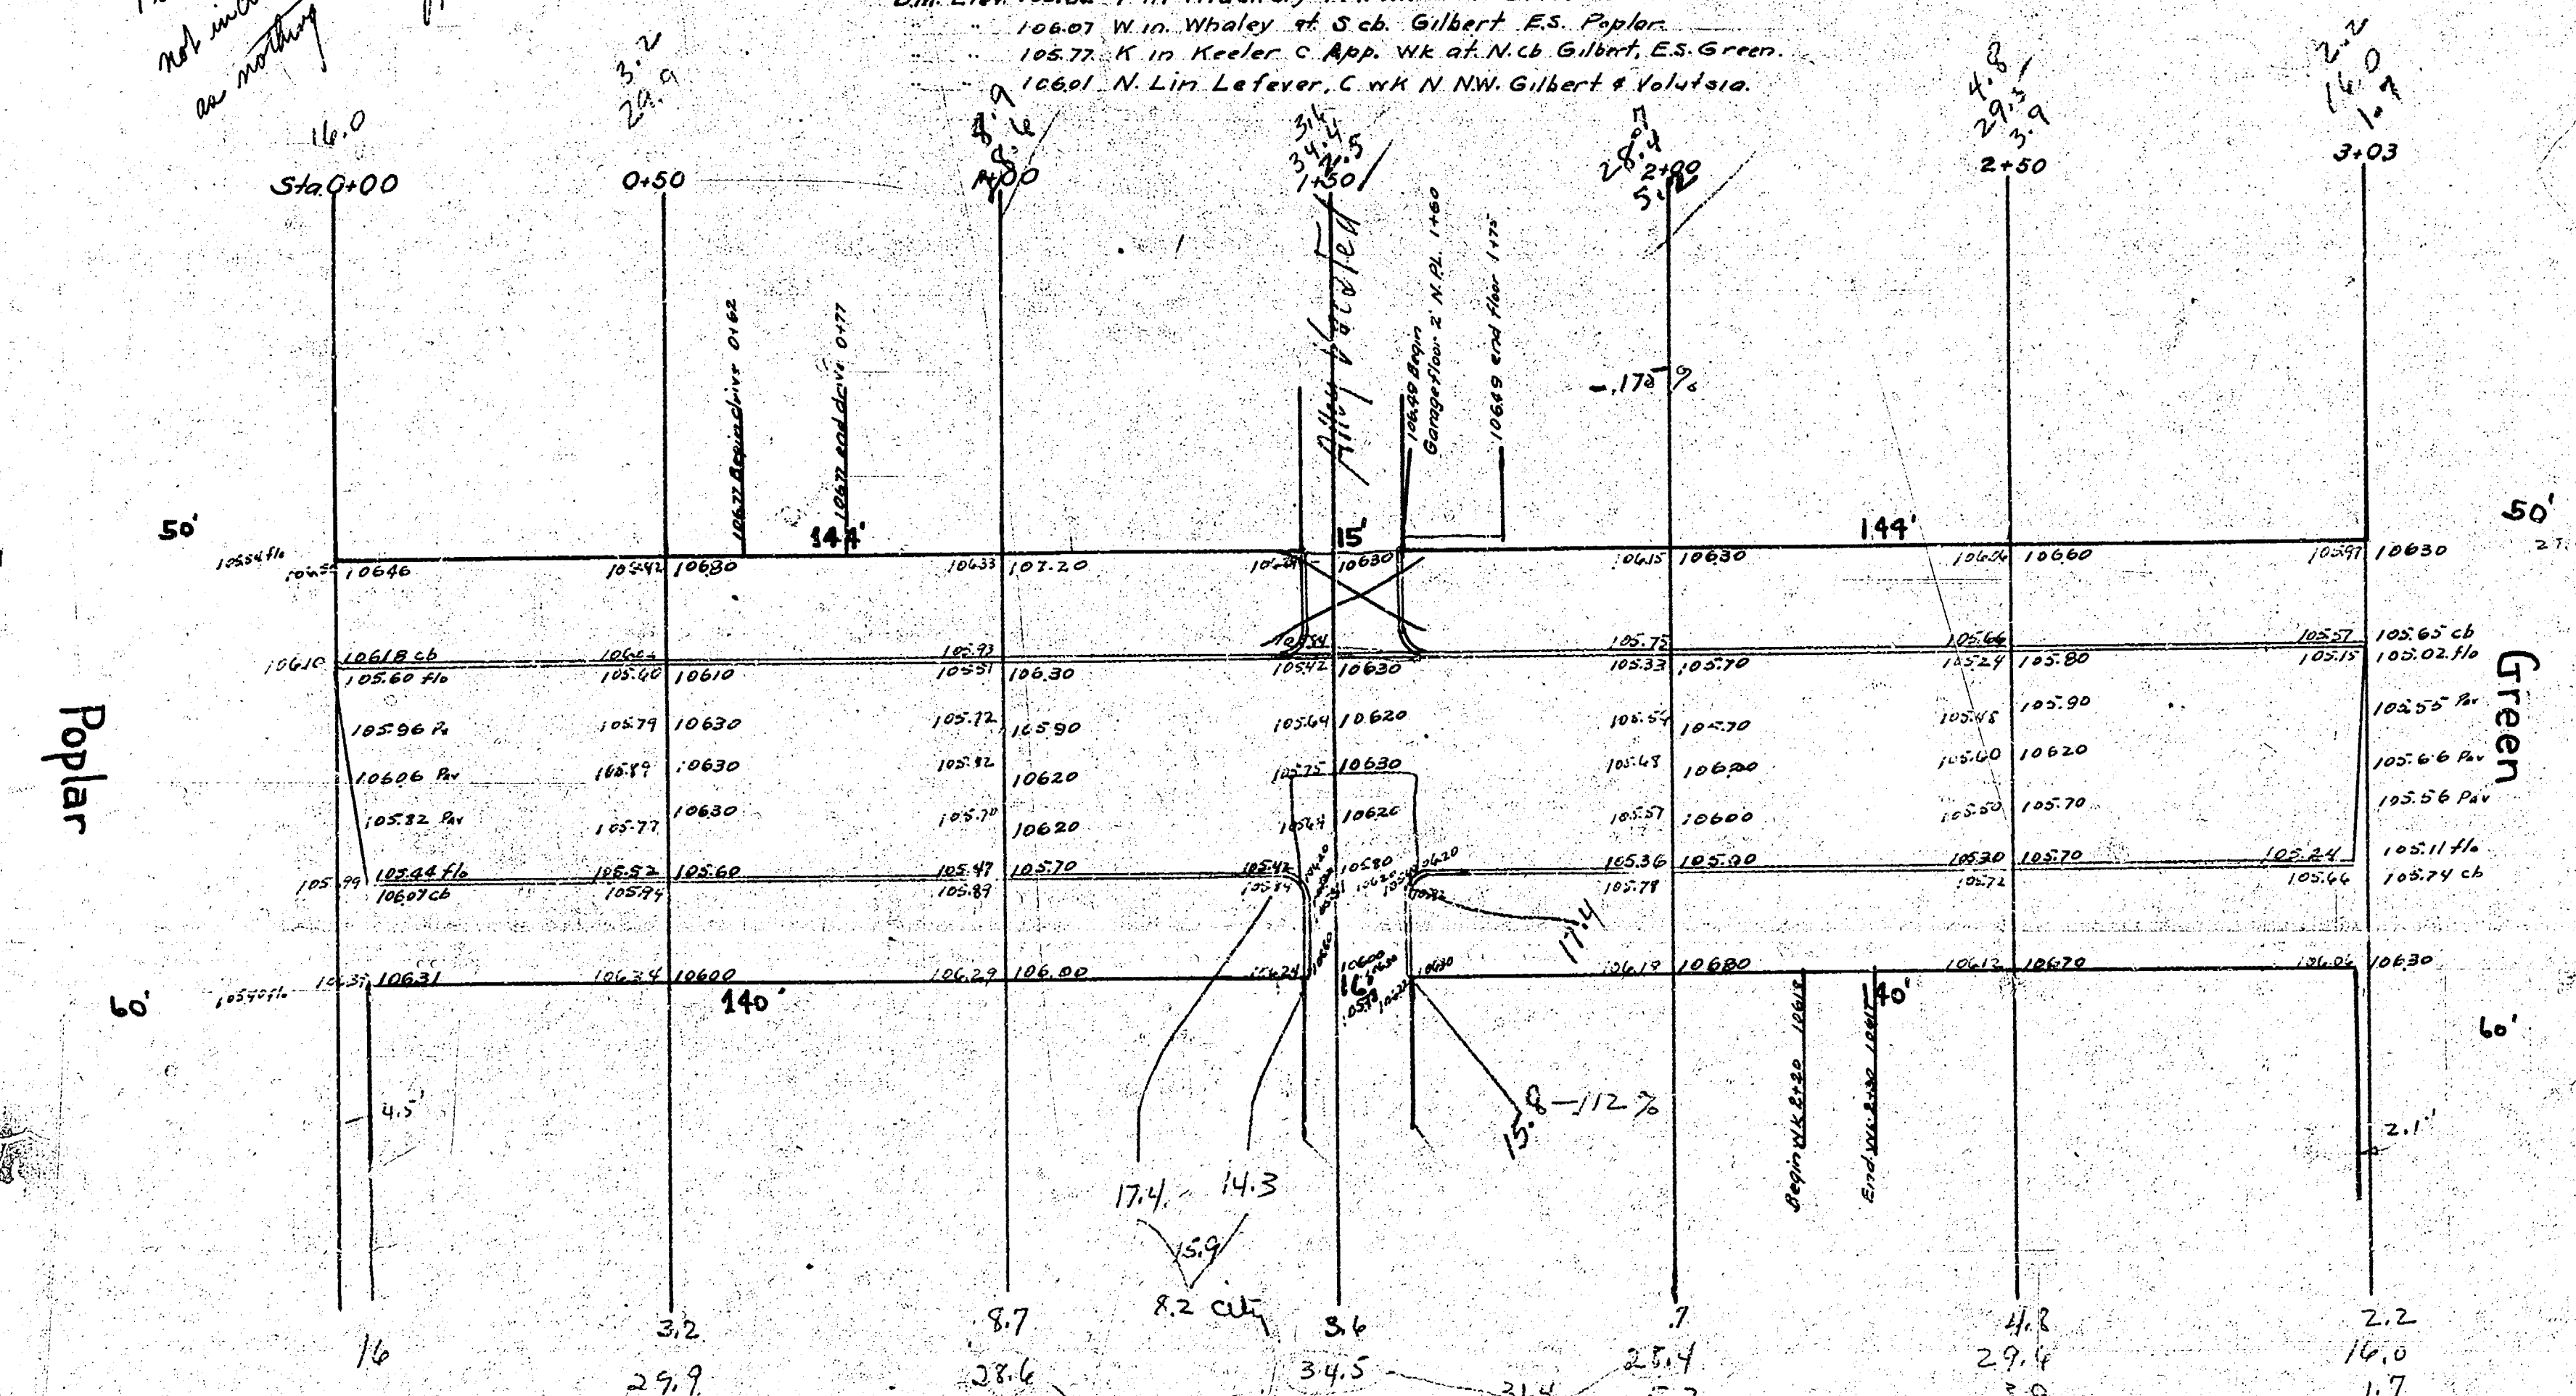

Prop 359.0 + 3.9 = 392.9 wgh
City 17.6 + 1.8 = 19.4 wgh

Paving Plan
1946
Gilbert -
W.L. Green
E.L. Poplar

16	3.2	9.7	8.2 cut	5.6	7	4.2	2.2
	29.9	38.6	31.4	34.5	31.4	29.4	16.0
16	33.1	37.3	38.1	34.3	38.3	29.1	1.7
	24.6	35.2	37.7	36.2	36.3	29.1	
	116.5	17.60	189.5	181.0	186.5	145.0	
	43.6	65.2	163	60.7	69.0	53.7	
			6.0	12.8			
			3.0 cut	6.4 cut			

Prop 349.6 + 3.5 = 353.1
City 18.6 + 1.4 = 20.0
Total Exc.