1941

GLENDALE - SL. ENGLISH to NL. WATERMAN

26' Concrete

5 Dips

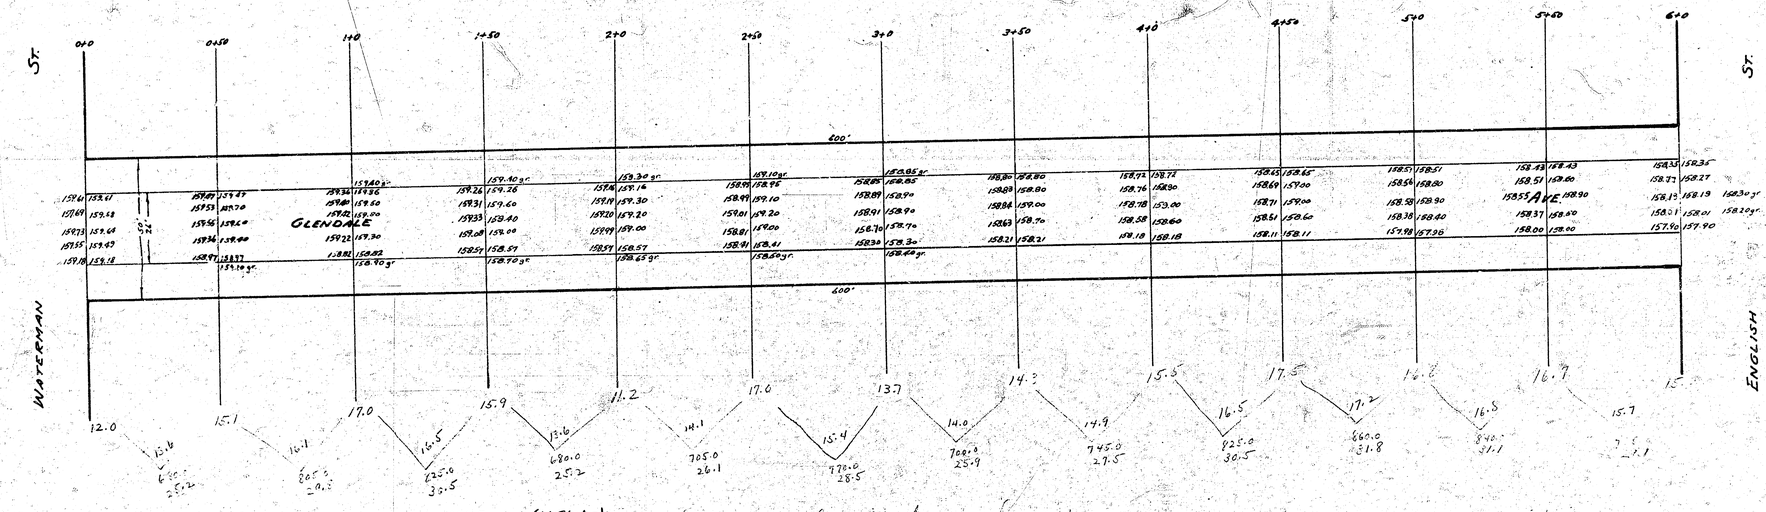

B.M. Elev. 158.84 "G" in Globe E. ch. Glendale N.L. English (N. Globe)

Curb and gutter for settlement in neighborhood of Station 1 to 2+50

+10% 34.1

375.3 cu yds

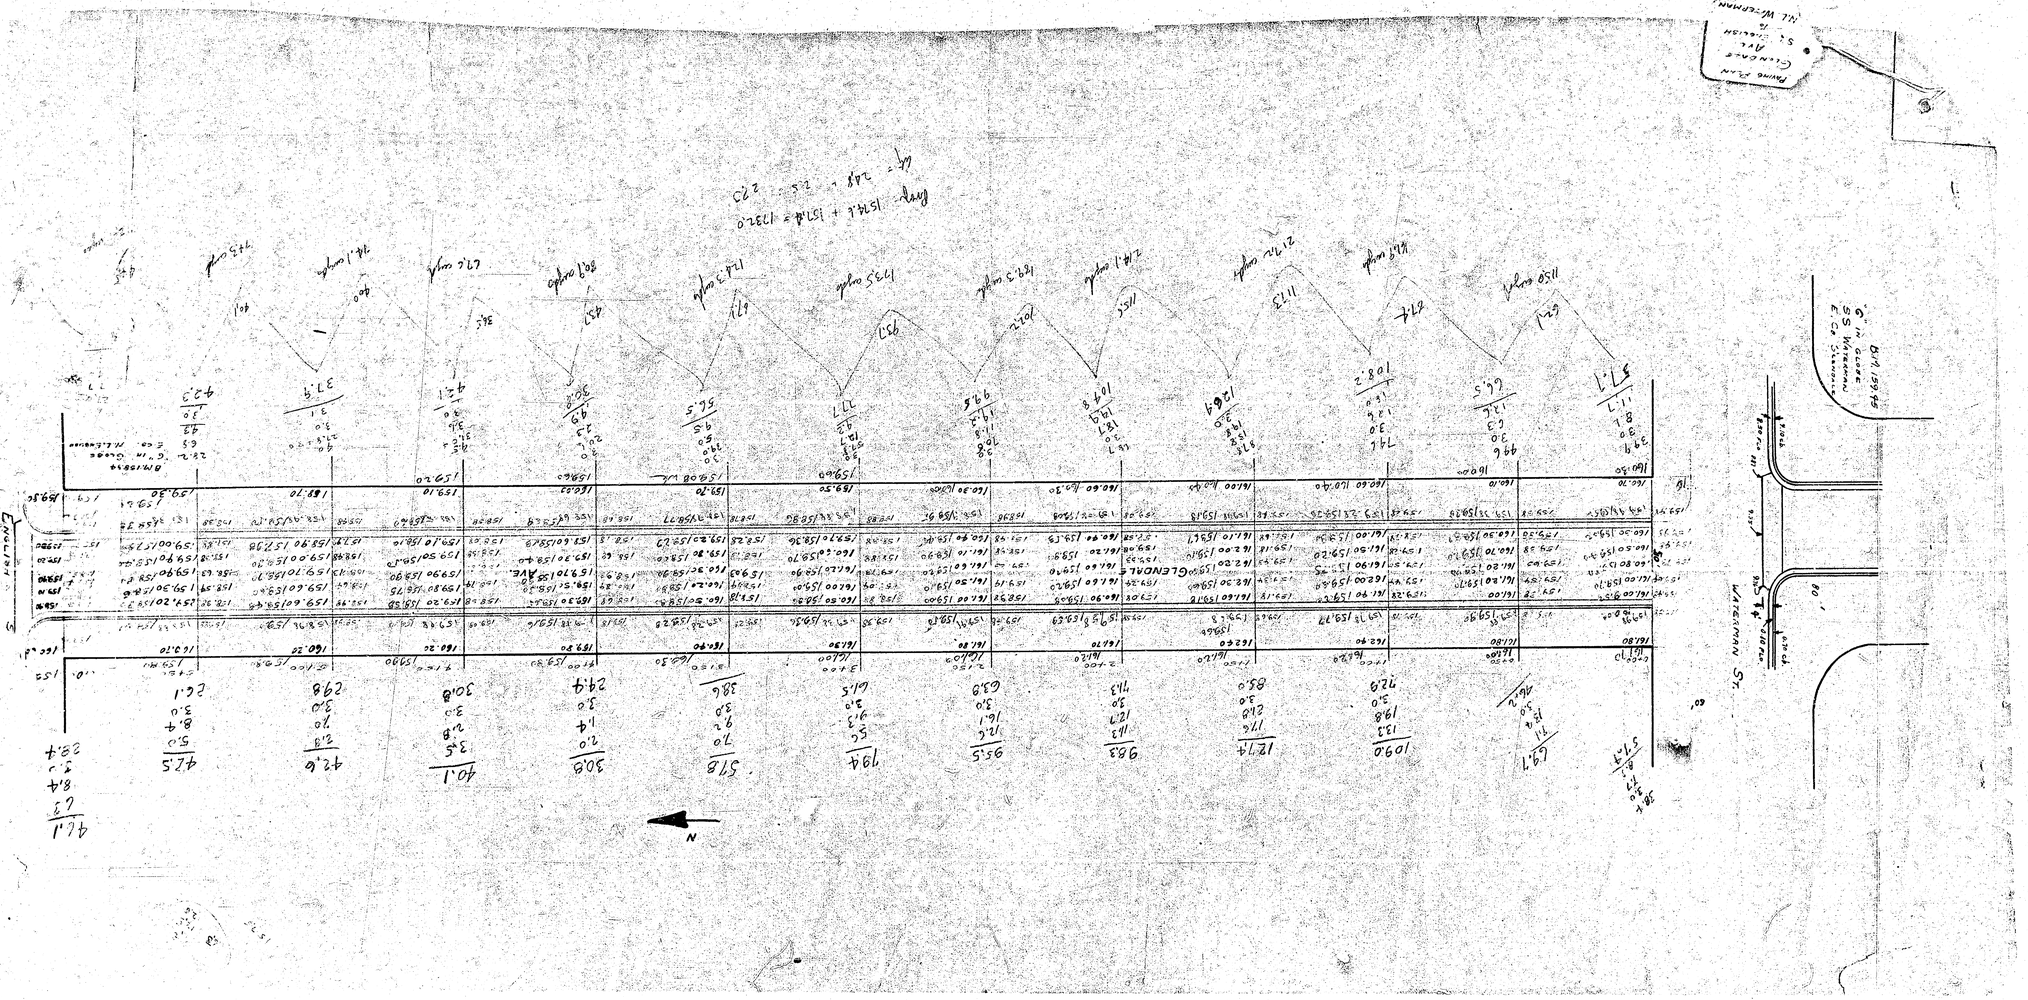
GLENDALE
BM 159.84
N