



1941
 GLENDALE - S.E. ENGLISH TO N.L. WATERMAN
 26' Concrete
 S. Drive

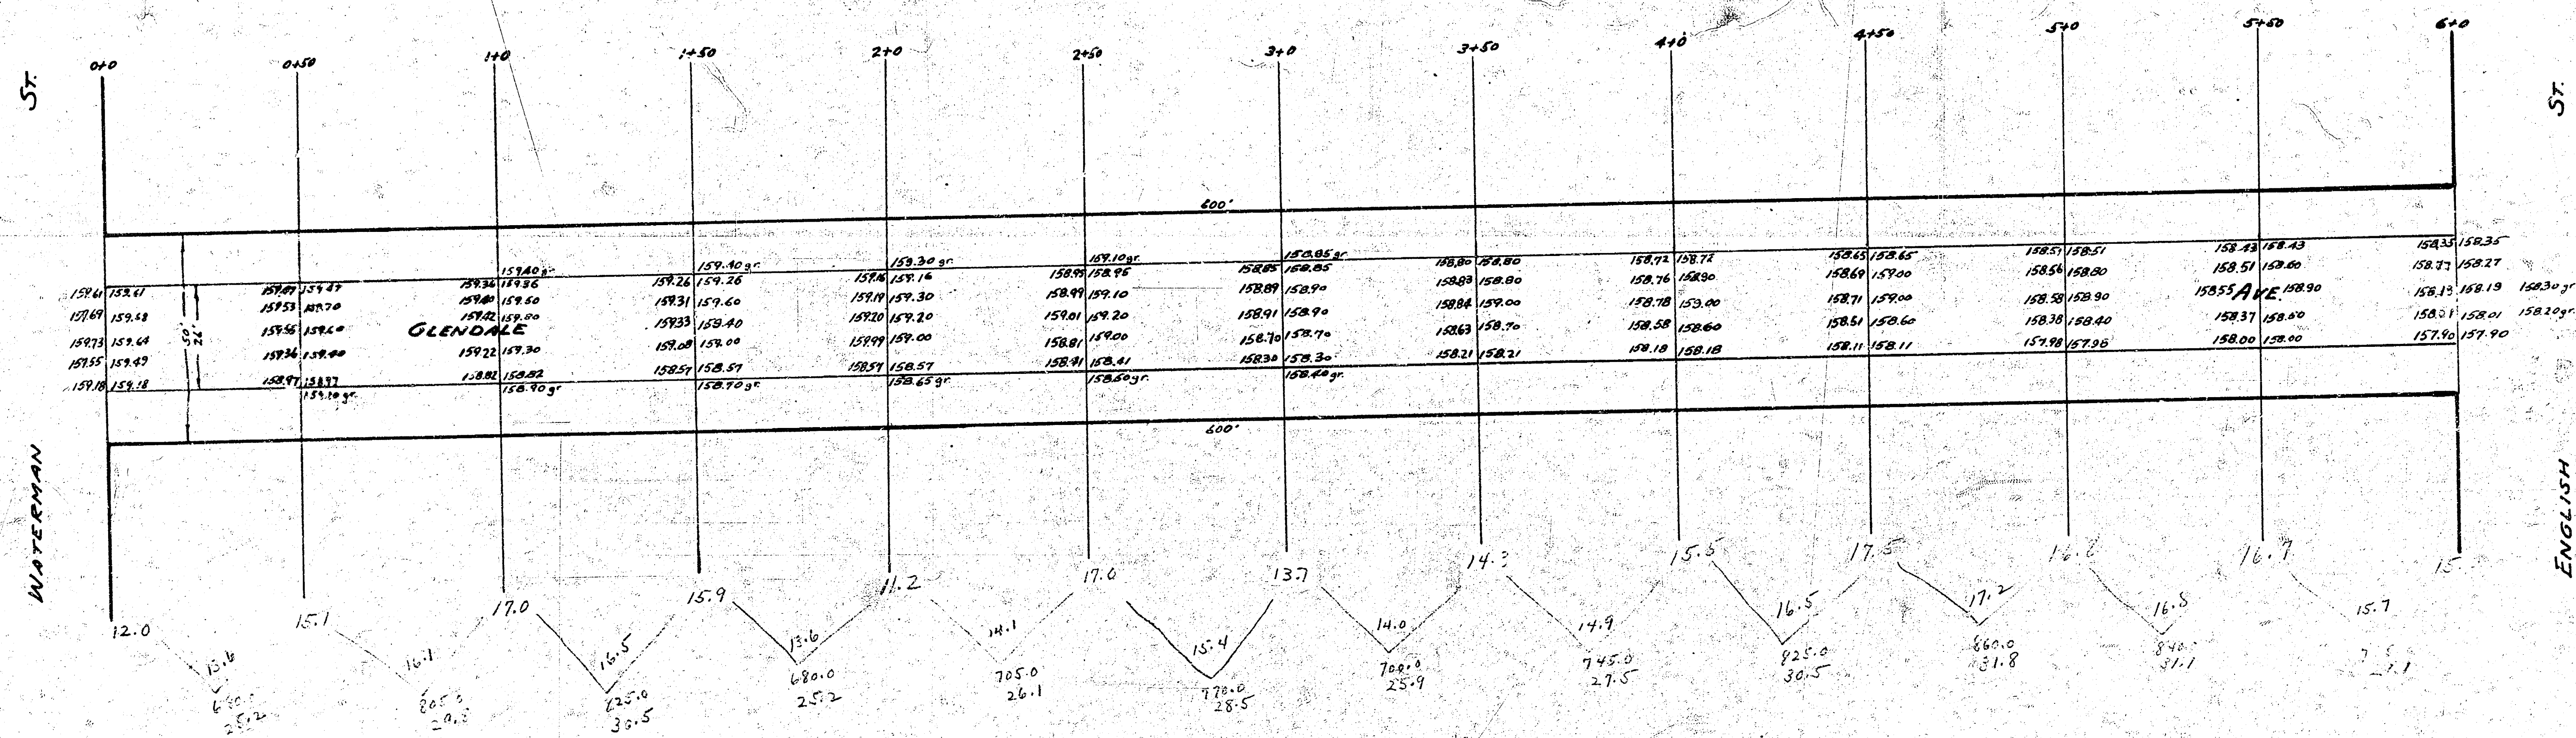

B.M. Elev. 158.84 'G' in Globe E. ch. Glendale N.L. English (N.Globe)

Back cut and gutter for settlement
 in neighborhood of Station 1 to 2+50

34.1
 375.3 change

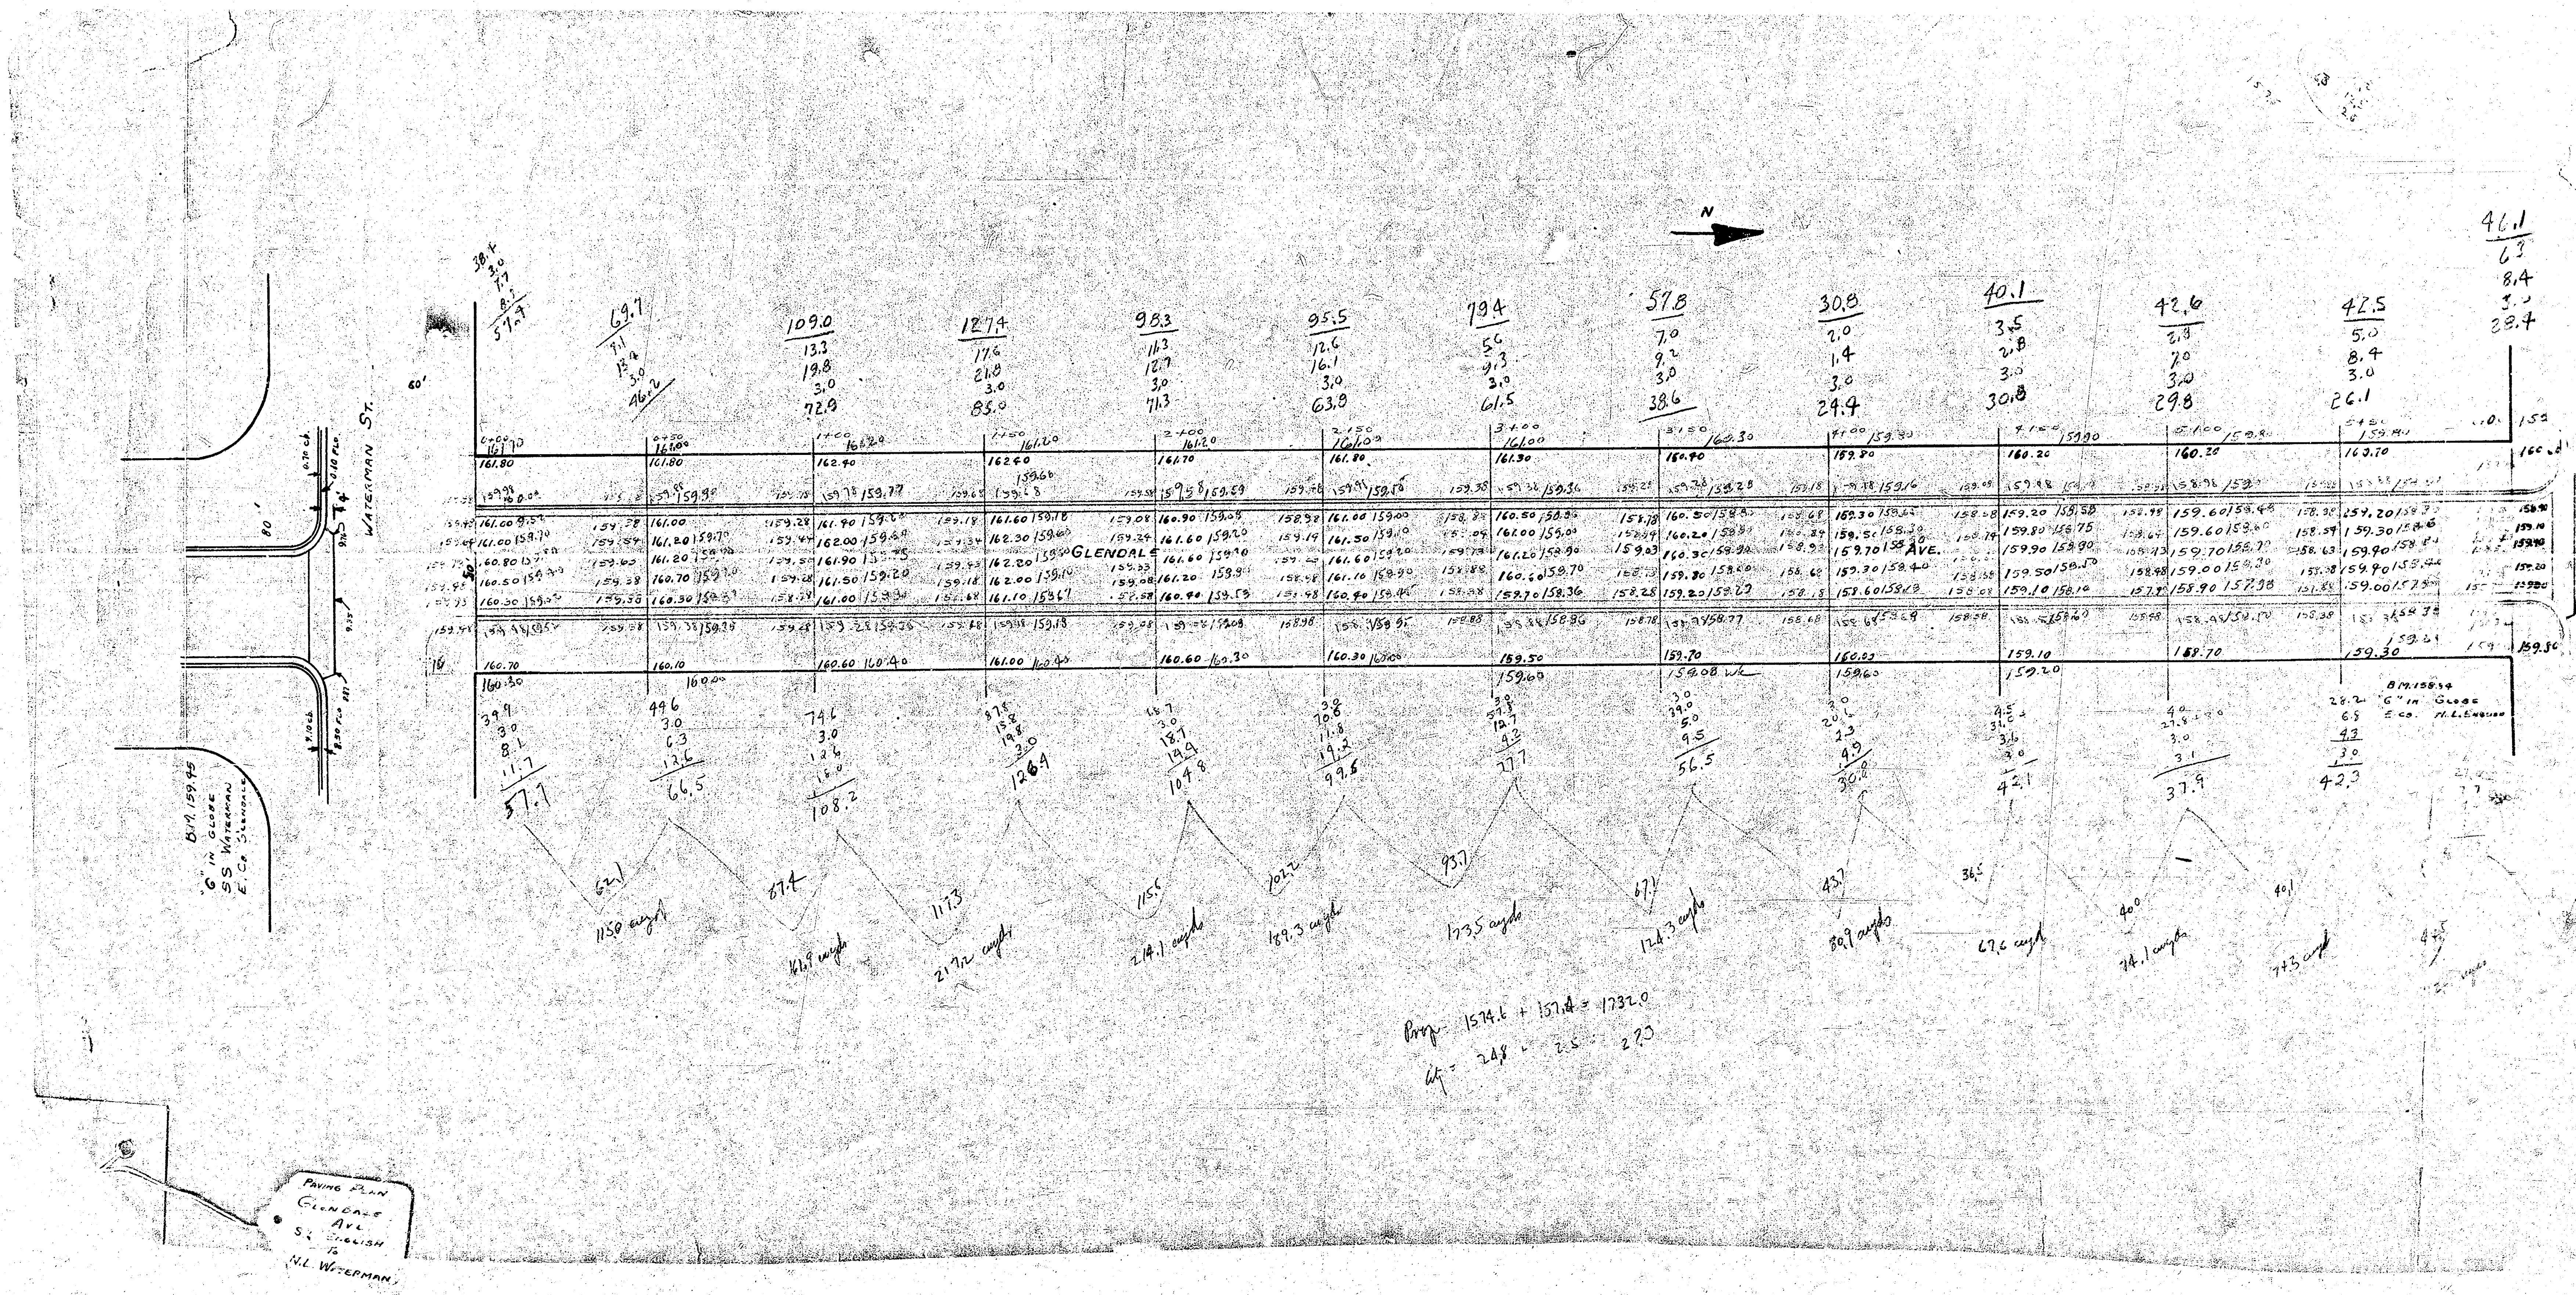

81.159.45
6" in GLENDALE
S. S. WILSON
E. C. STANLEY

Paving Plan
GLENDALE AVE
S. S. WILSON
E. C. STANLEY

Prop. 1574.6 + 157.4 = 1732.0
47 = 248 - 2.5 = 245.5