


Glendale - N.L. Douglas
to S.L. First

26' Conc.
314. 17163 N curb on front of EPL Bldg
164.87 2' on E curb Glendale to S.L. First
164.6 3' on S curb Glendale to N.L. Douglas

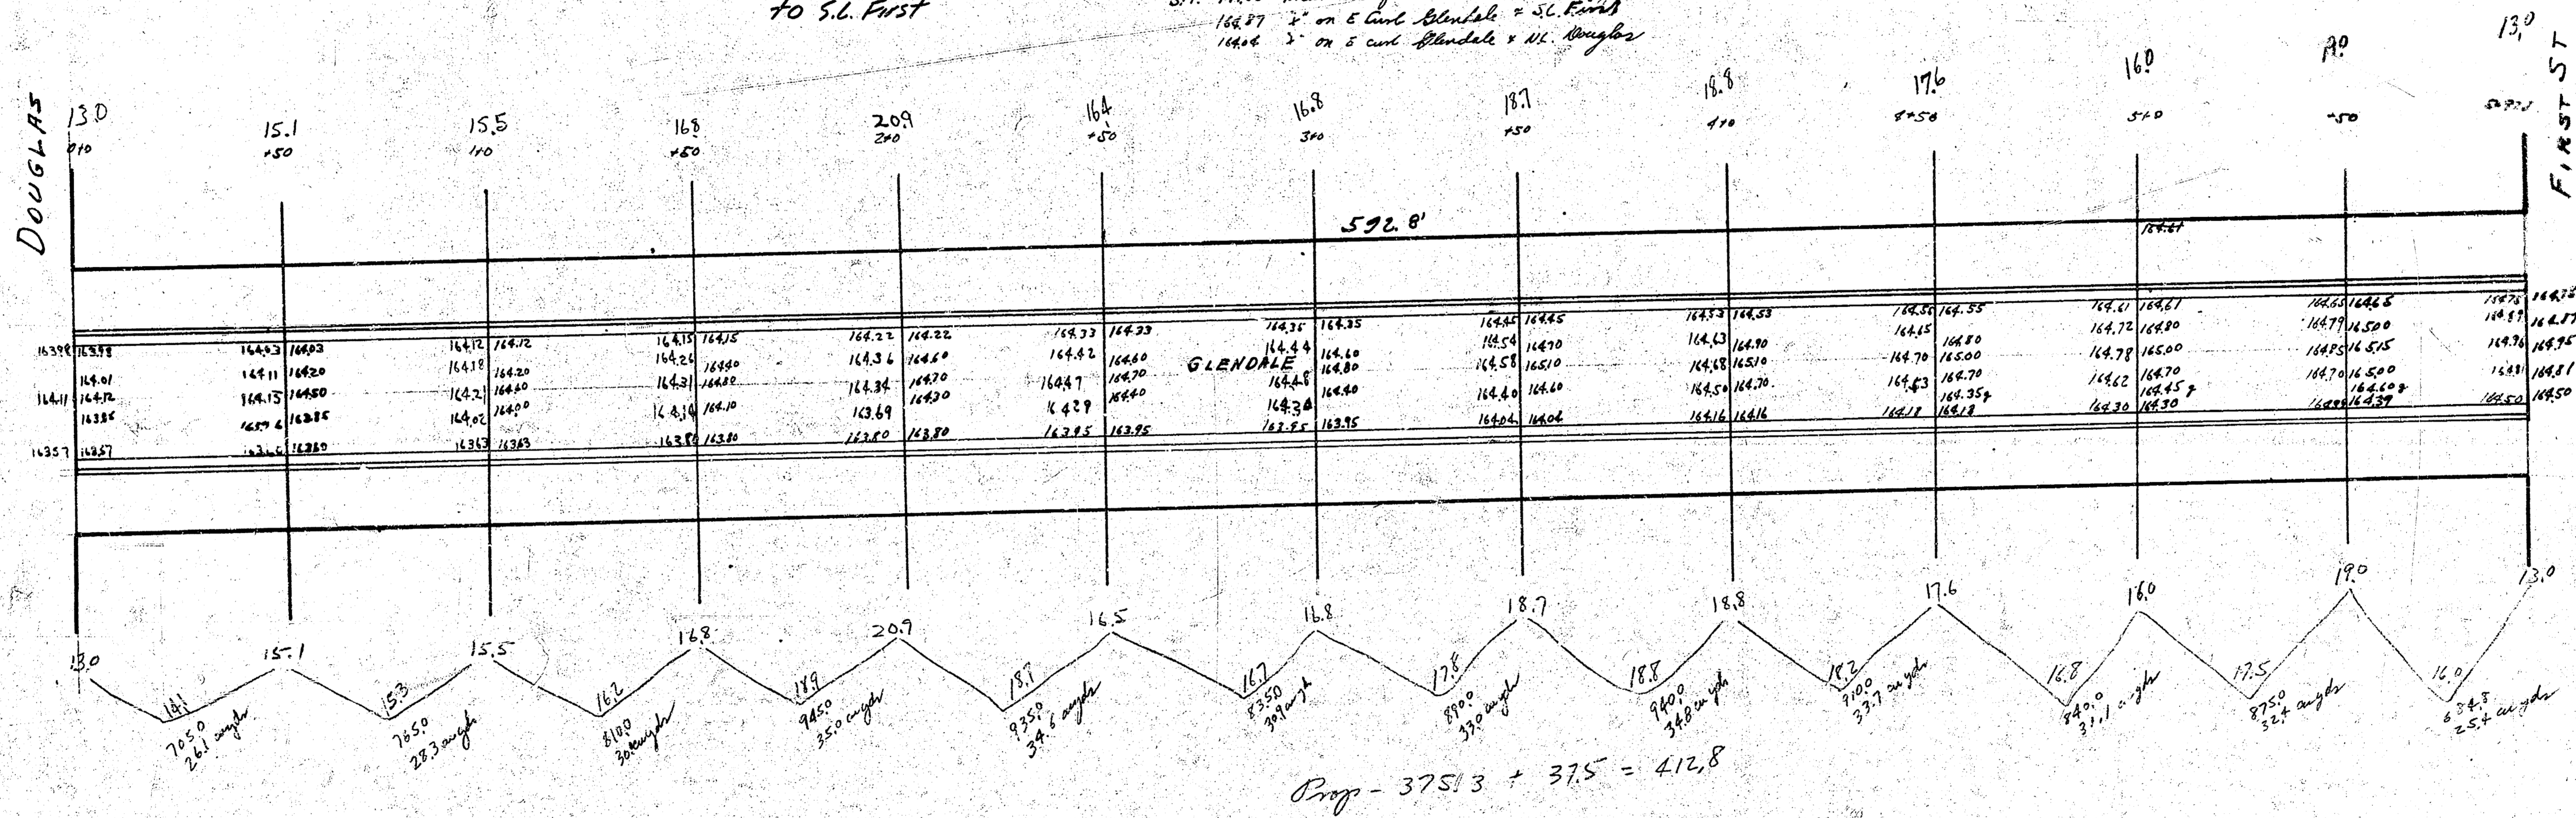

Glendale -
N.L. Douglas -
S.L. First.
Concrete
26'