


GLENDALE AVE N.L. 1ST to SL 2ND 26' Conc.
 B.M. Elev. 164.87 " on E. ch. Glendale @ SL 1ST St.
 " " 167.62 " in Globe W. Gutter Glendale SL 2ND

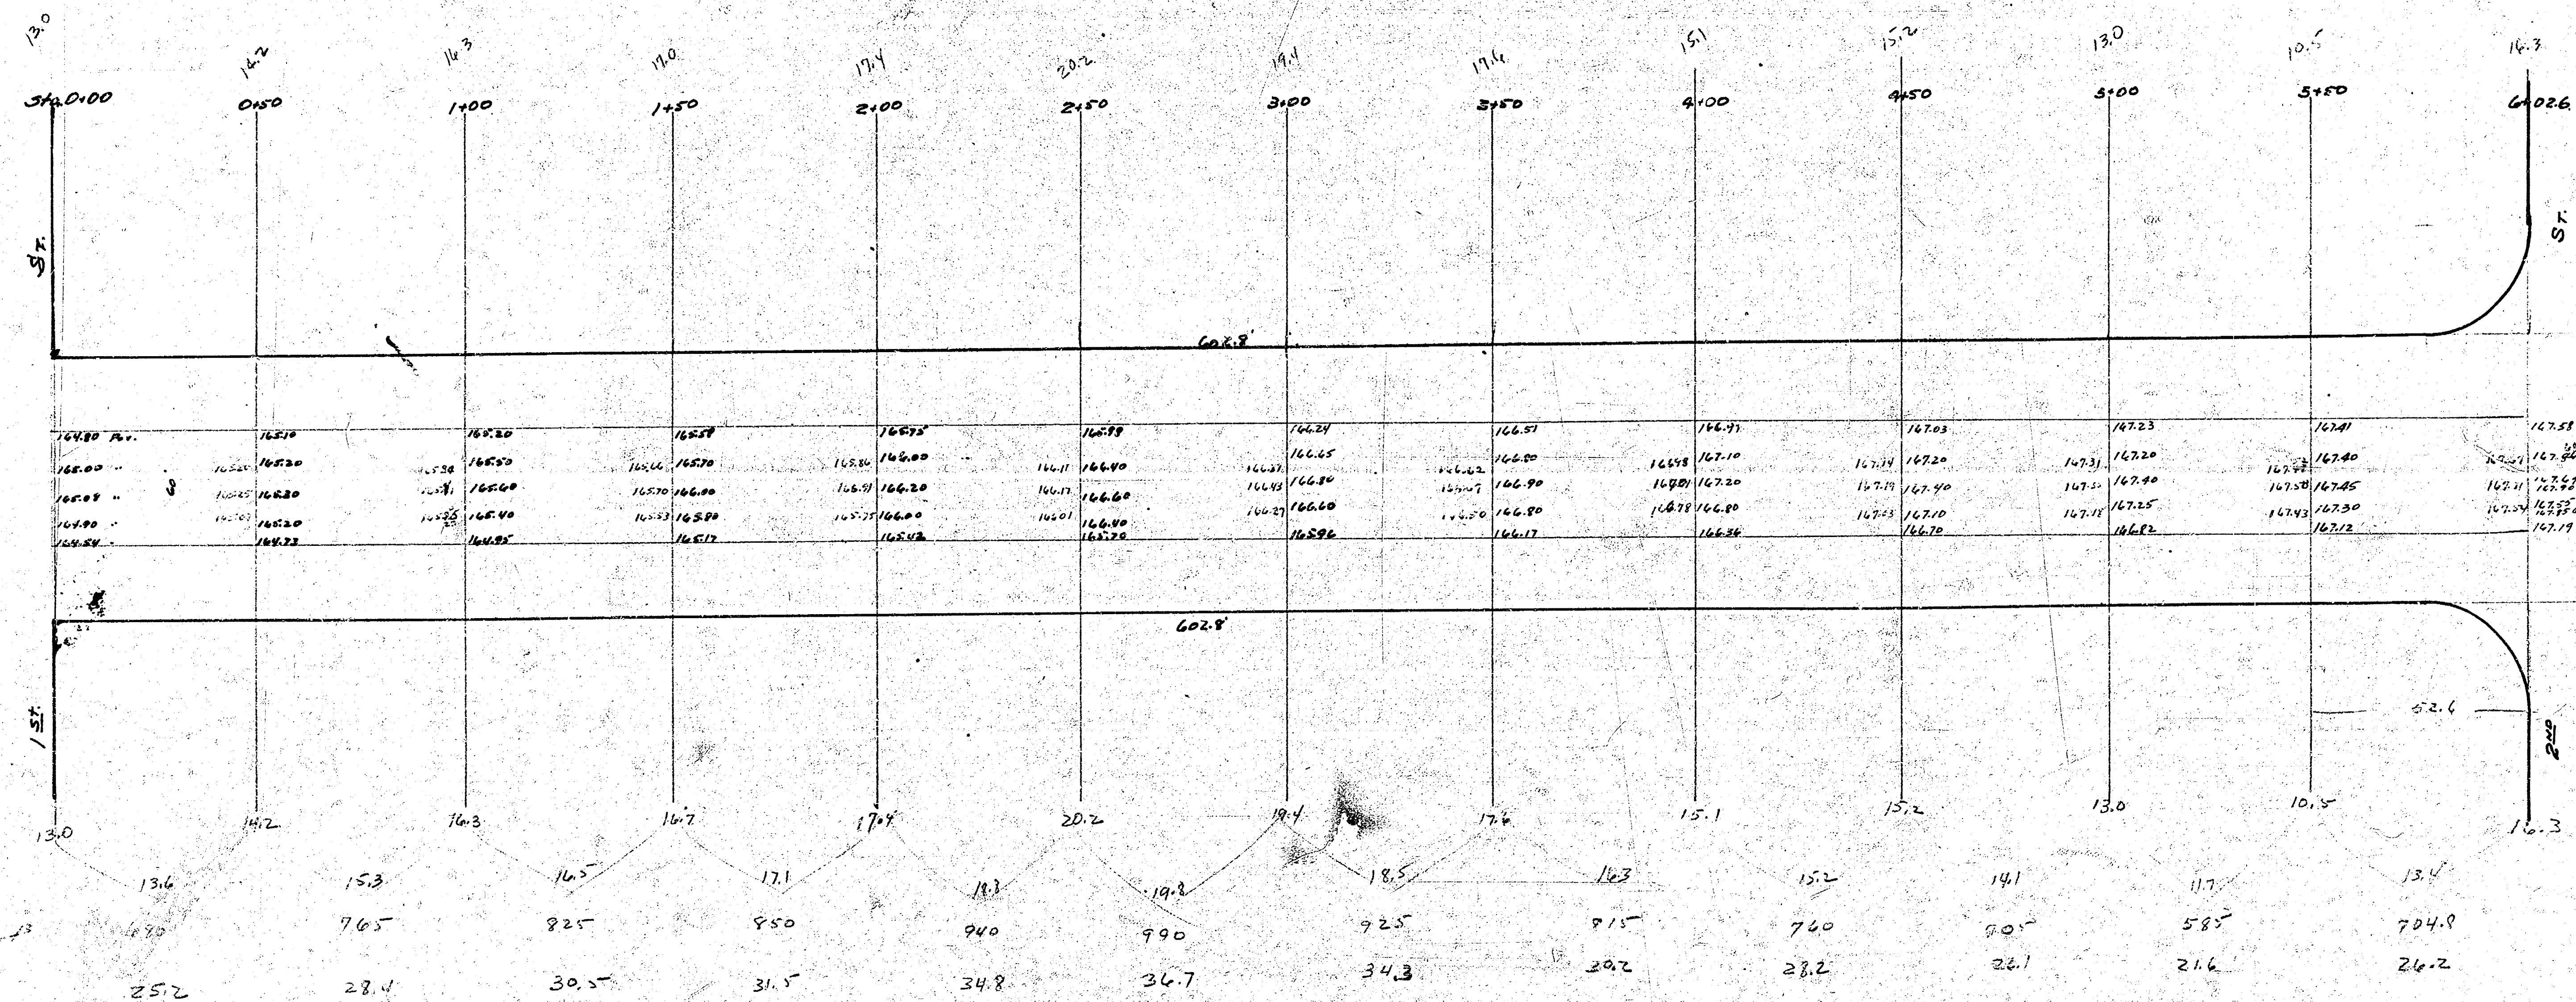

Point Run
 GLENDALE AVE
 N.L. 1ST
 SL 2ND
 1900

Prod 333.7 - 330 = 3.7