

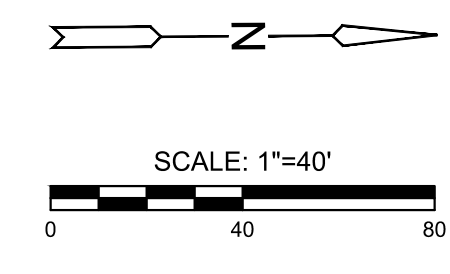


J:\PROJECTS\2021\101010867_ACFL_SPIRIT MILITARY\00_210857_CADD\SHOTS\08_06-BUBBLE MAP.DWG
 PLOTTED: Monday, June 16, 2025 @ 11:24AM
 ©2025 MKEC ENGINEERING, INC. ALL RIGHTS RESERVED. WWW.MKEC.COM. THESE DRAWINGS AND THEIR CONTENTS, INCLUDING, BUT NOT LIMITED TO, ALL CONCEPTS, DESIGNS, & DETAILS ARE THE EXCLUSIVE PROPERTY OF MKEC ENGINEERING, INC. (MKEC), AND MAY NOT BE USED OR REPRODUCED IN ANY WAY WITHOUT THE EXPRESS CONSENT OF MKEC.

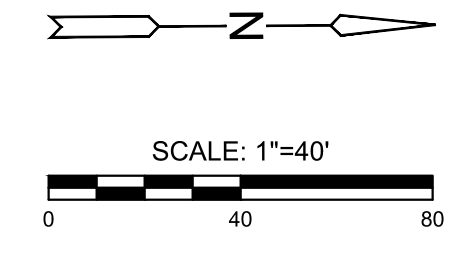

WATER POINTS			
Point #	Northing	Easting	Desc.
3009	1658802.39	1665738.75	VERT. BEND
3010	1658843.74	1665738.11	VERT. BEND
3011	1658847.55	1665738.05	BEND
3012	1659090.22	1665834.23	BEND
3013	1659100.21	1665834.08	VERT. BEND
3014	1659113.08	1665833.88	VERT. BEND
3015	1659136.37	1665833.52	FH
3016	1659417.04	1665829.22	DEFLECTION
3017	1660279.72	1665803.77	FH
3018	1660282.70	1665803.74	VALVE
3019	1660561.08	1665800.44	FH
3020	1660564.08	1665800.40	VAVLE
3021	1660579.67	1665800.22	BEND
3022	1660591.57	1665804.98	BEND
3047	1659139.40	1665833.48	VALVE

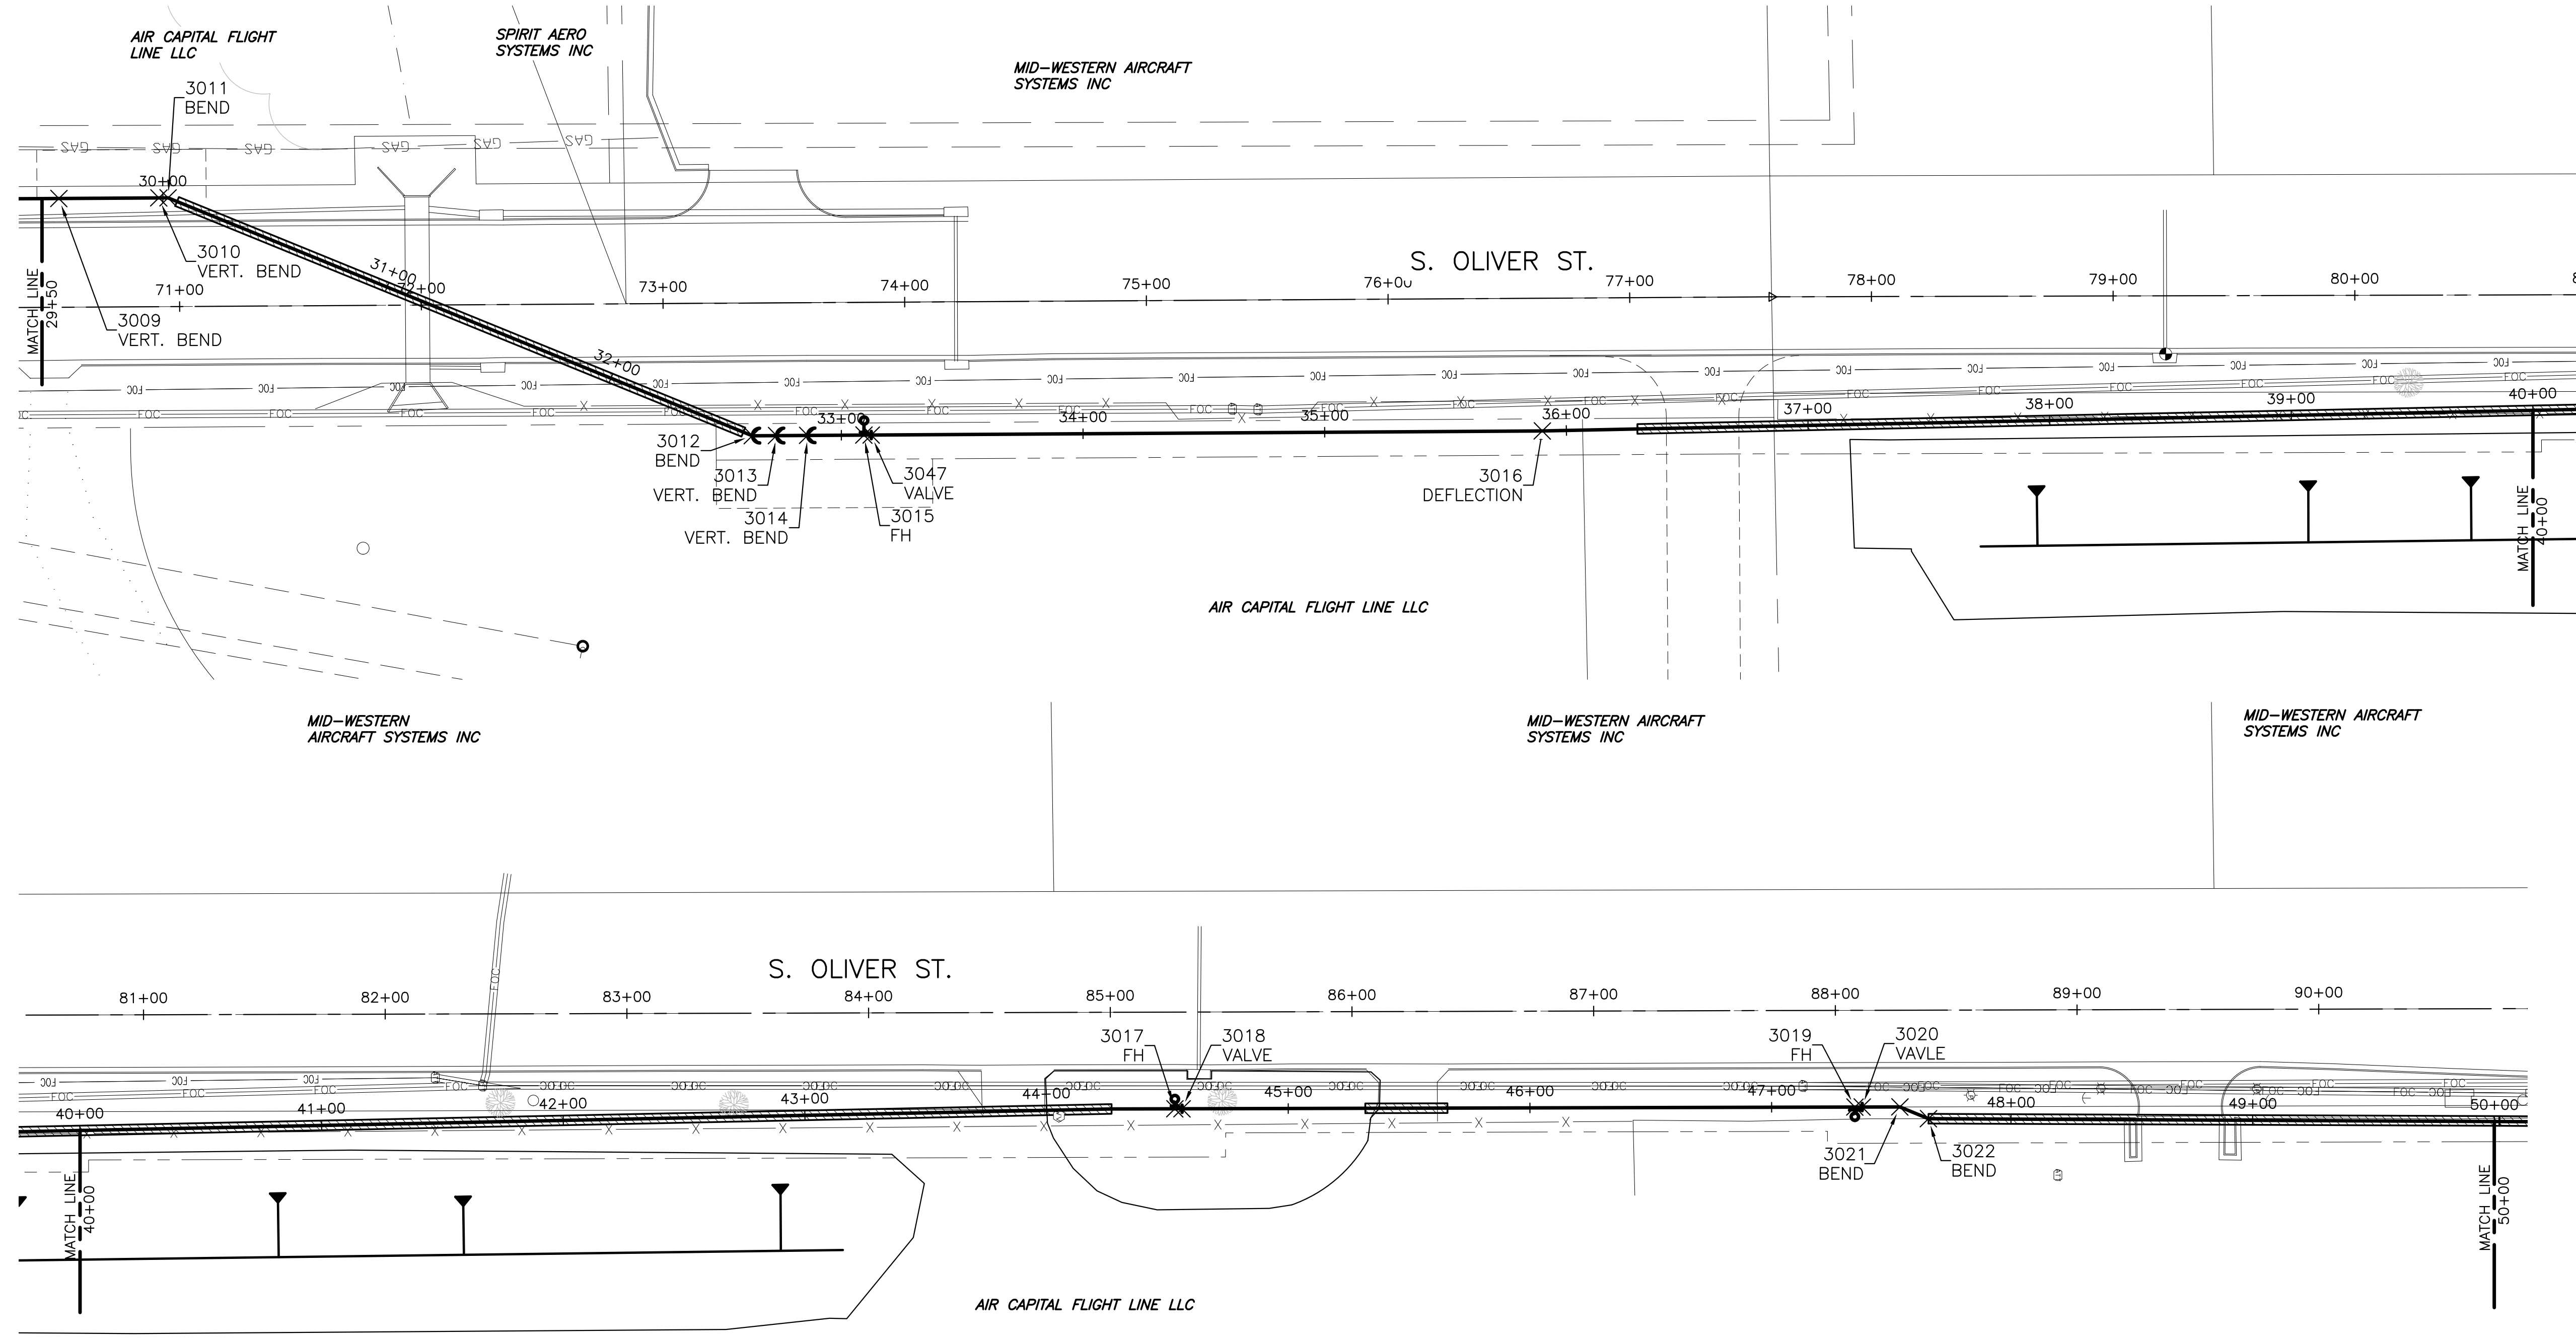

WATER EXTENSION PLANS FOR
ACFL WATER EXTENSION
 WICHITA, KS

BUBBLE MAP SHEET 2

PROJECT NO. 210857

SCALE 1"=40'

DRAWN	DESIGNED	CHECKED
KM	KM	DK

01 ISSUED FOR CONSTRUCTION 06/13/25

SHEET NO. 09 OF 20