


GORDON AVE 66' Gr. N.L. DOUGLAS to SL 1st
 B.M. Elev. 114.82 from Thin C. Gordon & Son
 " " in Top of Hydrant NW. of Paul 2nd
 " " in Reuler App. N.W. of Gordon N.S. Douglas
 NE cor. Conc. Arch. E.S. N.W. of Gordon 1st

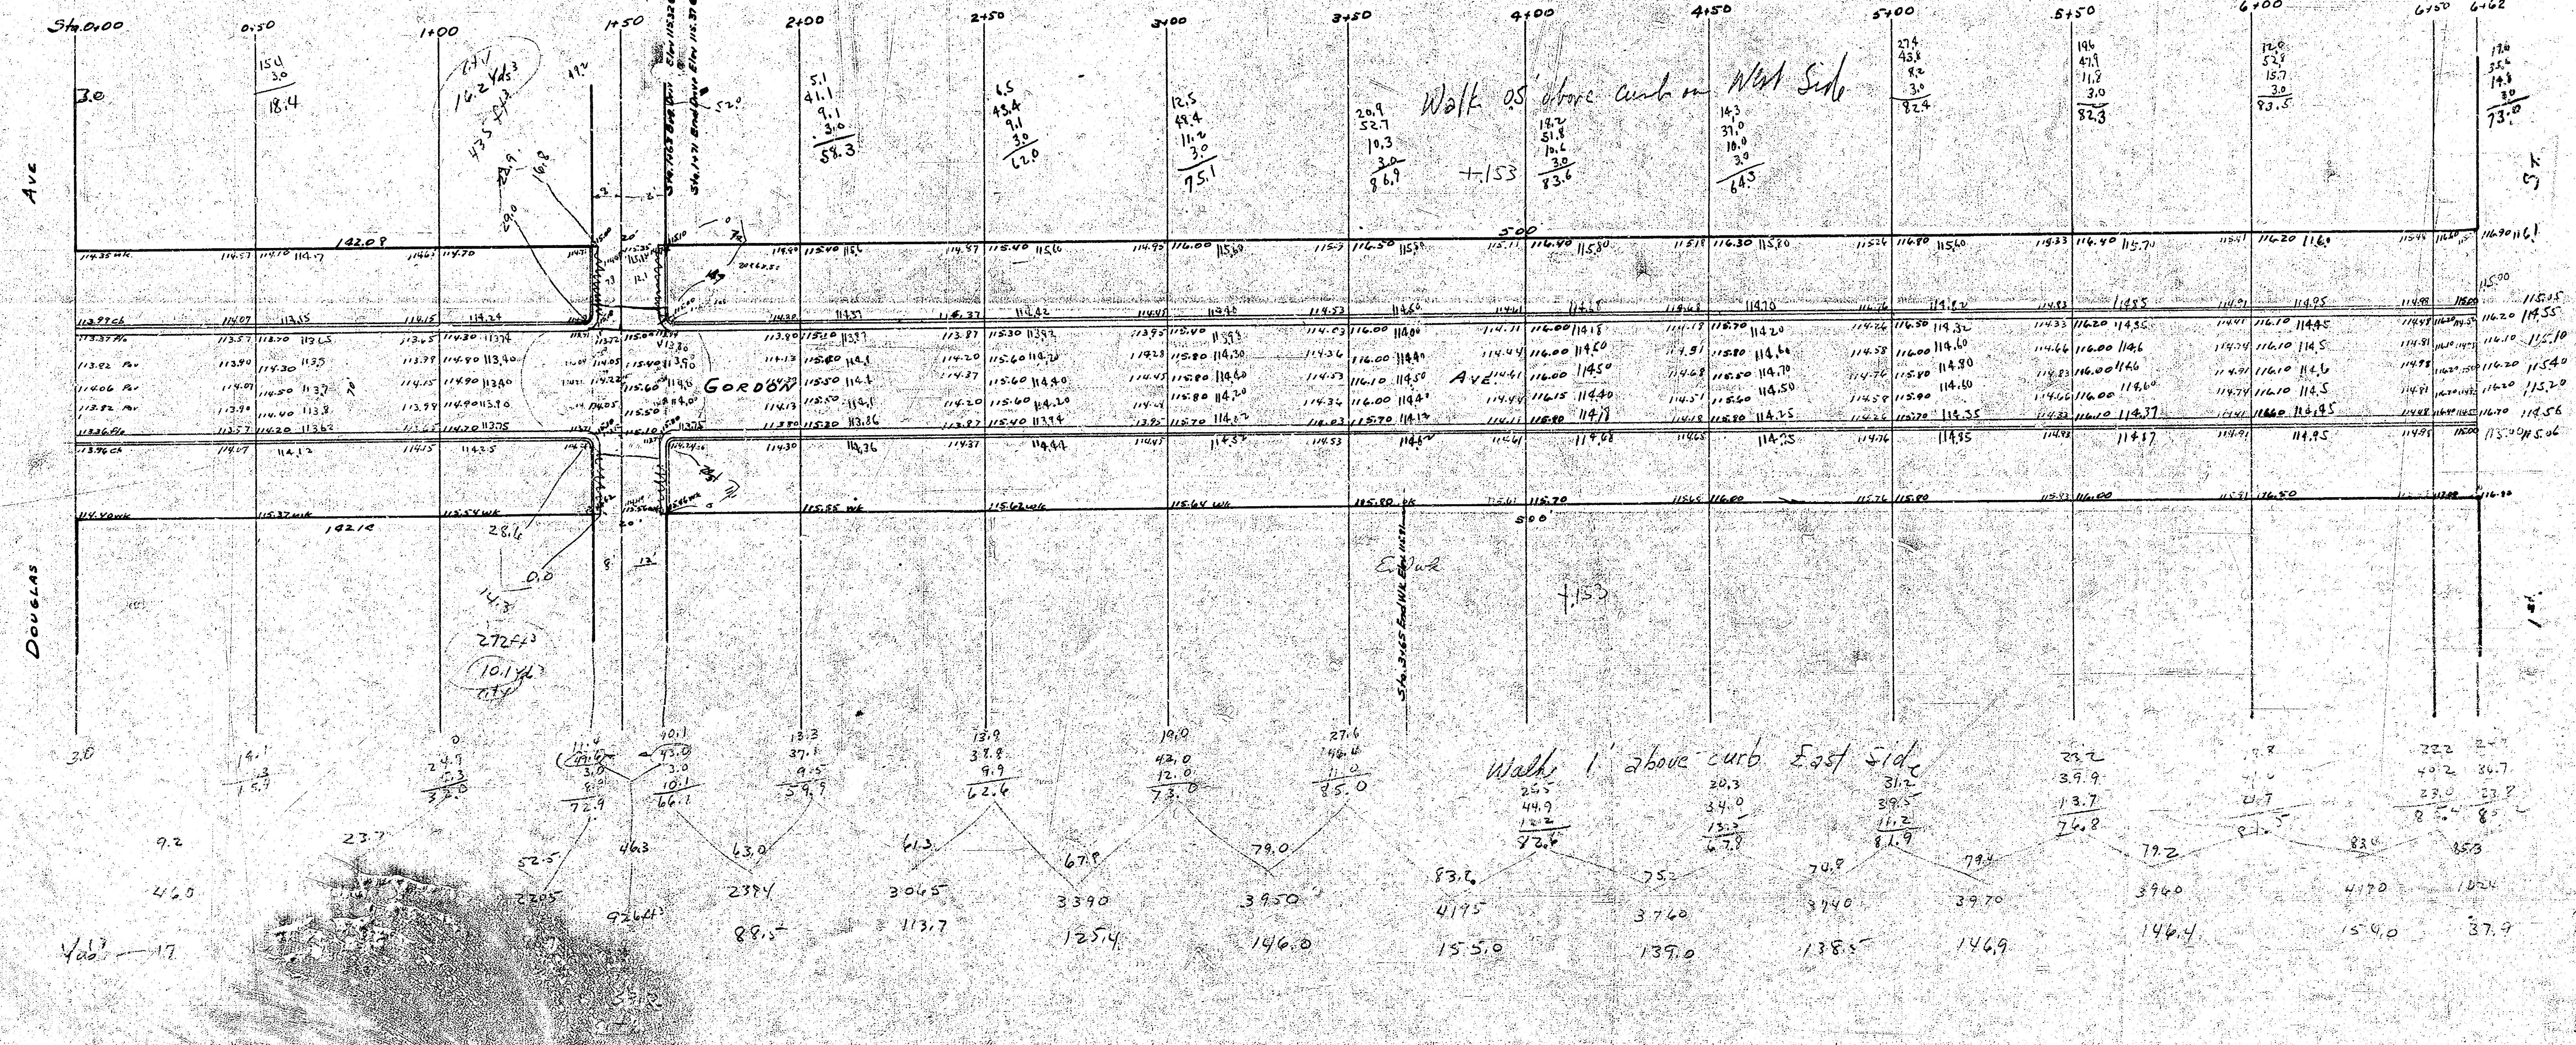

Property 15.83.8
