
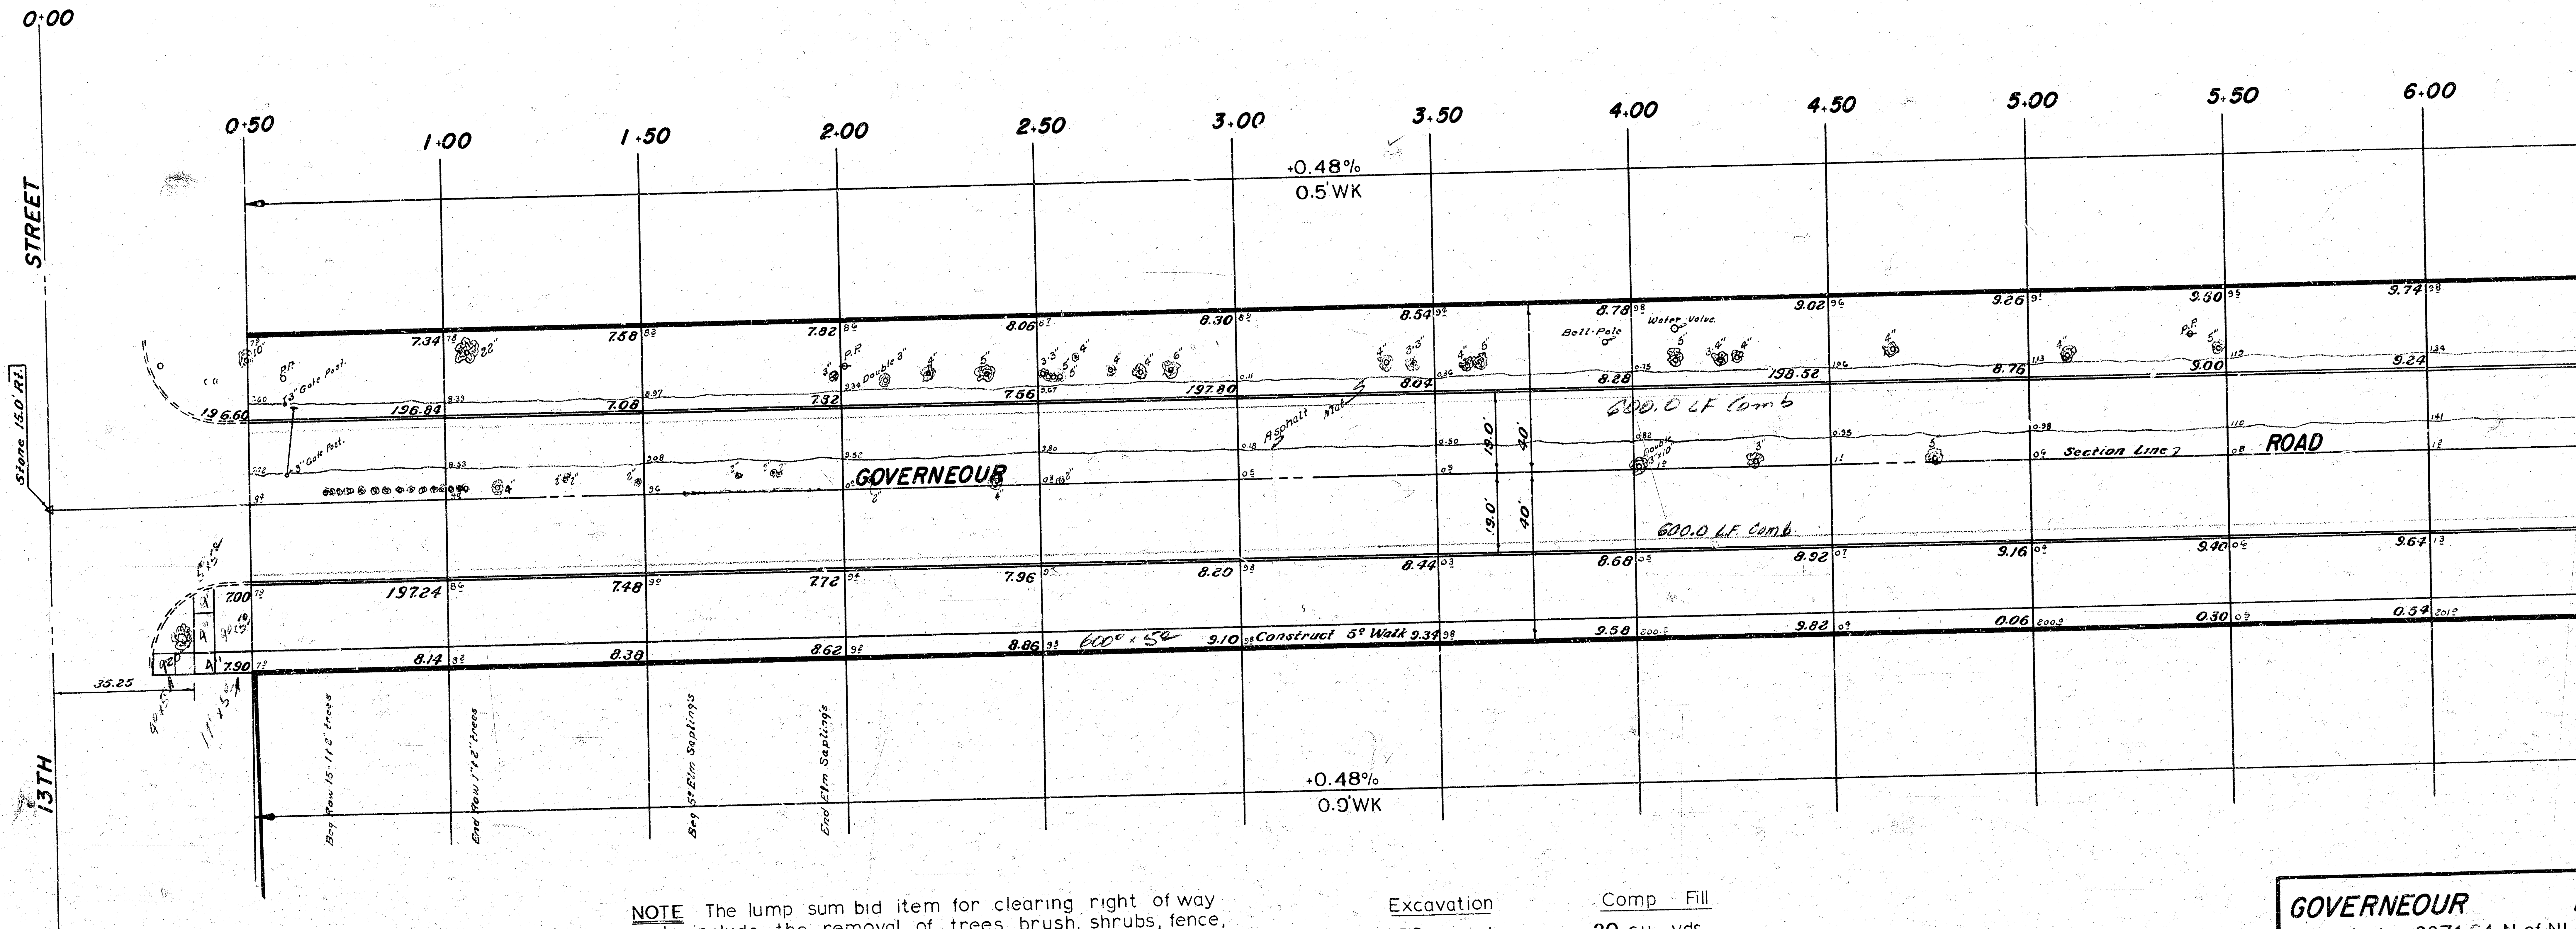


Base Line is 15.0' West of ∇ Gouverneur Rd.

B.M.=198.36 R.R. Spike N.W. Side Large Elm Tree on N.E. Cor Gouverneur & 13th ST.
 B.M.=193.96 'X' Cut Top E.cb. Gretchen Ln. 10' S. of SL 13th ST.
 B.M.=201.38 R.R. Spike E.S. Bell Pole on W. Side Gouverneur Sta 7+33.
 B.M.=203.49 'X' Cut on Walk on W. Side Conc Base to Flag Pole on
 W. Side Coleman School.
 B.M.=204.48 'X' Cut Top S.cb of Extreme North Entrance to Coleman Junior
 High School. E. Side Gouverneur.

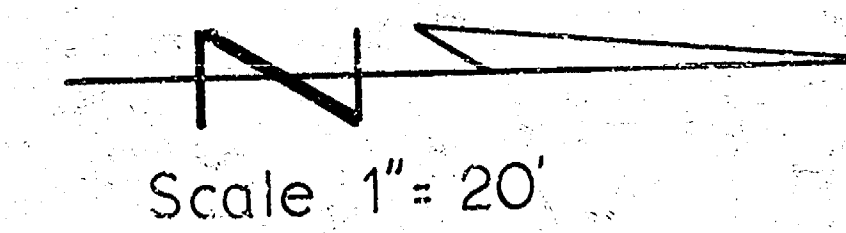

NOTE The lump sum bid item for clearing right of way is to include the removal of trees, brush, shrubs, fence, asphalt mat surface, etc in the 80.0' Right of Way between 0+30 and 23+25


NOTE All Drives to be tied to pavement or gutter with #4 dowel bars 3.0' long.

Excavation
9,230 cu yds


Comp Fill
20 cu yds

GOVERNEOUR
 N.L.13th to 2274.64 N. of N.L.1
 34-2-38 AC.
38' PAVEMENT FC. -
 City of Wichita K
 B.E. Smith City Eng
 Date Private Co


*School Elev
Floor 201.93*

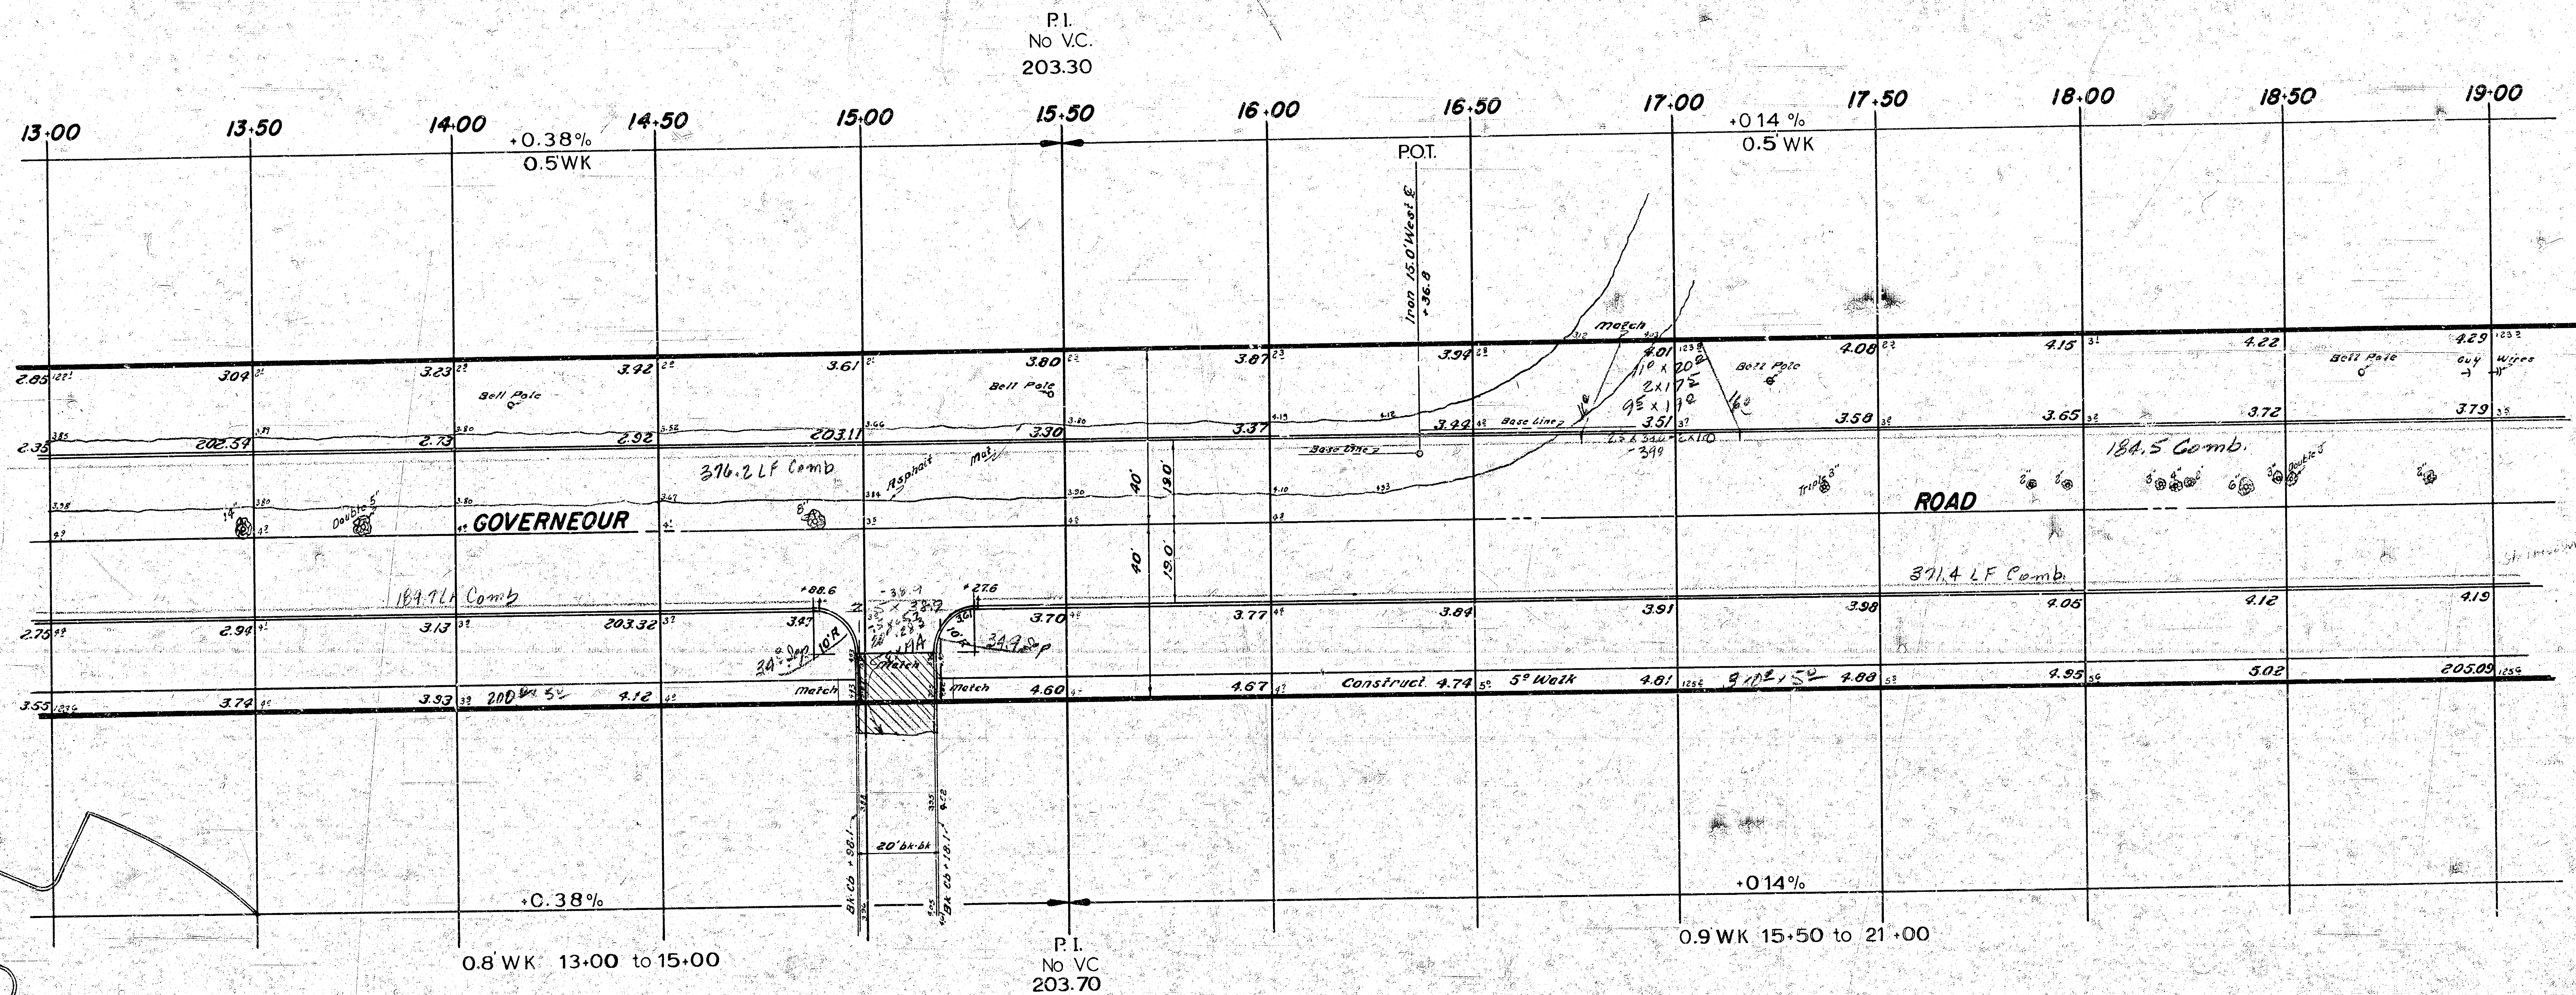


38'-0" ASPHALTIC CONCRETE

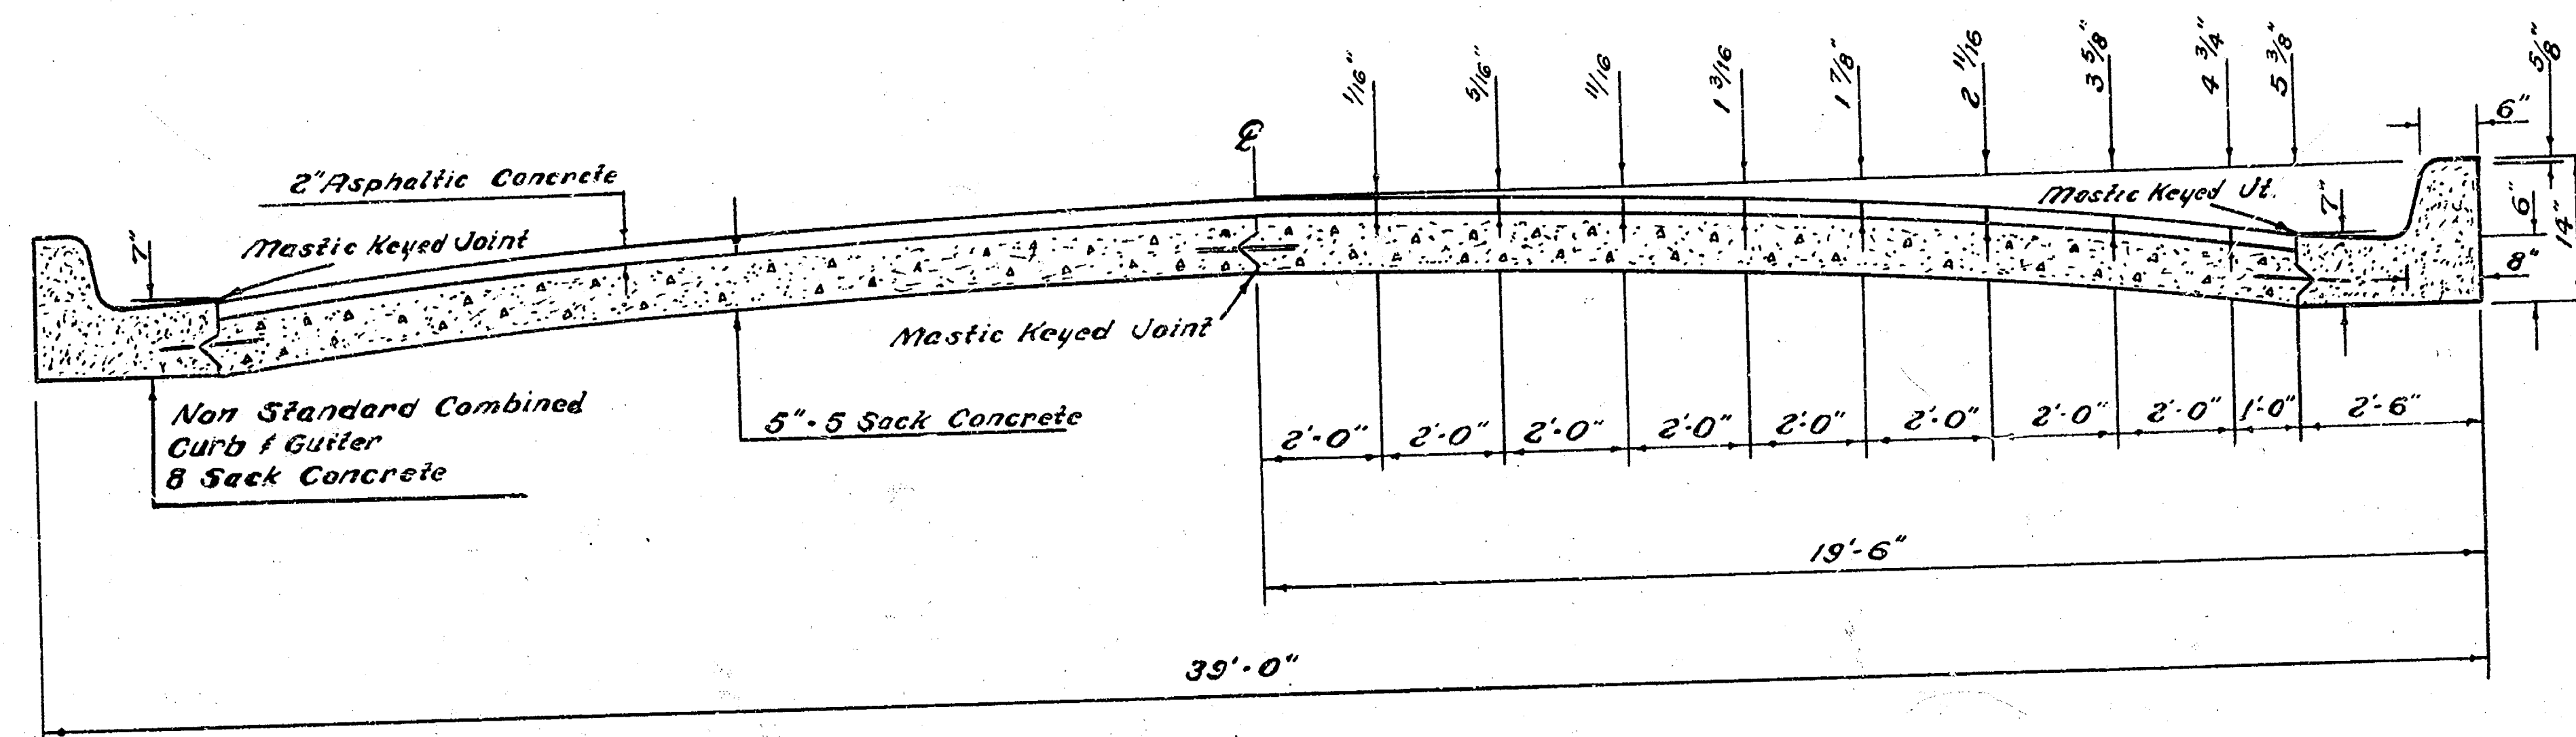

TYPICAL SECTION
Not to Scale

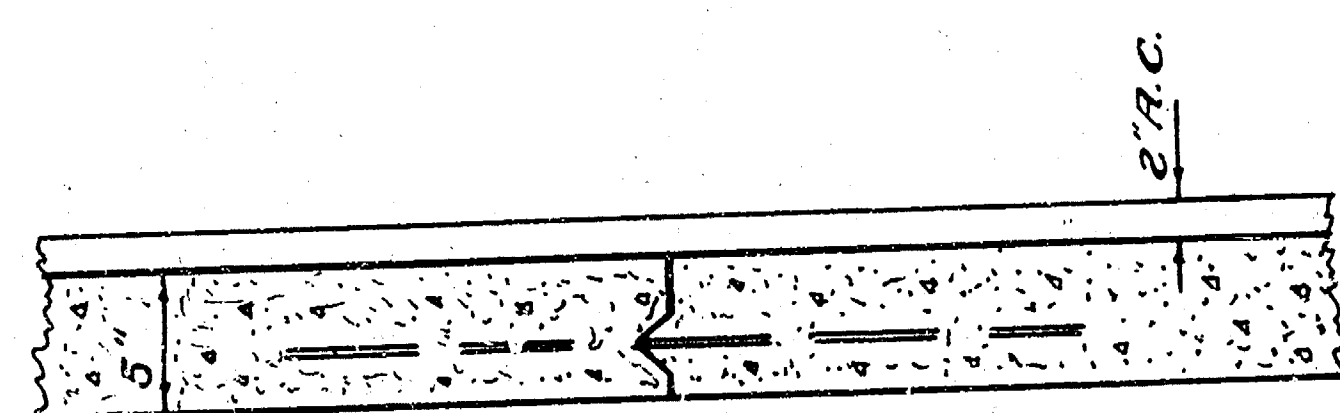

DETAIL of KEYED JOINT
no scale

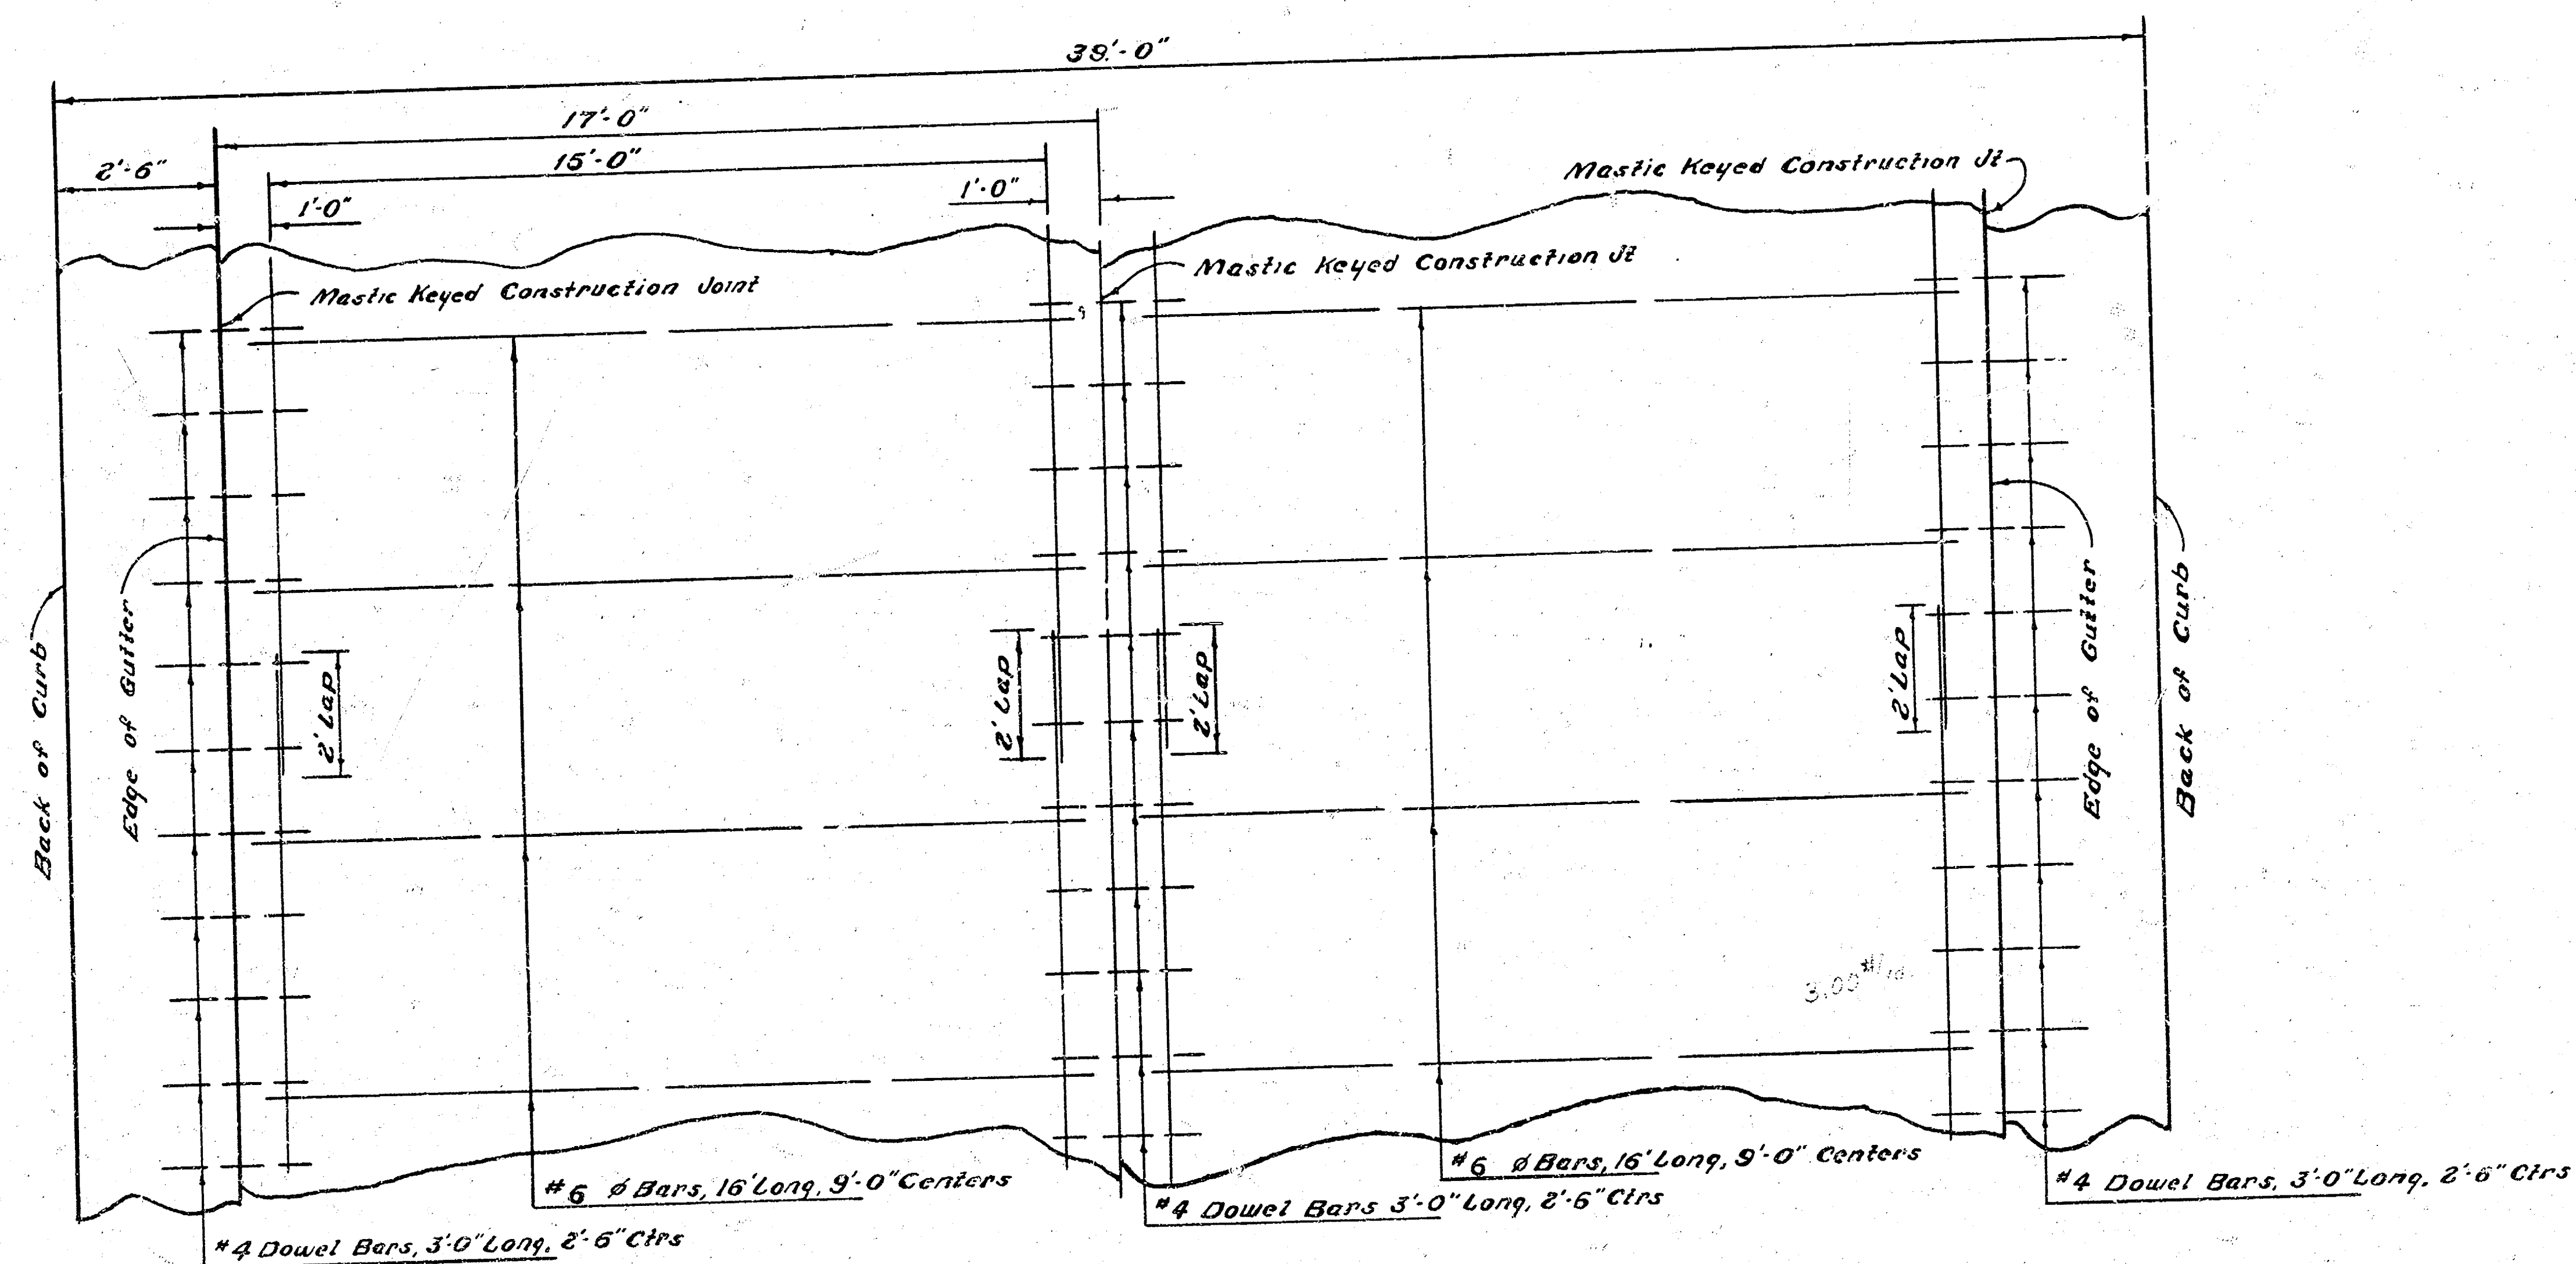

STEEL PATTERN
Not to Scale
Use #6 ϕ Bars Except
Where Noted

GOVERNEUR ROAD
N.L. 13TH TO 22ND AVE N OF N.L.