


B.M. 96.69 S.E. COR. CONC. PORCH HOUSE NO 2719 LULU  
 B.M. 94.40 "6" IN GLOBE AT CENTER OF WALK 5' BACK OF W. CB. AT VICTORIA & N. DENKER  
 STATIONING N.L. GRABER

- 002 BEG. EXISTING PVT
- 100 E.L. LULU IRON N.S.
- +107 BEG. 15" CONC. ENT. PIPE 15.5'S
- +135 & 8.4' CONC. DRIVE 0.2'S
- +149 END 15" CONC. ENT. PIPE 165'S
- +23 WATER METER 4.5'S
- 144 BEG. ROW FC. POSTS 51' 3 NO FC
- 145 BEG 18" CONC. ENT. PIPE 15'S
- 170 & 8.4' CONC. DRIVE 20.1' N
- 172 BEG. ABANDONED SAND PIT AT SRL
- 177 END 18" CONC. PIPE 15'S
- 180 WATER METER 3.5'S
- 120 BEG 15" CONC. ENT. PIPE 15'S
- 126.5 & 8.5' CONC. DRIVE 1.8' N
- +32 END CONC 15" ENT. PIPE 15'S
- 138 WATER METER 4.7'S
- 174 BEG 18" CONC. ENT. PIPE 15'S
- 180 & 8.4' CONC. DRIVE 24' N
- 186 END 18" CONC. ENT. PIPE 15'S
- 188 BEG. CONC. BLOCK RET. WALL 10'S
- 189 WATER METER 5'S
- 105 BEG WASH. S.S. OF C.M.P.
- 148 END CONC. BLOCK RET. WALL 10'S
- 171 27'x27' C.M.P. 14' TO 44'S
- 125 15" CONC. PIPE 00' TO 8.8'S
- 123 END WASH. 5' END C.M.P.
- 135 BEG 15" CONC. ENT. PIPE 14'S
- 139 & 8' CONC. DRIVE 51' N
- 147 END 15" CONC. ENT. PIPE 140'S
- 144 WATER METER 22'S
- 145 END ABANDONED SAND PIT ON SRL
- 188 BEG 15" CONC. ENT. PIPE 14'S
- 193.5 & 28' CONC. DRIVE 14' N
- 100 END 15" CONC. ENT. PIPE 14'S
- 101 WATER METER 20'S
- 142 BEG 15" CONC. ENT. PIPE 130'S
- 177 8.0' CONC. DRIVE 50' N
- 158 END 15" CONC. ENT. PIPE 13'S
- 157 WATER METER 34'S
- 186 END ROW OF FC. POSTS 38'S
- 100 BEG 4' CHAIN LINK FC. 58.5'S
- 140 BEG 15" CONC. ENT. PIPE 135'S
- 145 & 8.5' CONC. DRIVE 2' N
- 122 END 15" CONC. ENT. PIPE 135'S
- 123 WATER METER 25'S
- 161 END CHAIN LINK FC. 59.2'S
- 146 BEG CONC. ENT. PIPE 130'S
- 173 & 8.5' CONC. DRIVE 8' N
- 178 END 15" CONC. ENT. PIPE 18'S
- 186 WATER METER 6.7'S
- 182 BEG EXISTING PVT S.S.
- 185 W.L. VICTORIA
- 187 BEG EXISTING PVT N.S.

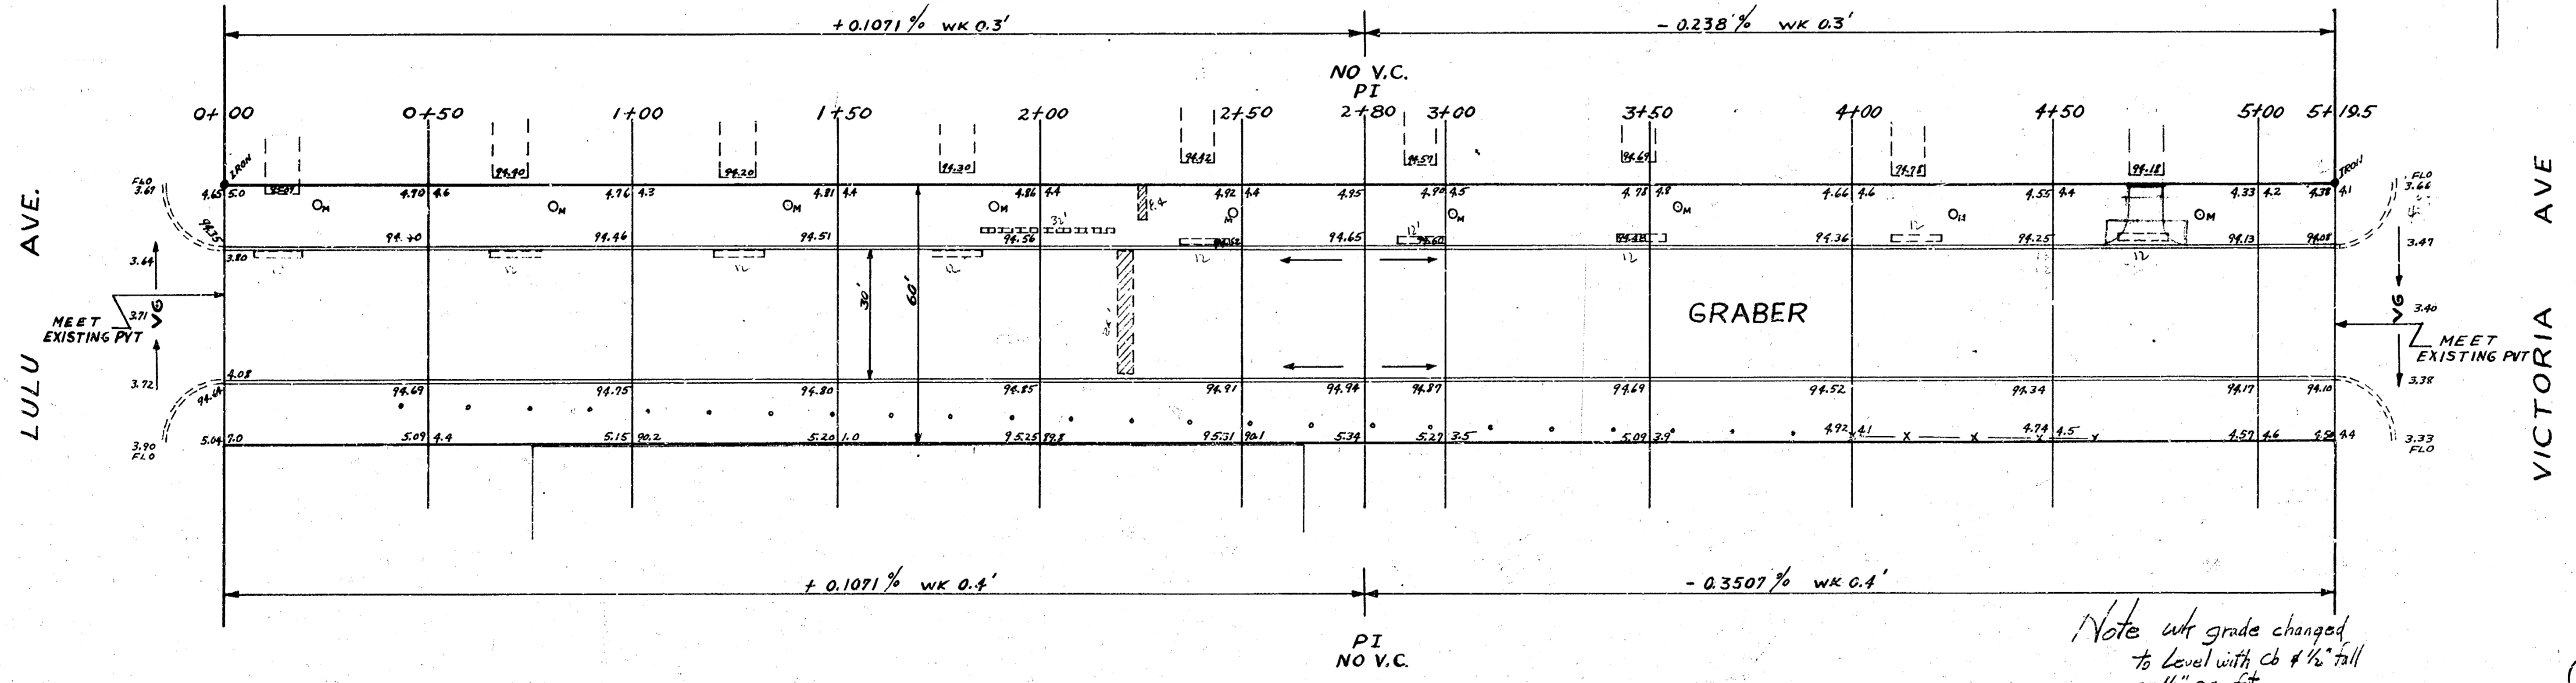

Surveyed by B.M. 96.69  
 Checked by S.E. SMITH  
 Date 3/15/54

NOTE: TO CONTRACTOR & FIELD ENG.  
 ENTRANCE PIPE WILL BE DISPOSED OF IN  
 ACCORDANCE WITH INSTRUCTION OF DIRT  
 CHECKER. & REMOVE EXISTING PIPES AT STA 2+21 & 2+25

NOTE:  
 NO GRADES SET BY CITY FOR DRIVES  
 ON N.S. OF GRABER, IMPOSSIBLE TO  
 MATCH DRIVES.

Note w/ grade changed  
 to level with cb & 1/2" fall  
 or 1/8" per ft  
 6/3/54 JRE

PROPERTY	
CUT	FILL
229.2	46.2
11%	14%
276.6 cu yds	50.8 cu yds



GRABER  
 E.L. LULU TO W.L. VICTORIA  
 30' CONC & CB  
 CITY OF WICHITA  
 BE SMITH CITY ENGINEER  
 MARCH 1954 PROJ NO C13-225

1/3