



EA '66

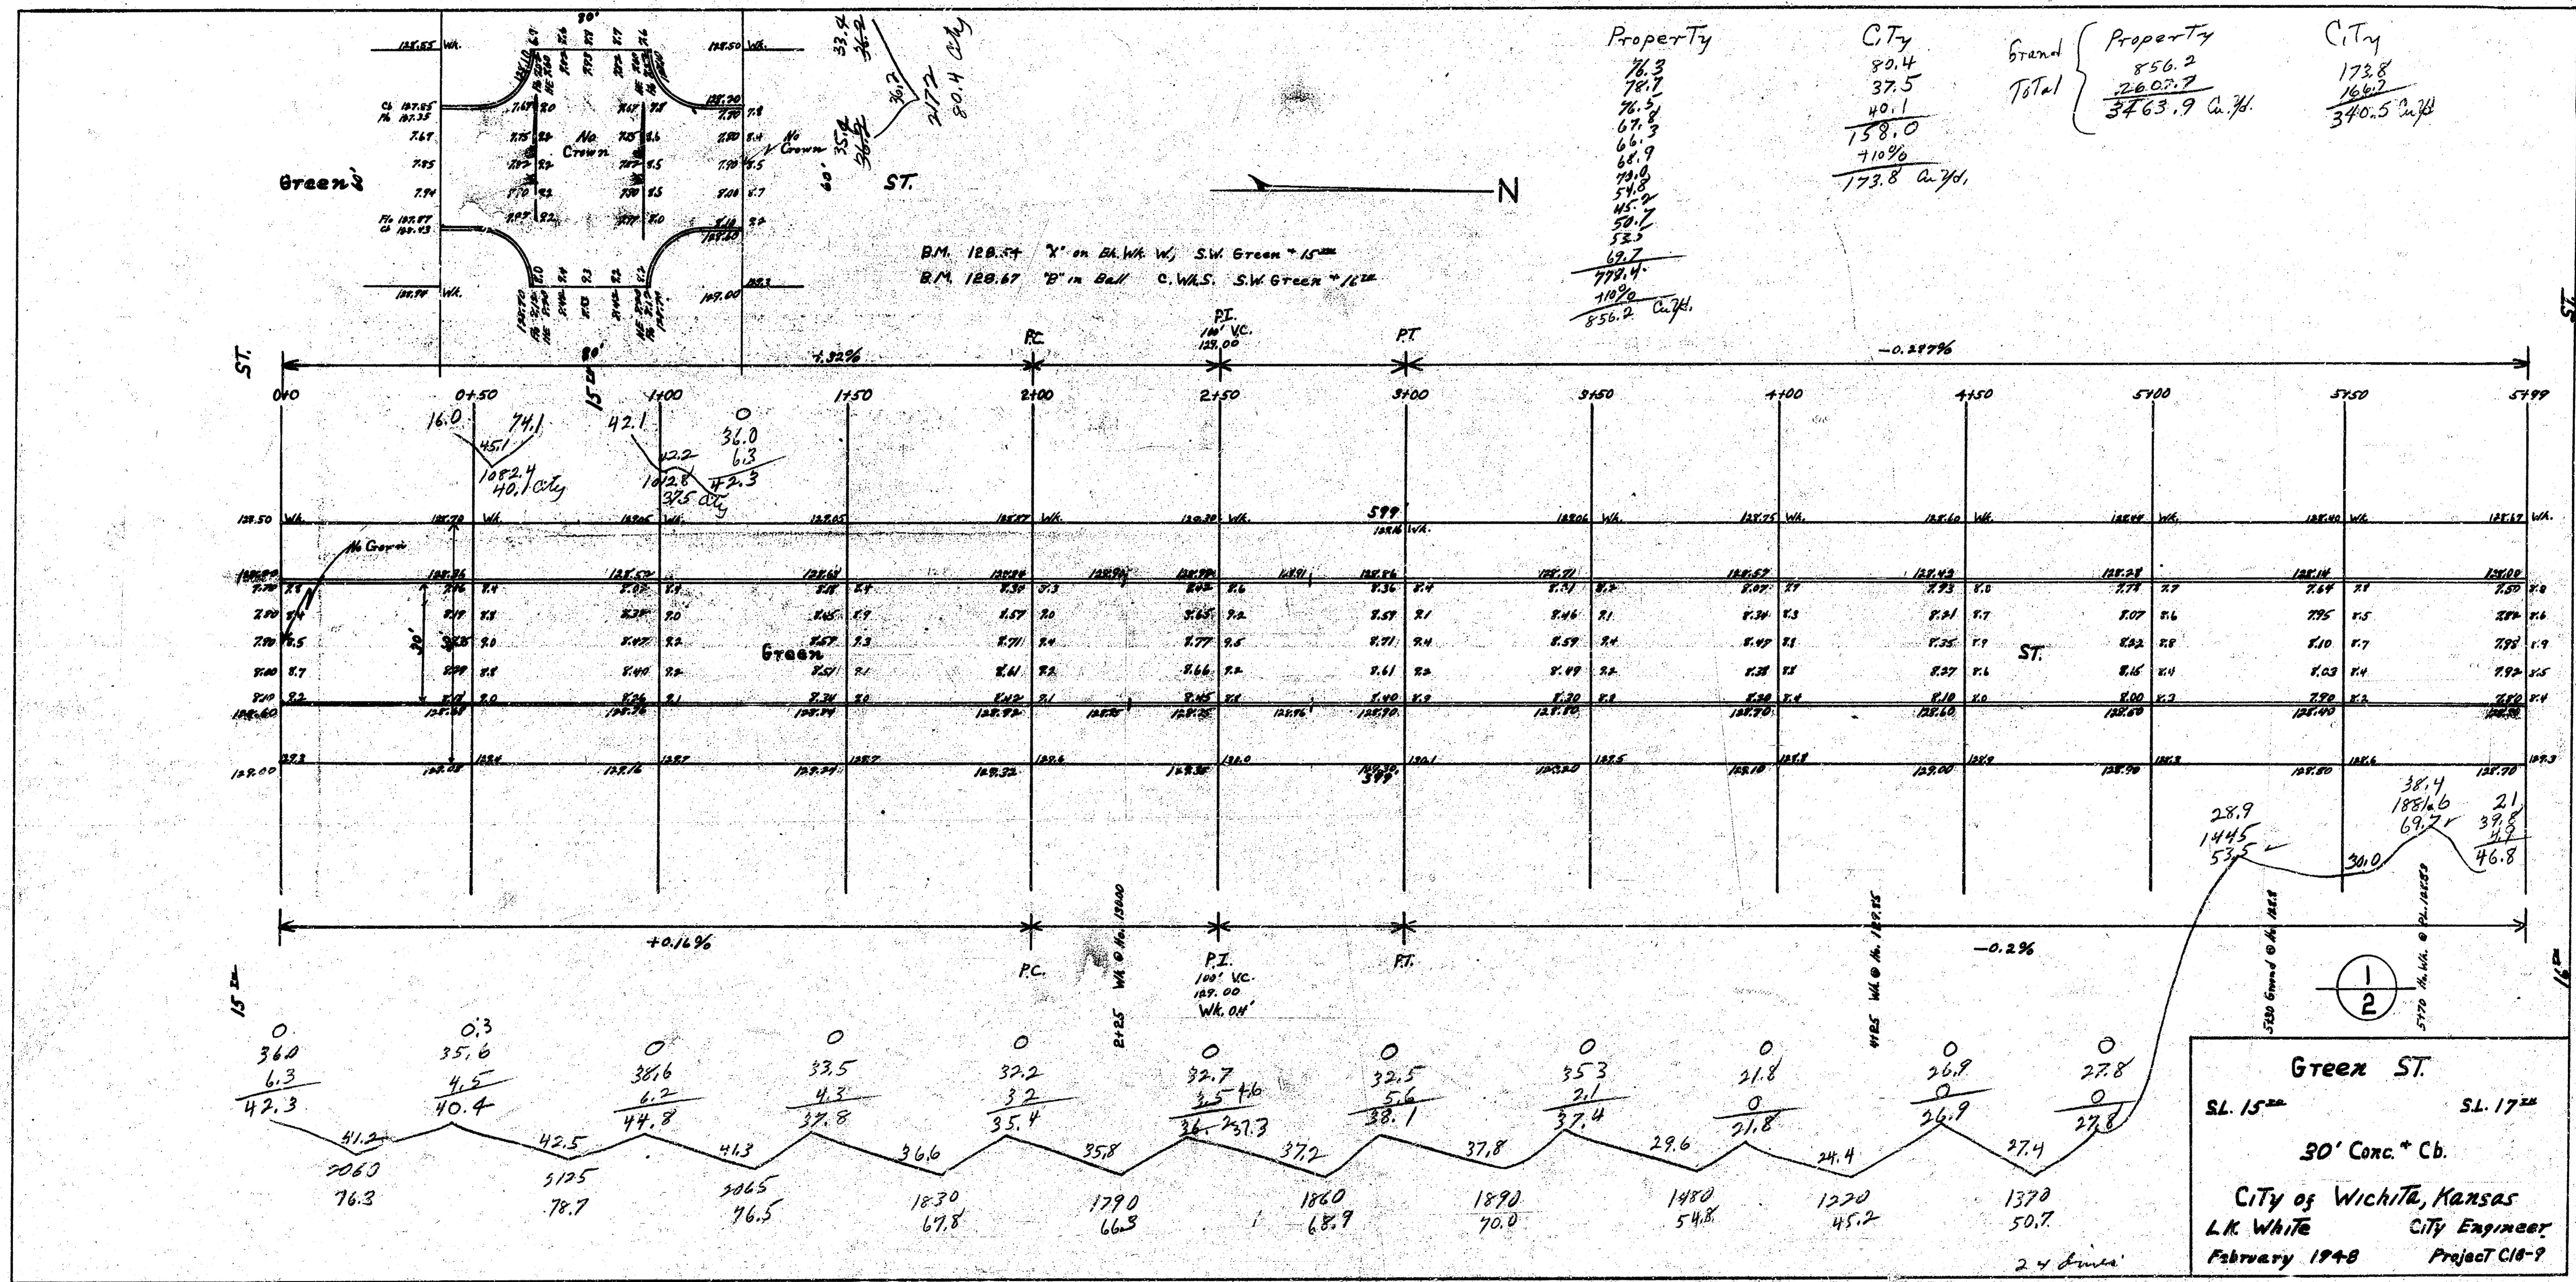

BA 46

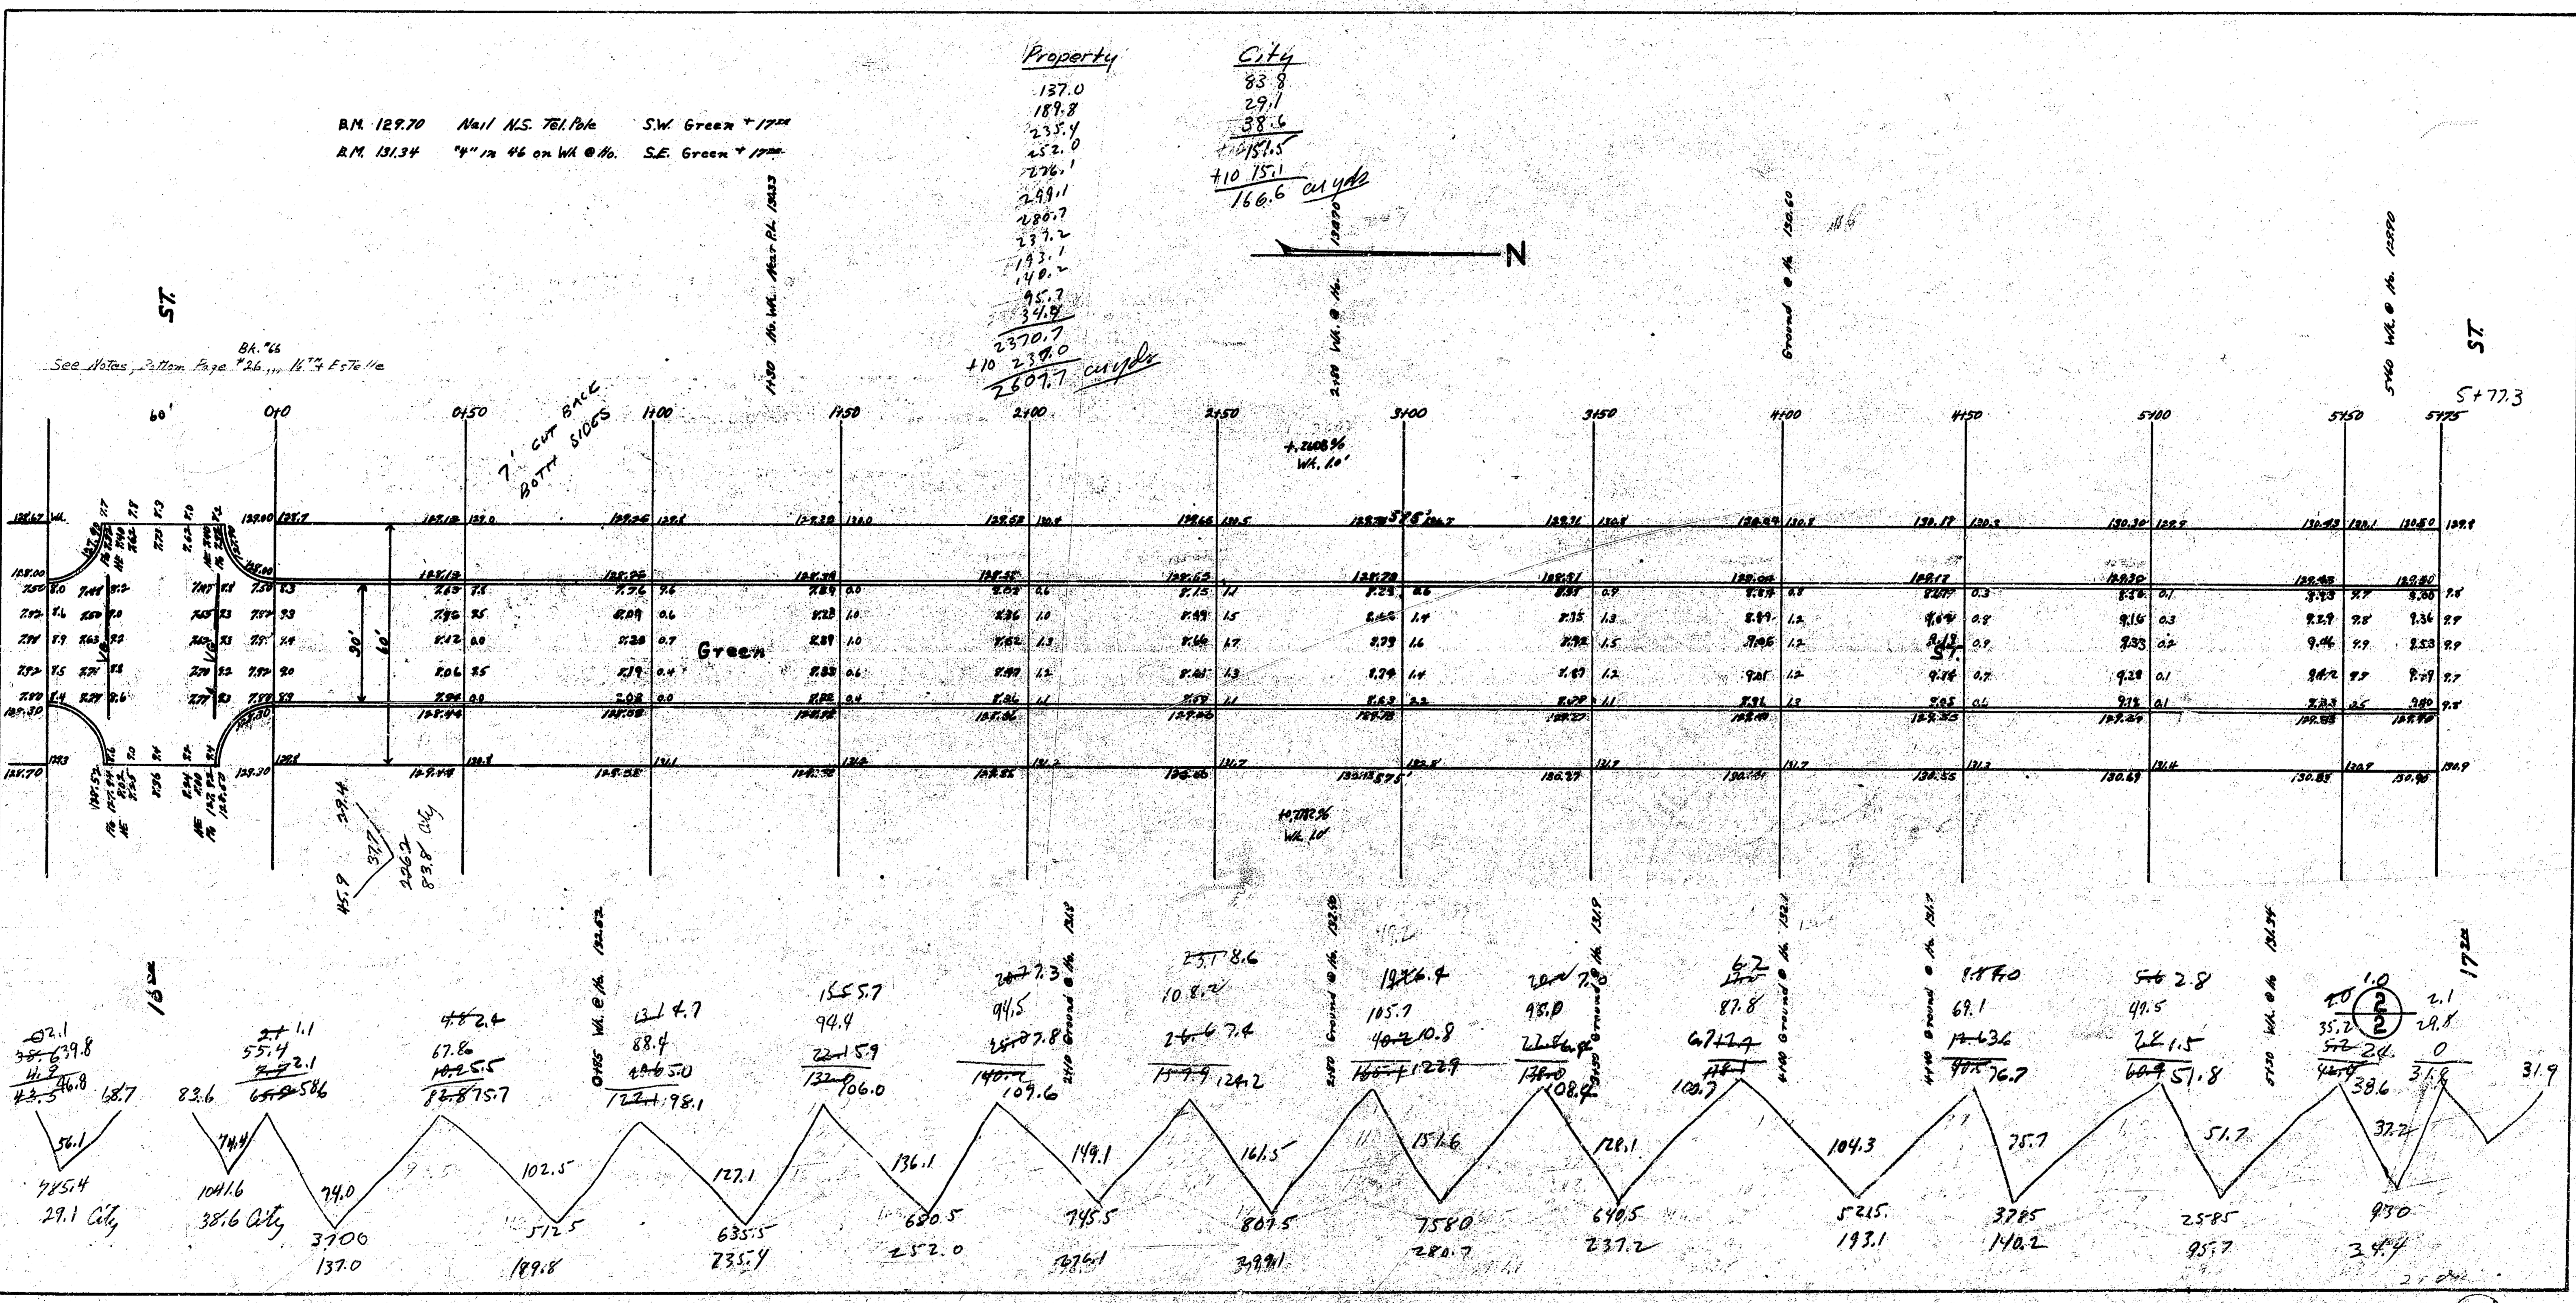

Property	City
137.0	83.8
187.8	29.1
235.4	38.6
252.0	148.15
276.1	+10.15.1
289.1	166.6 cu yds
288.7	
237.2	
237.1	
140.2	
145.7	
34.8	
2370.7	
+10.23.0	
2507.7 cu yds	


See Notes on Plan Page 26, 111, 112, 113,1000

4 155 1