

Destroyed



B.M. 100-38 "X" TOP COPING WEND N. HUBBARD CONC. CULVERT FUNSTON & GROVE

Property

85.0
15.4
73.3
85.3
121.3
121.1
145.7
170.4
165.6
154.4
145.7
144.2
71.0
139.3 C. 1d.

ST

ST

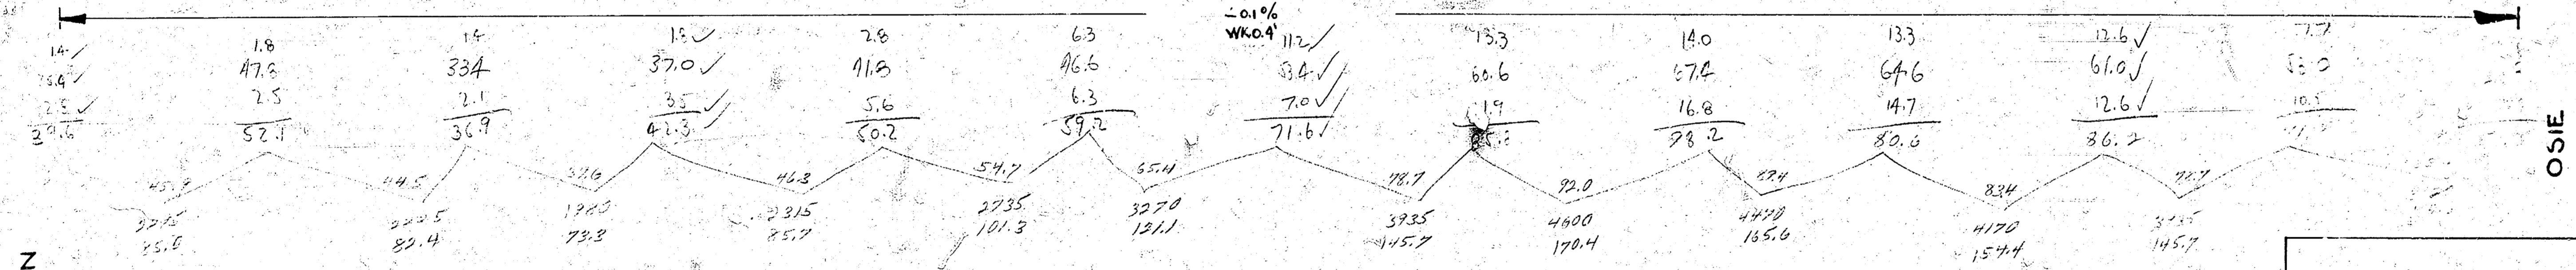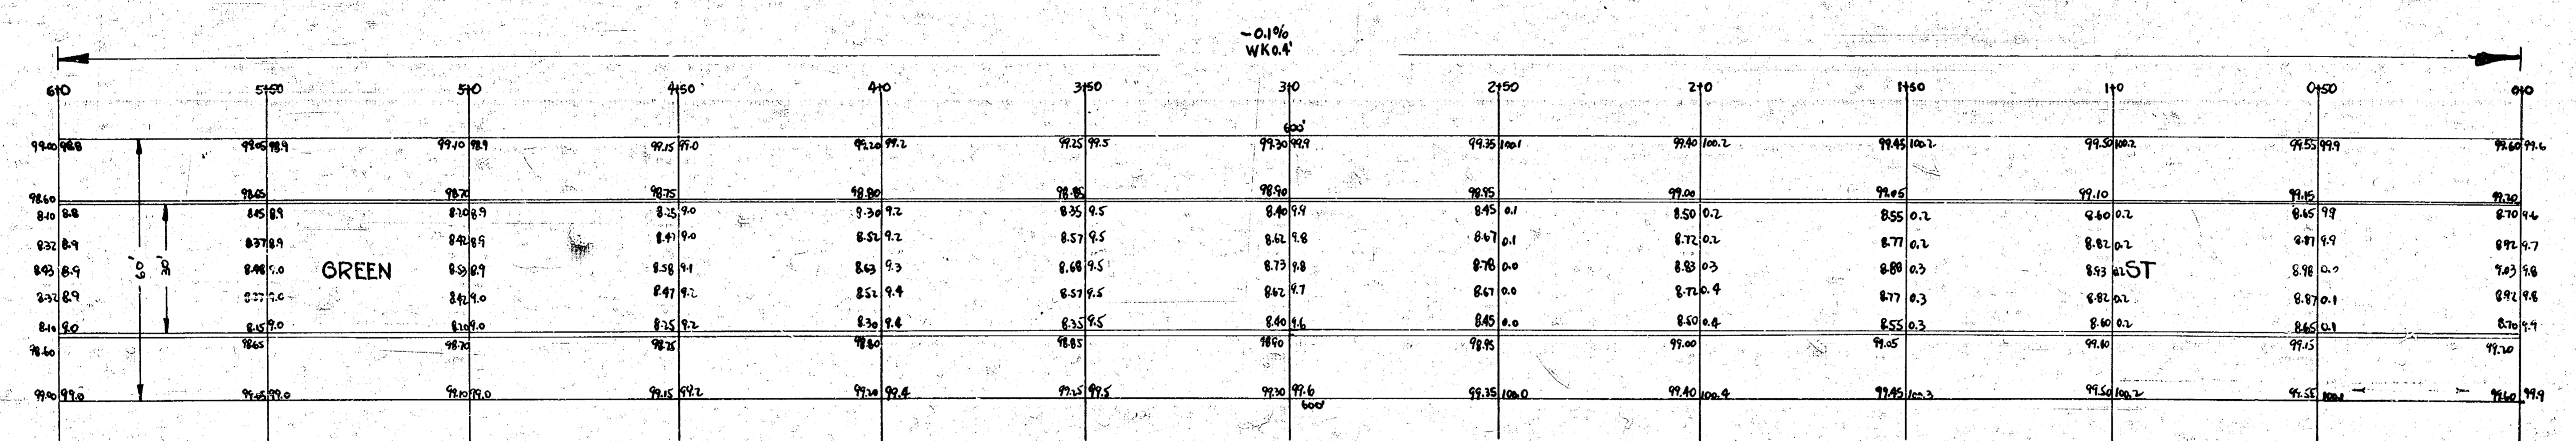

FUNSTON

OSIE

GREEN ST.
 N.L. FUNSTON - S.L. OSIE
 30' CONC. & CB.
 CITY of WICHITA, KANS.
 L.K. WHITE CITY ENGINEER
 APRIL 1949 PROJ. NO. C-19-56

4 5 1 (53)