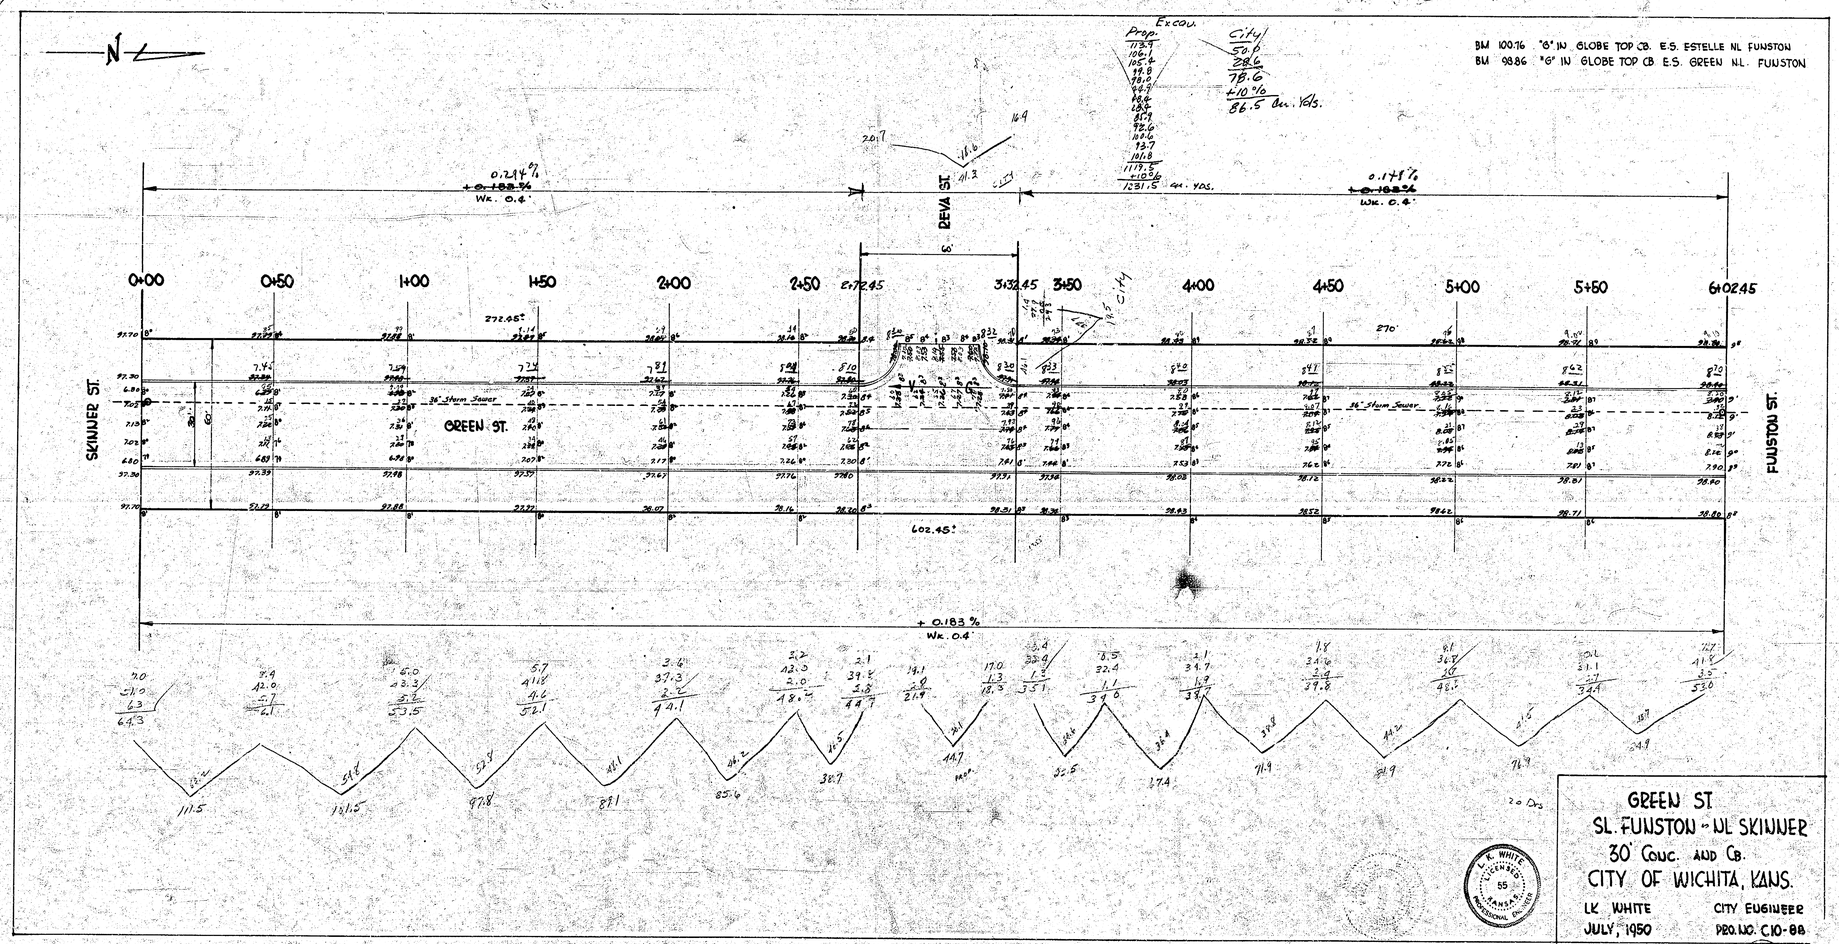

GREEN ST
SL. FUNSTON - WL SKINNER
30' CONC. AND CB.
CITY OF WICHITA, KANS.

LK WHITE — CITY ENGINEER
JULY, 1950 — PRO. NO. C10-88

L. K. WHITE
LICENSED
55
KANSAS
PROFESSIONAL ENGINEER

A 1 7 1 (30)