


B.M. 124.33 B in Burton App Wk. E. & Green N. 3. 134.  
 B.M. 126.45 Top S. Bolt Top Hyd. S.W. 14th & Green

N

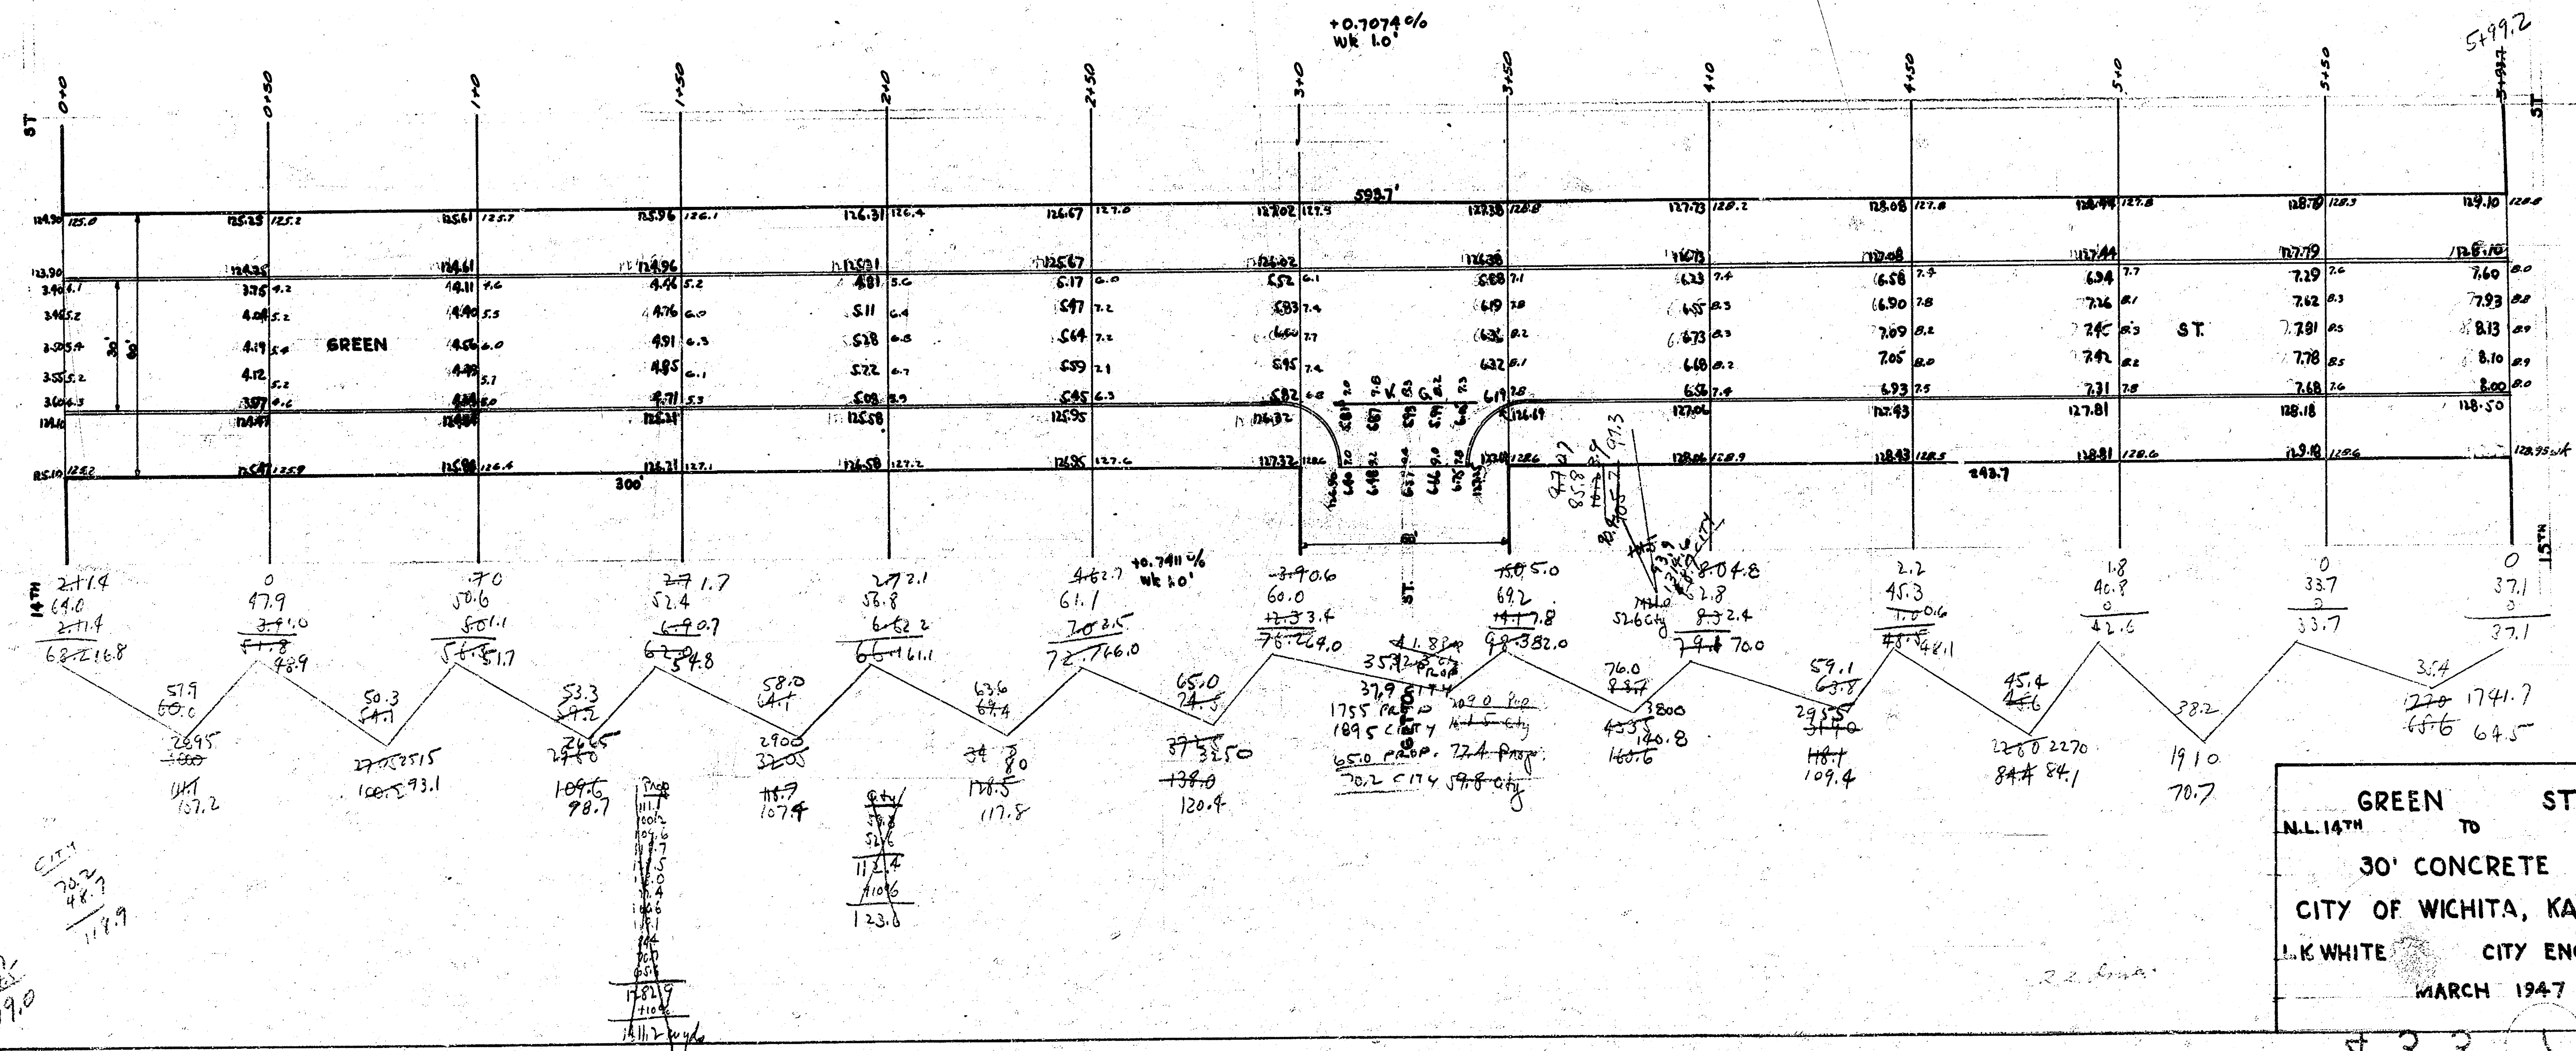

GREEN ST  
 N.L. 14TH TO S.L. 15TH  
 30' CONCRETE  
 CITY OF WICHITA, KANSAS  
 L.K. WHITE CITY ENGINEER  
 MARCH 1947