B.M. 129.70 Nail N.S. Telephone Pole southwest corner 17th and Greert.

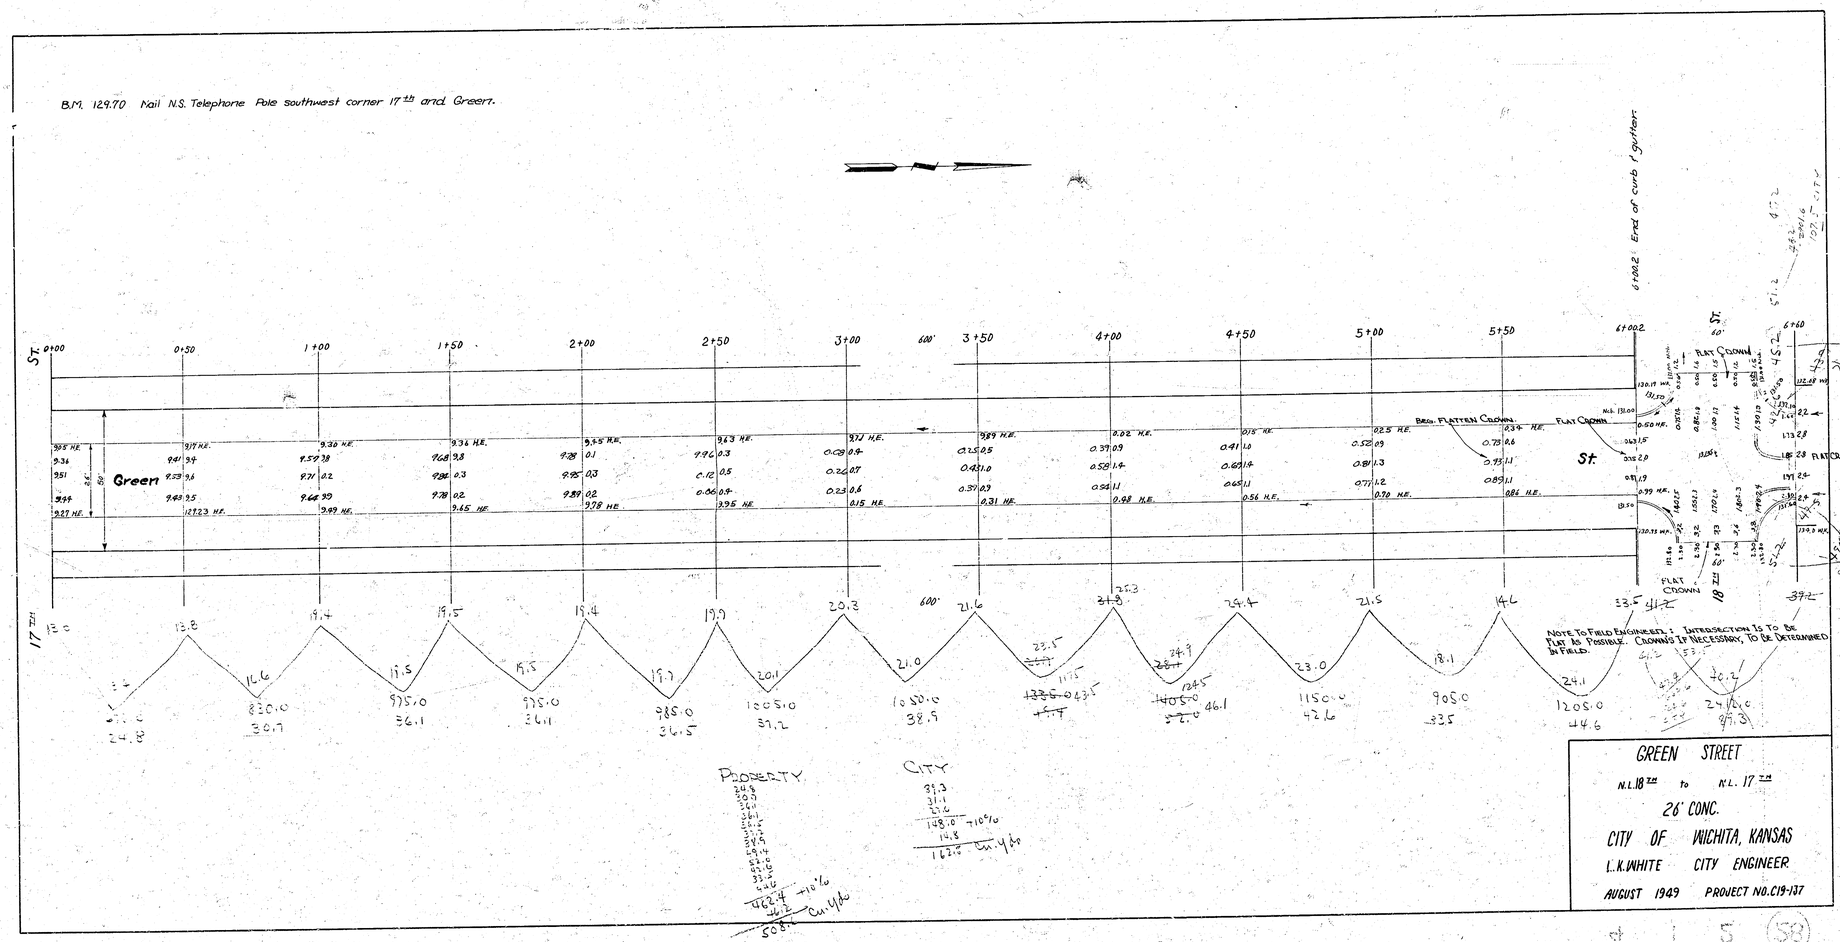

GREEN STREET

N.L. 18th to N.L. 17th

26' CONC.

CITY OF WICHITA, KANSAS

L. K. WHITE CITY ENGINEER

AUGUST 1949 PROJECT NO. C19-137