



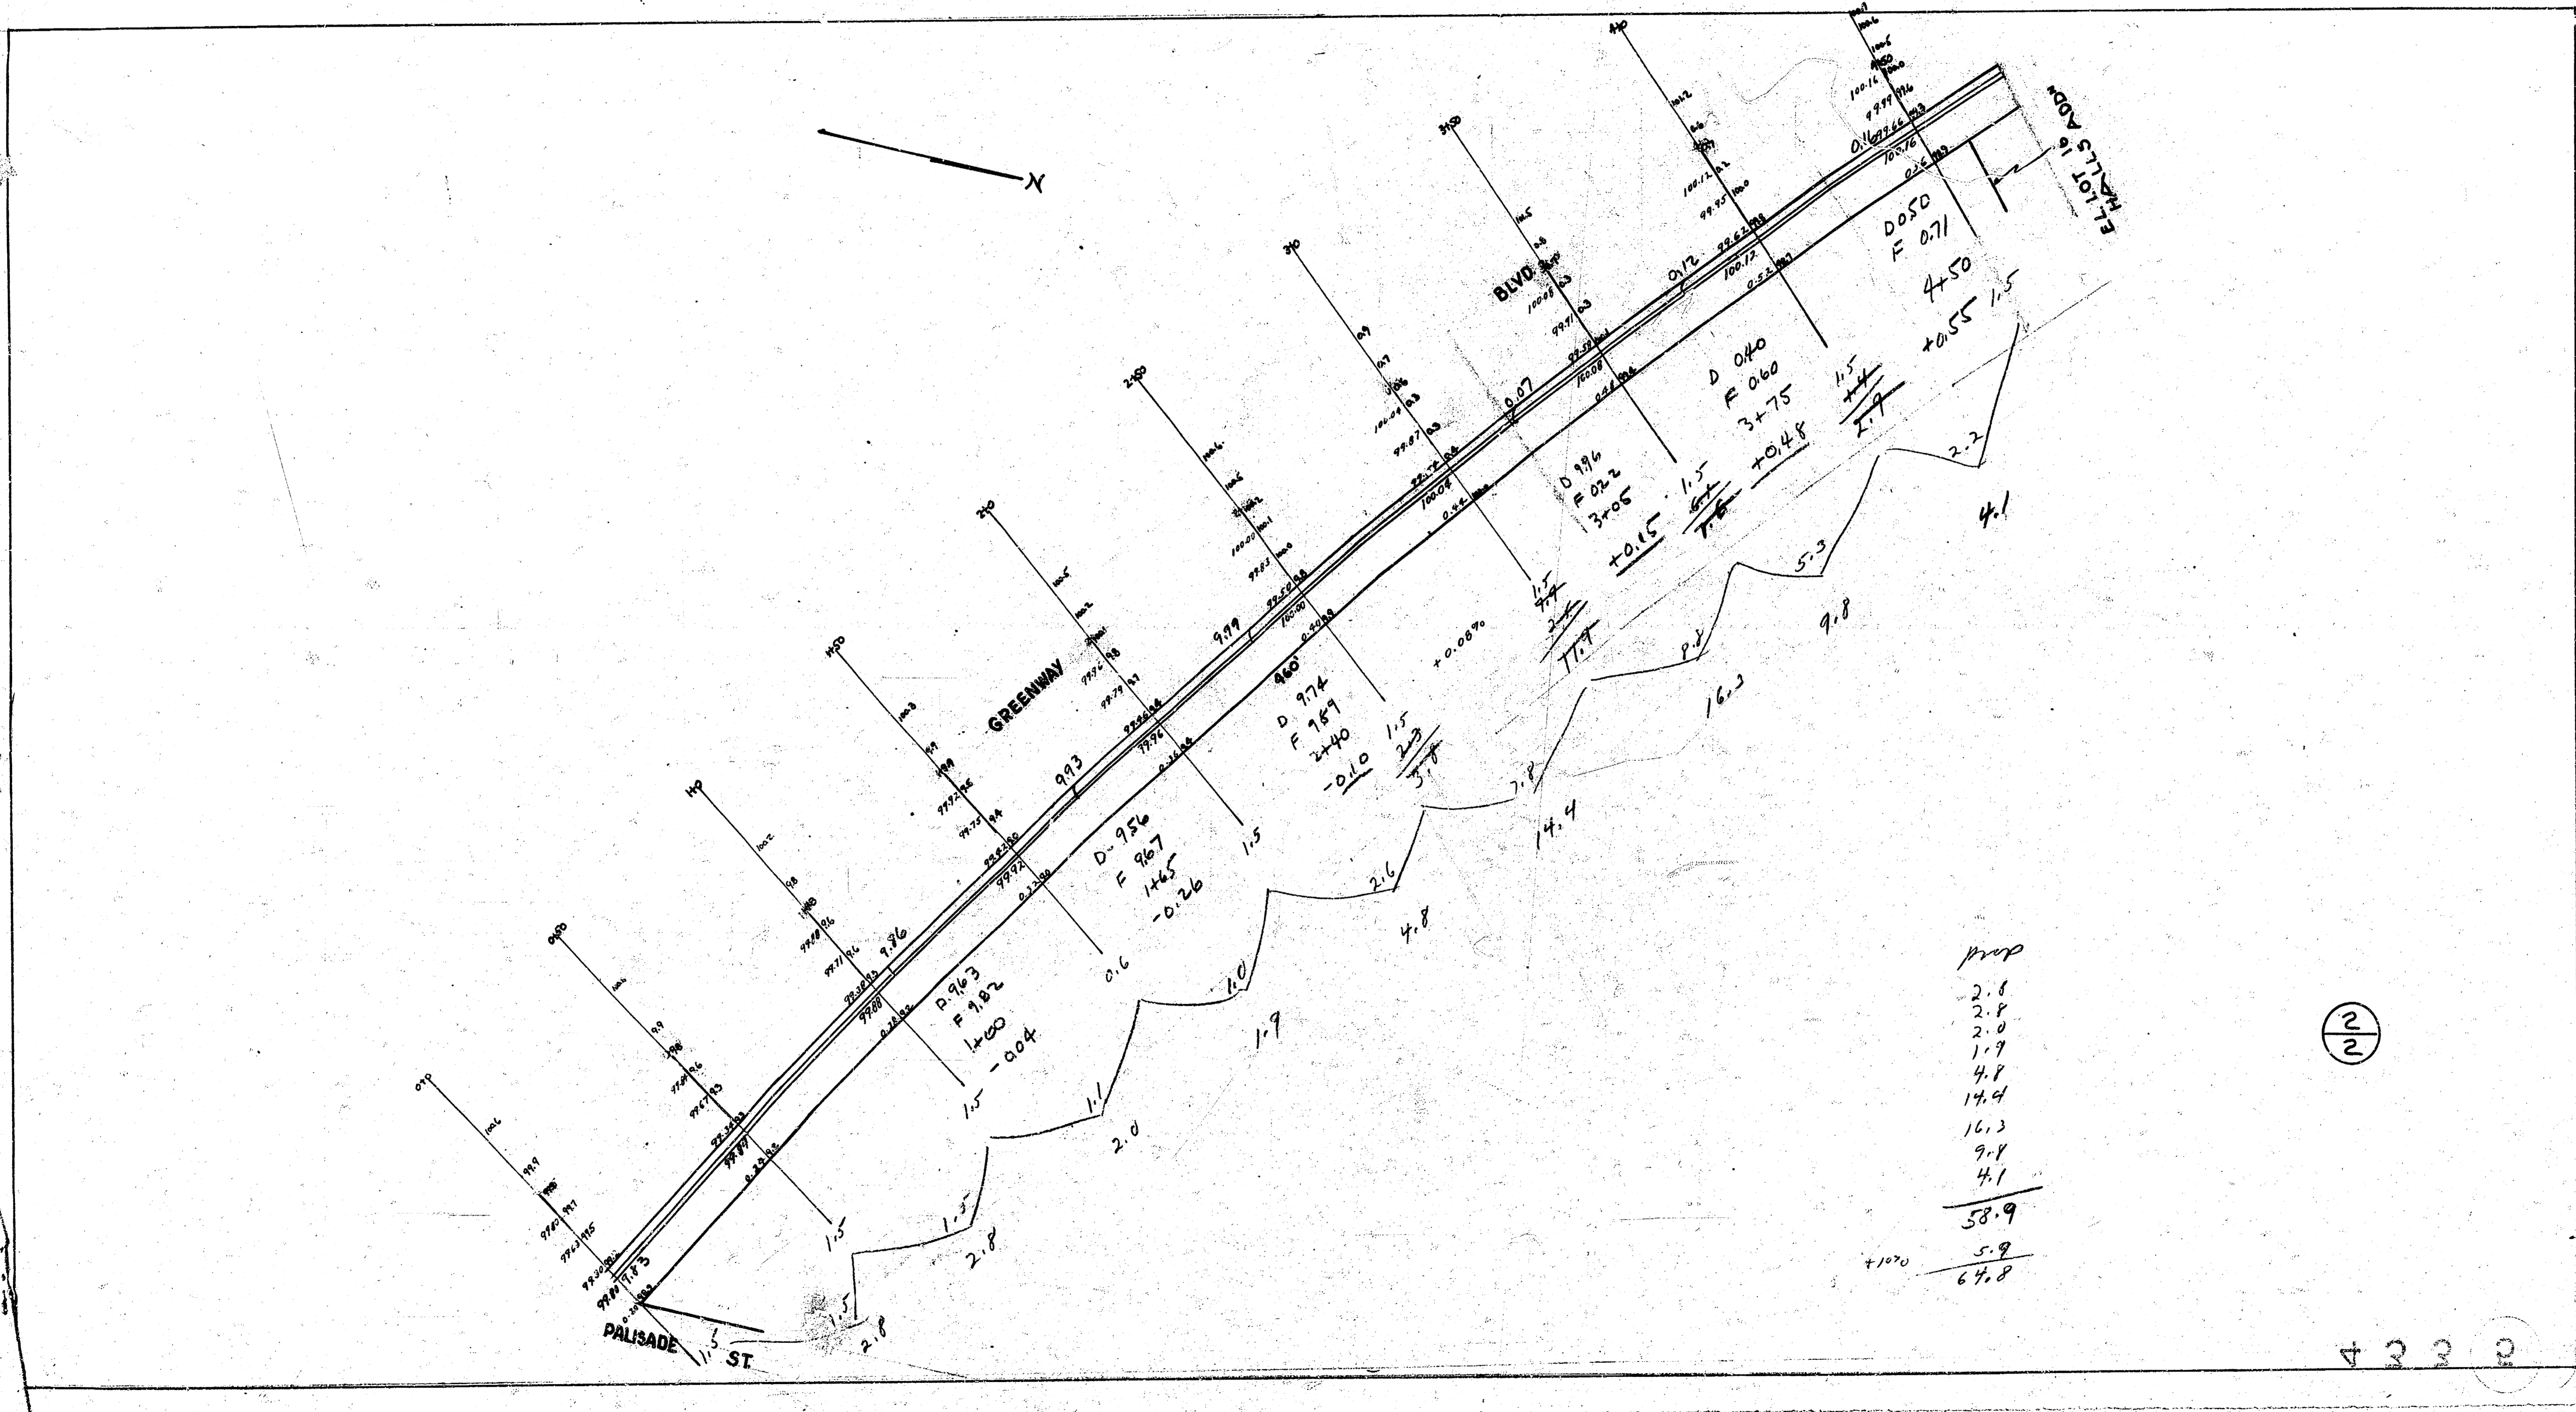

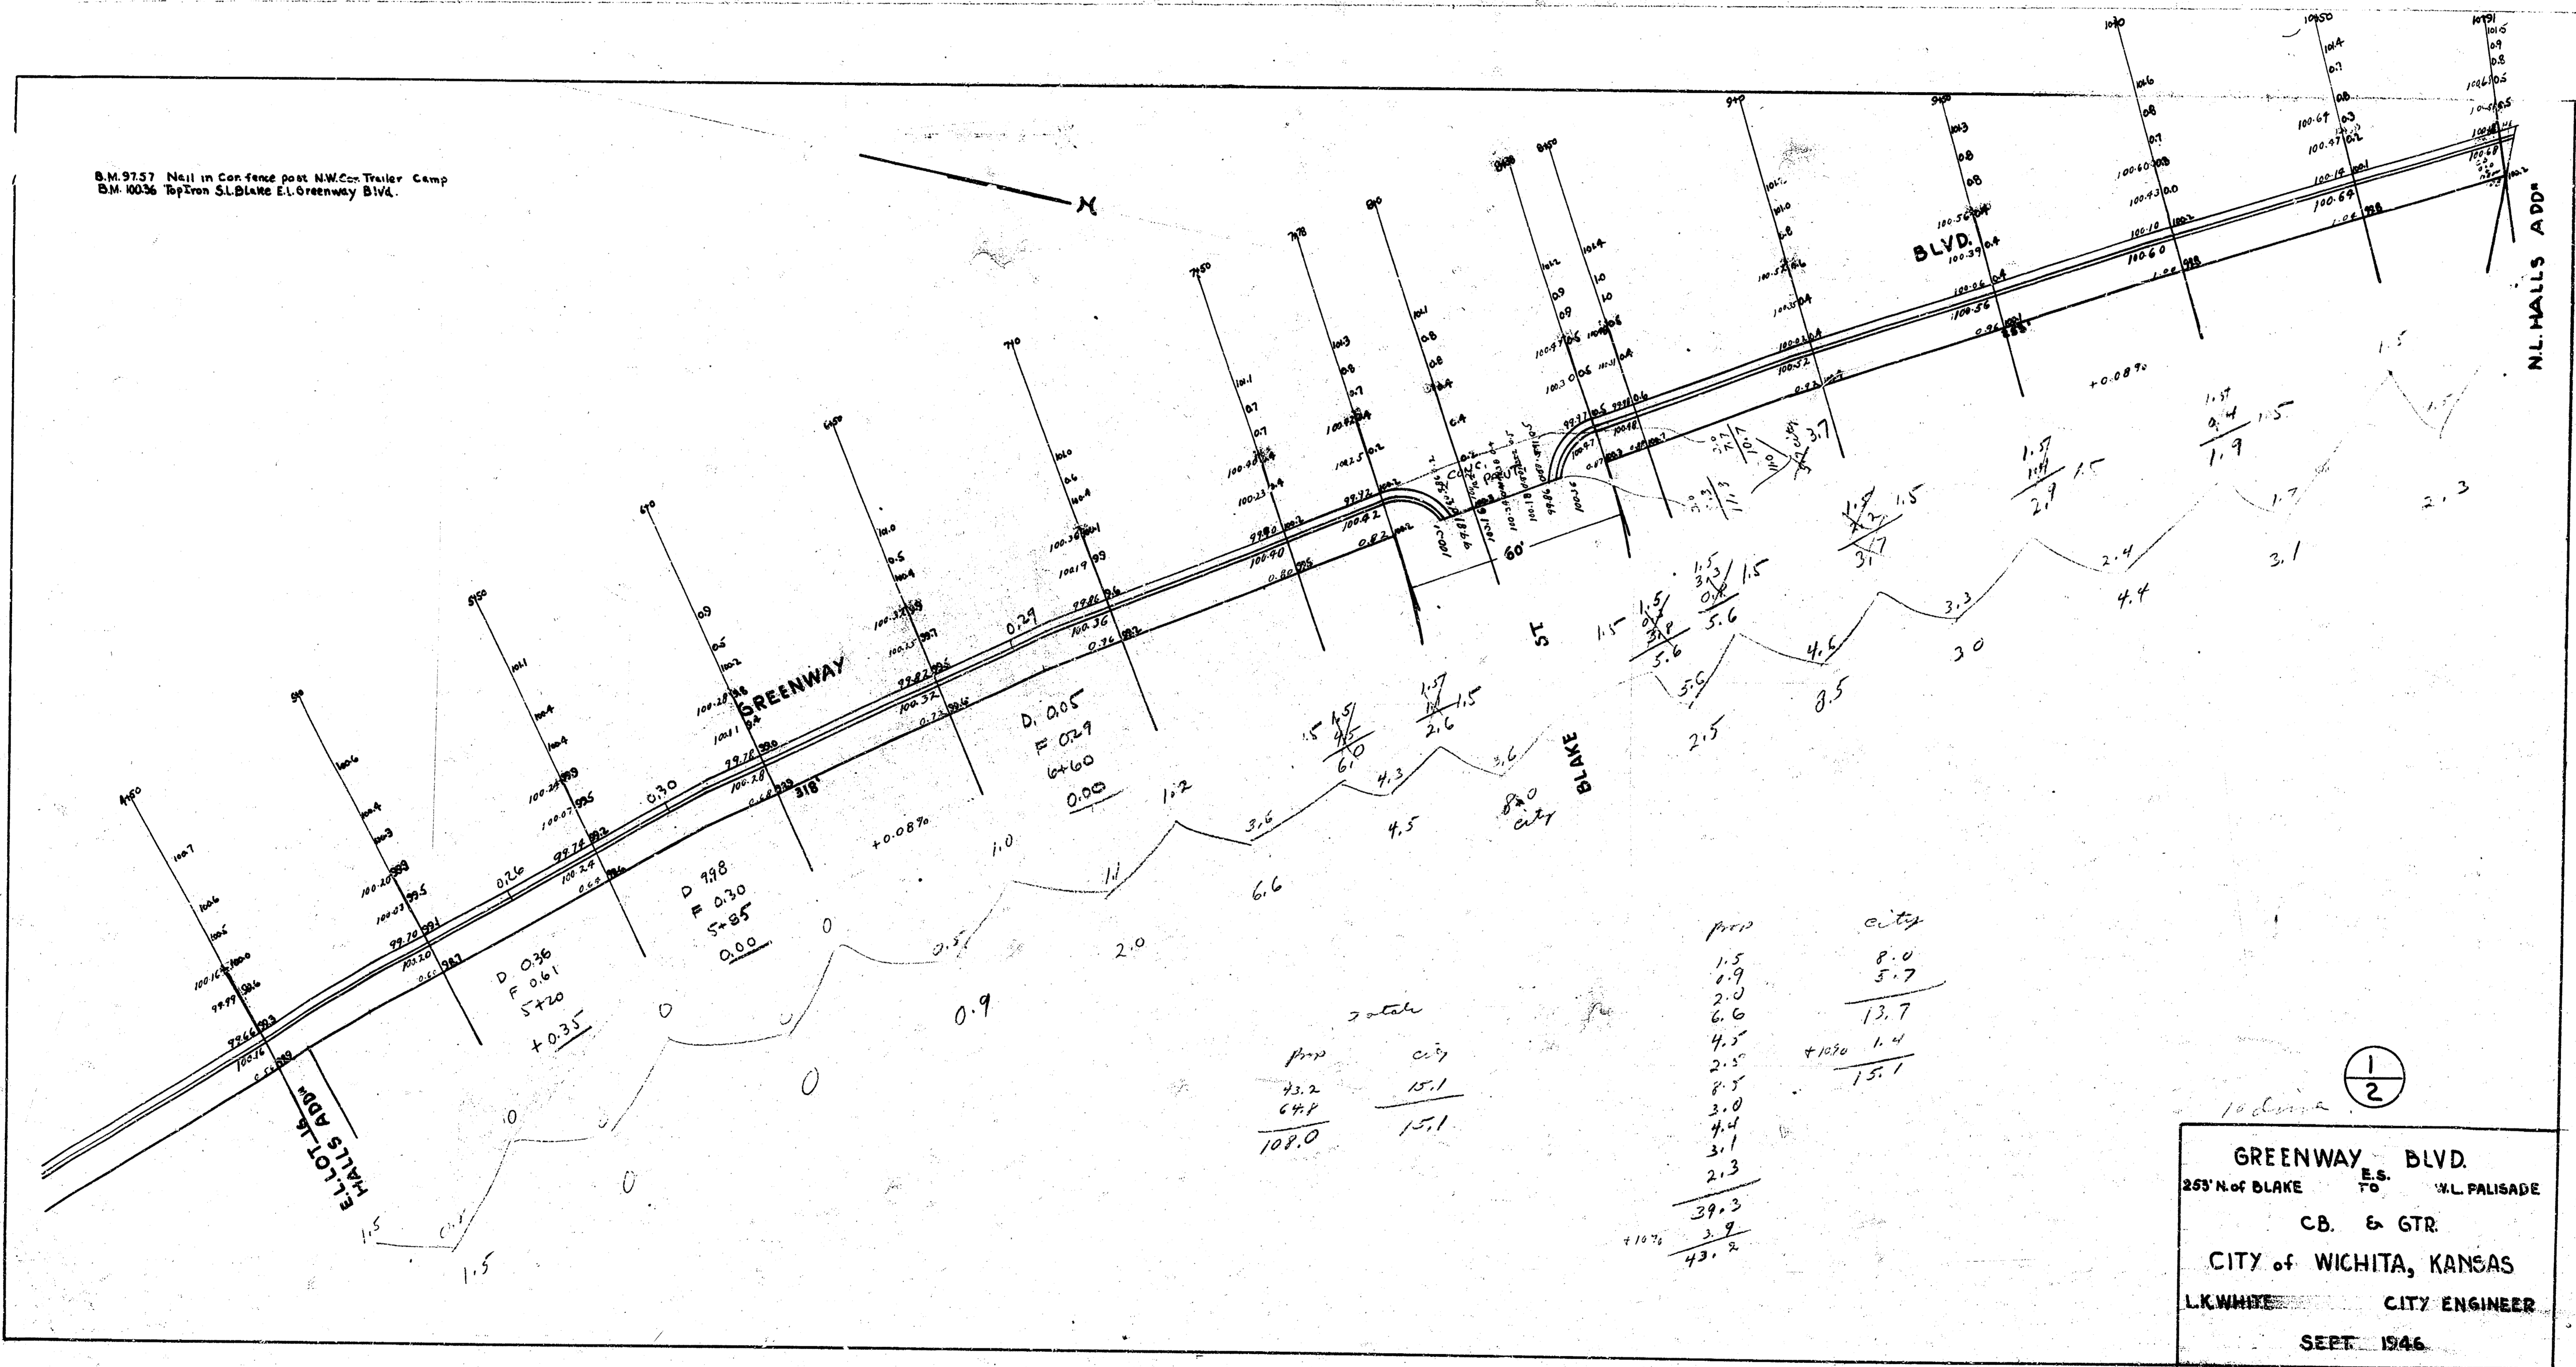

Prop	City
108.0	

Prop	City
1.5	8.0
0.9	5.7
2.0	
6.6	13.7
4.5	
2.5	+1020 1.4
8.5	15.1
3.0	
4.4	
3.1	
2.3	
39.3	
3.9	
43.2	


GREENWAY BLVD.
 255' N. of BLAKE TO N.L. PALISADE
 CB. & GTR.
 CITY of WICHITA, KANSAS
 L.K. WHITE CITY ENGINEER
 SEPT 1946




4222