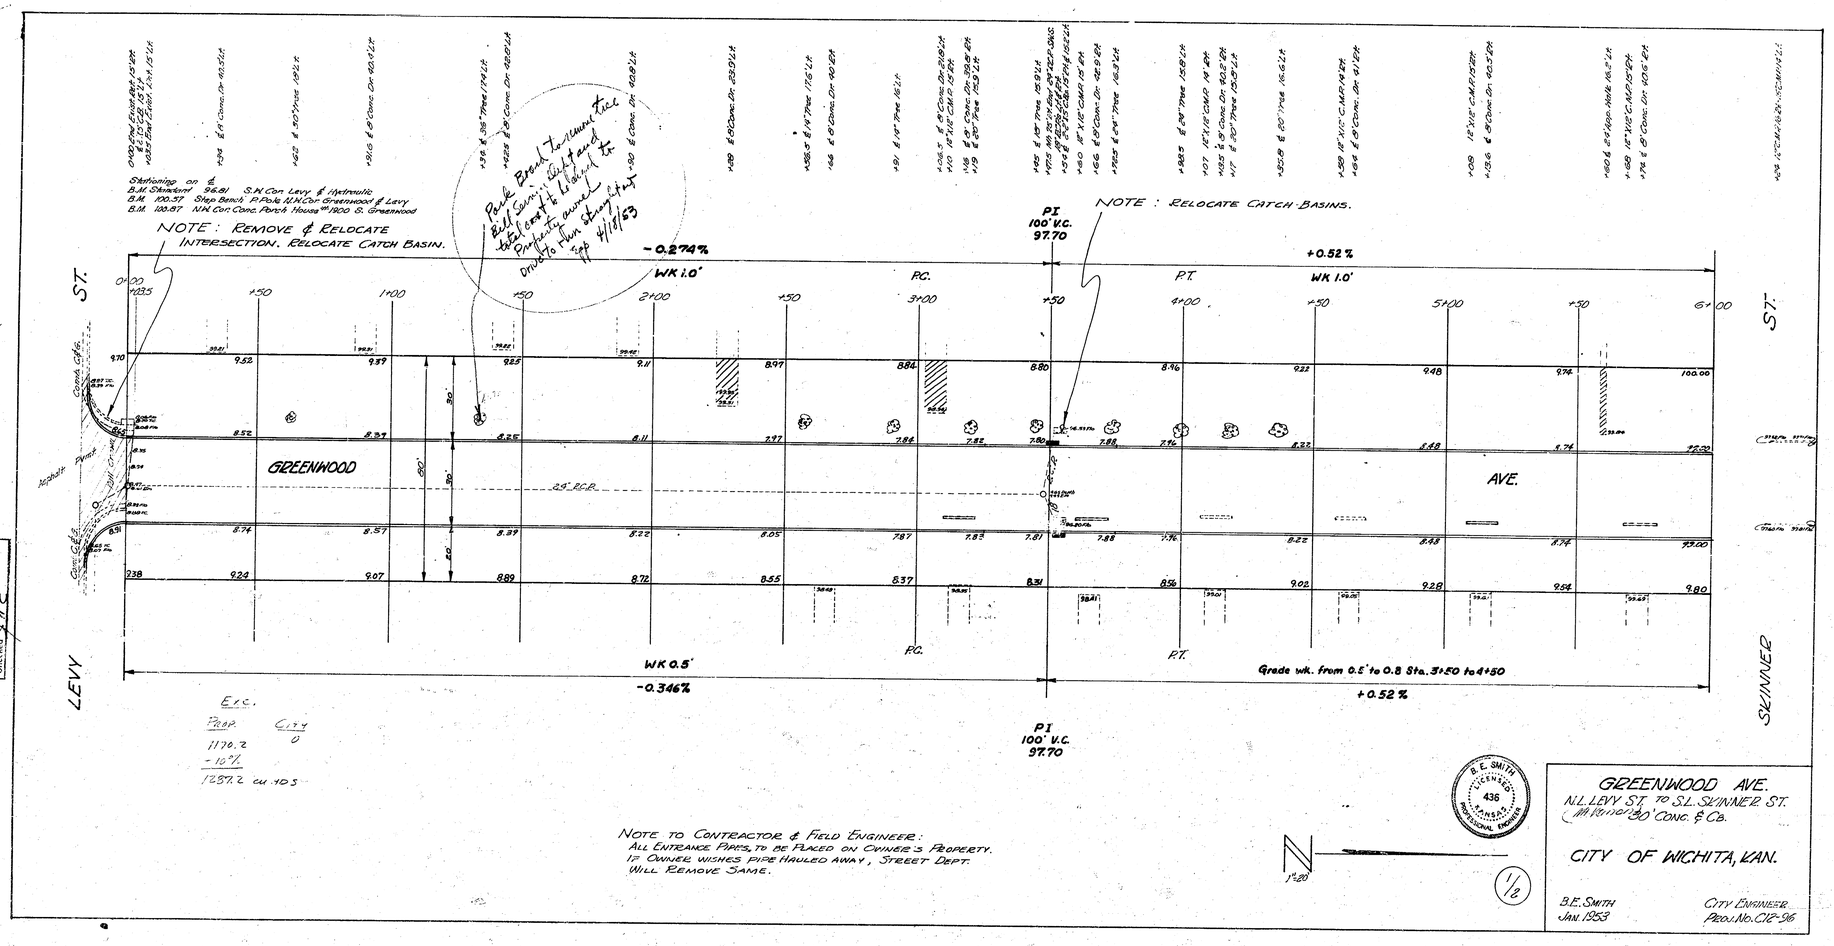

E.r.c.

Prop.	City
1170.2	0
-10%	
1287.2 cu. yds	

NOTE TO CONTRACTOR & FIELD ENGINEER:
ALL ENTRANCE PIPES, TO BE PLACED ON OWNER'S PROPERTY.
IF OWNER WISHES PIPE HAULED AWAY, STREET DEPT. WILL REMOVE SAME.

GREENWOOD AVE.
N.L. LEVY ST. TO S.L. SKINNER ST.
(M.P. 1100) 30' CONC. & Co.

CITY OF WICHITA, KAN.

B.E. SMITH
JAN. 1953

CITY ENGINEER
PROJ. NO. CIP-56