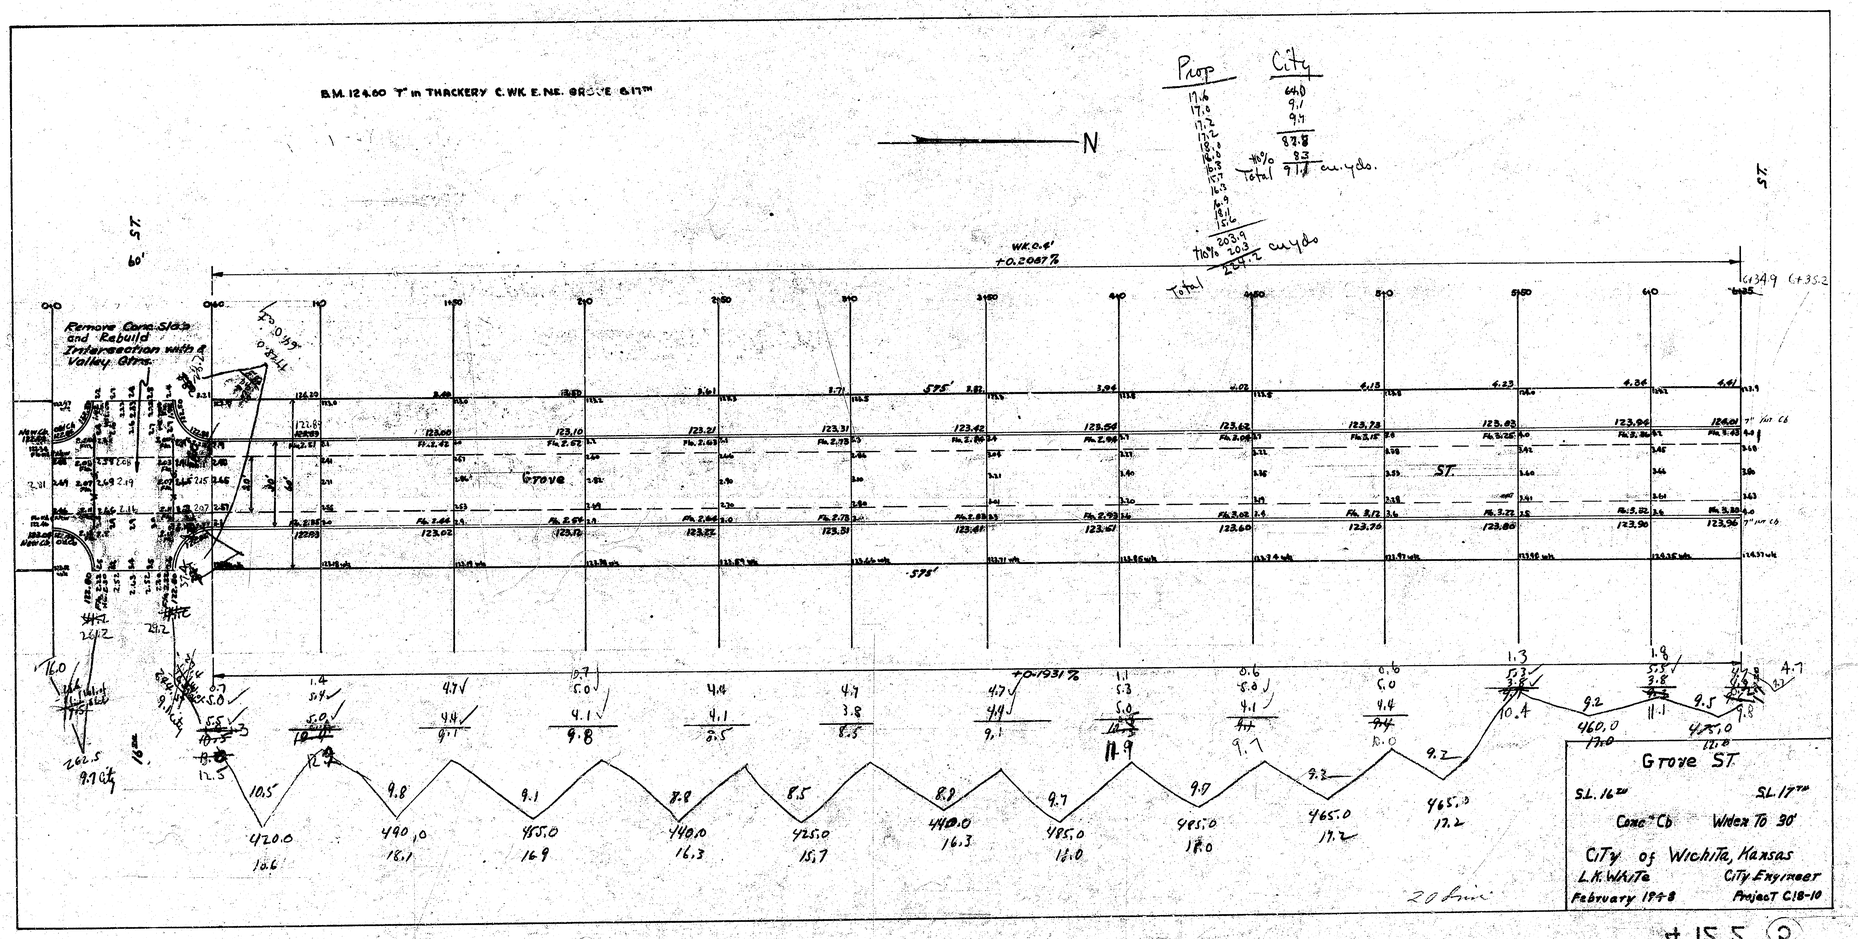
B.M. 124.60 "T" in THACKERY C.WK. E.NE. GROVE 6.17TH
N
Prop
City
Total
cu.yds.
WK.0.6'
+0.2067%
+0.1931%
575'
Remove Conc. Slab and Rebuild Intersection with Valley Gutter
GROVE
ST.
Grove ST
SL. 16TH
SL. 17TH
Conc. Cb
Widen To 30'
City of Wichita, Kansas
L.K. White
City Engineer
February 1948
Project C18-10
20 Lin

A 155 (2)