PAVING PLAN 1943
HARDING - S.L. PINE to N.L. ELM STREETS
26' CONCRETE

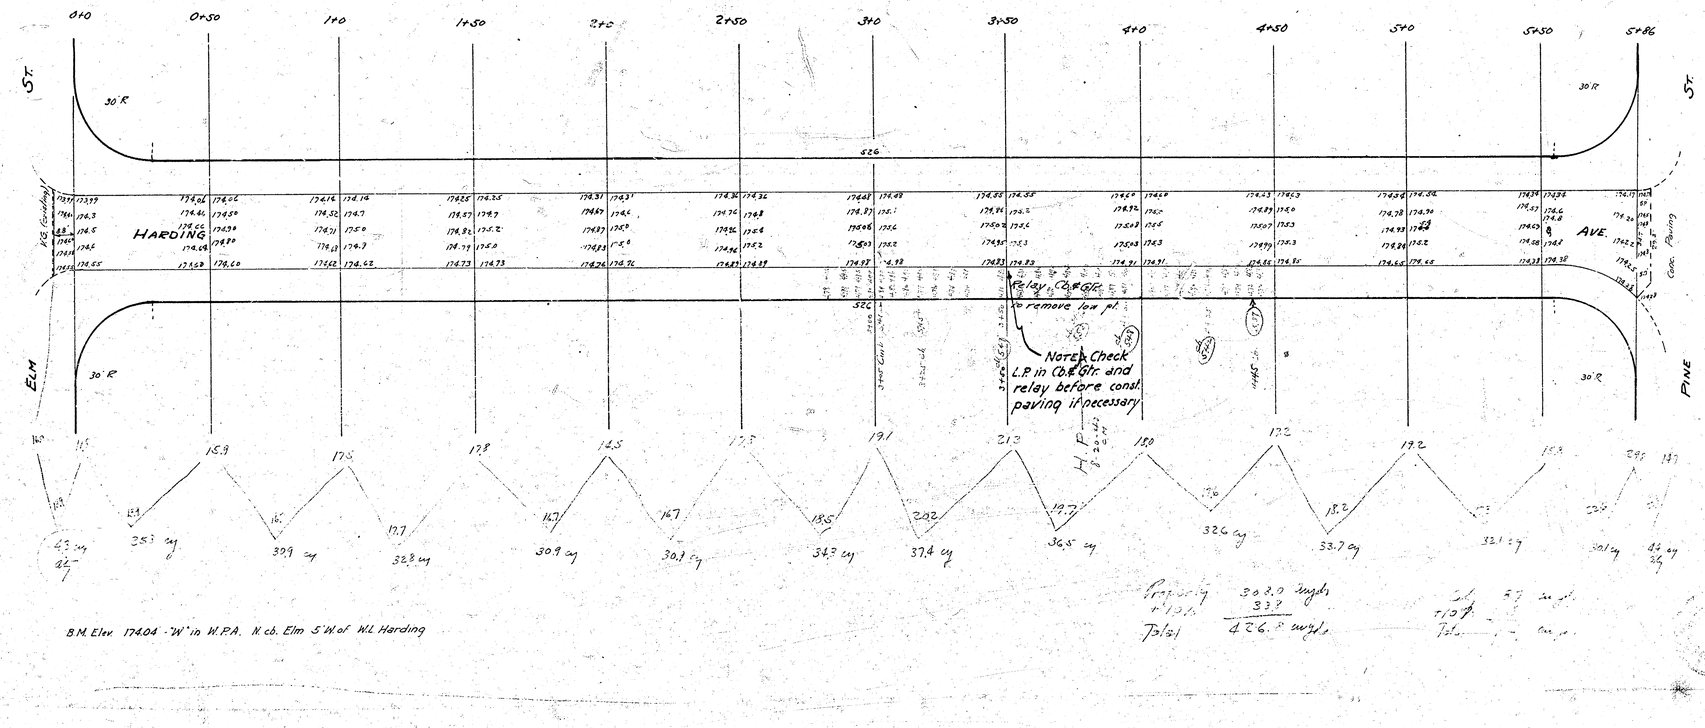

Red figures are 3" below curb grade

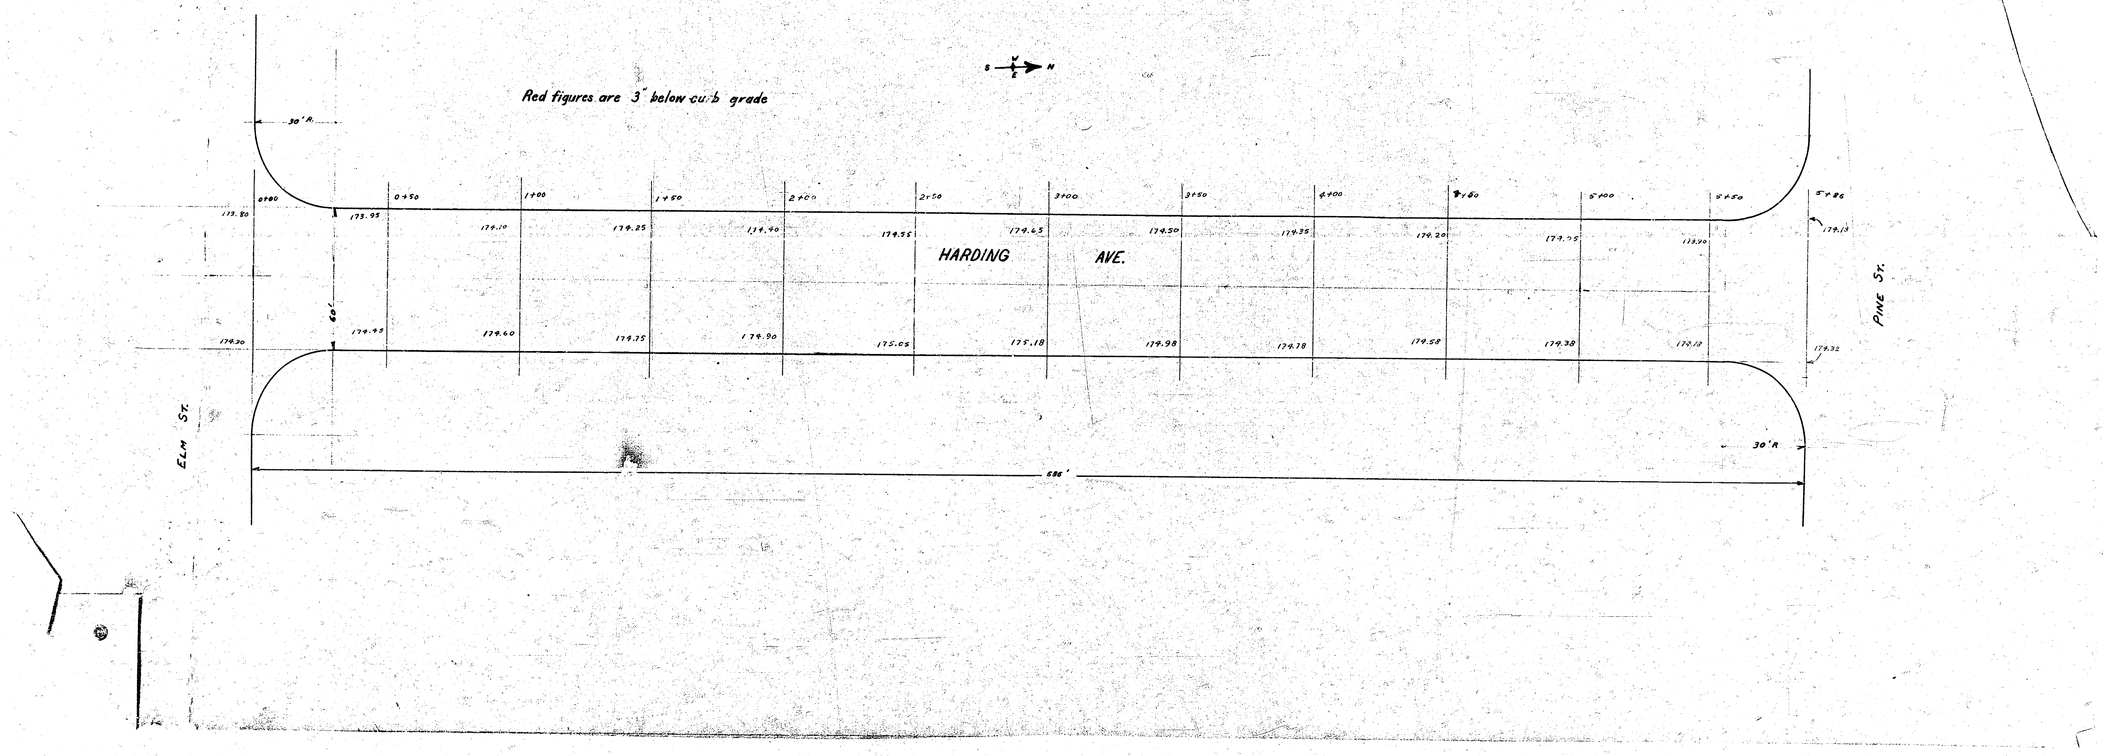

Curb & Gutter only

B.M. Elev. 174.85 S.W. coping of culvert on Central E. of Bleckley Drive
B.M. Elev. 174.28 W. End S. cb. Return Pine & C. Lot 81/65
B.M. Elev. 172.69 N. End W. cb. Return Elm & C. Lot 81/65
B.M. Elev. 174.04 "W" in W.P.A. N. cb. Elm 5' W. of W.L. Harding

Harding Jct
Elm 66'
Pine 66'

Returns & V.G. included in Elm St calculations

Normal Wk grade

+0.152%

-0.287%

-0.153%

-0.56%

Walk grade (1.0) above curb

272' V.C.

Harding

Elm

Pine

0+00 0+50 1+00 1+50 2+00 2+80 3+00 3+50 4+00 4+50 5+00 5+50 5+82