



B.M. 100.19 1/4" SPIKE IN FACE POLE 197° S OF IRON N.E. COR. HANDLEY & MAXWELL.
 B.M. 102.78 1/4" SPIKE IN SW FACE OF 24" DIA. MESSER THEOP. 50° S 130° E OF IRON SW COR. HANDLEY & PAWNEE.
 (B.M. 109.25 TOP OF U.S. COAST & GEOD. B.M. - N.E. COR. SENECA & PAWNEE.) CONC.
 STATIONED ON W.R.

12932 CUYDS
 1422.5 CUYDS

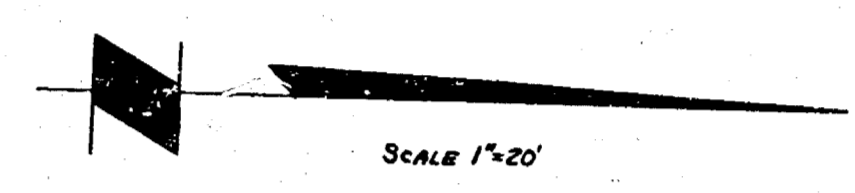

SULLY MAXWELL BK. JAWEE
 L.V. P.W.
 CHICAGO ILL.

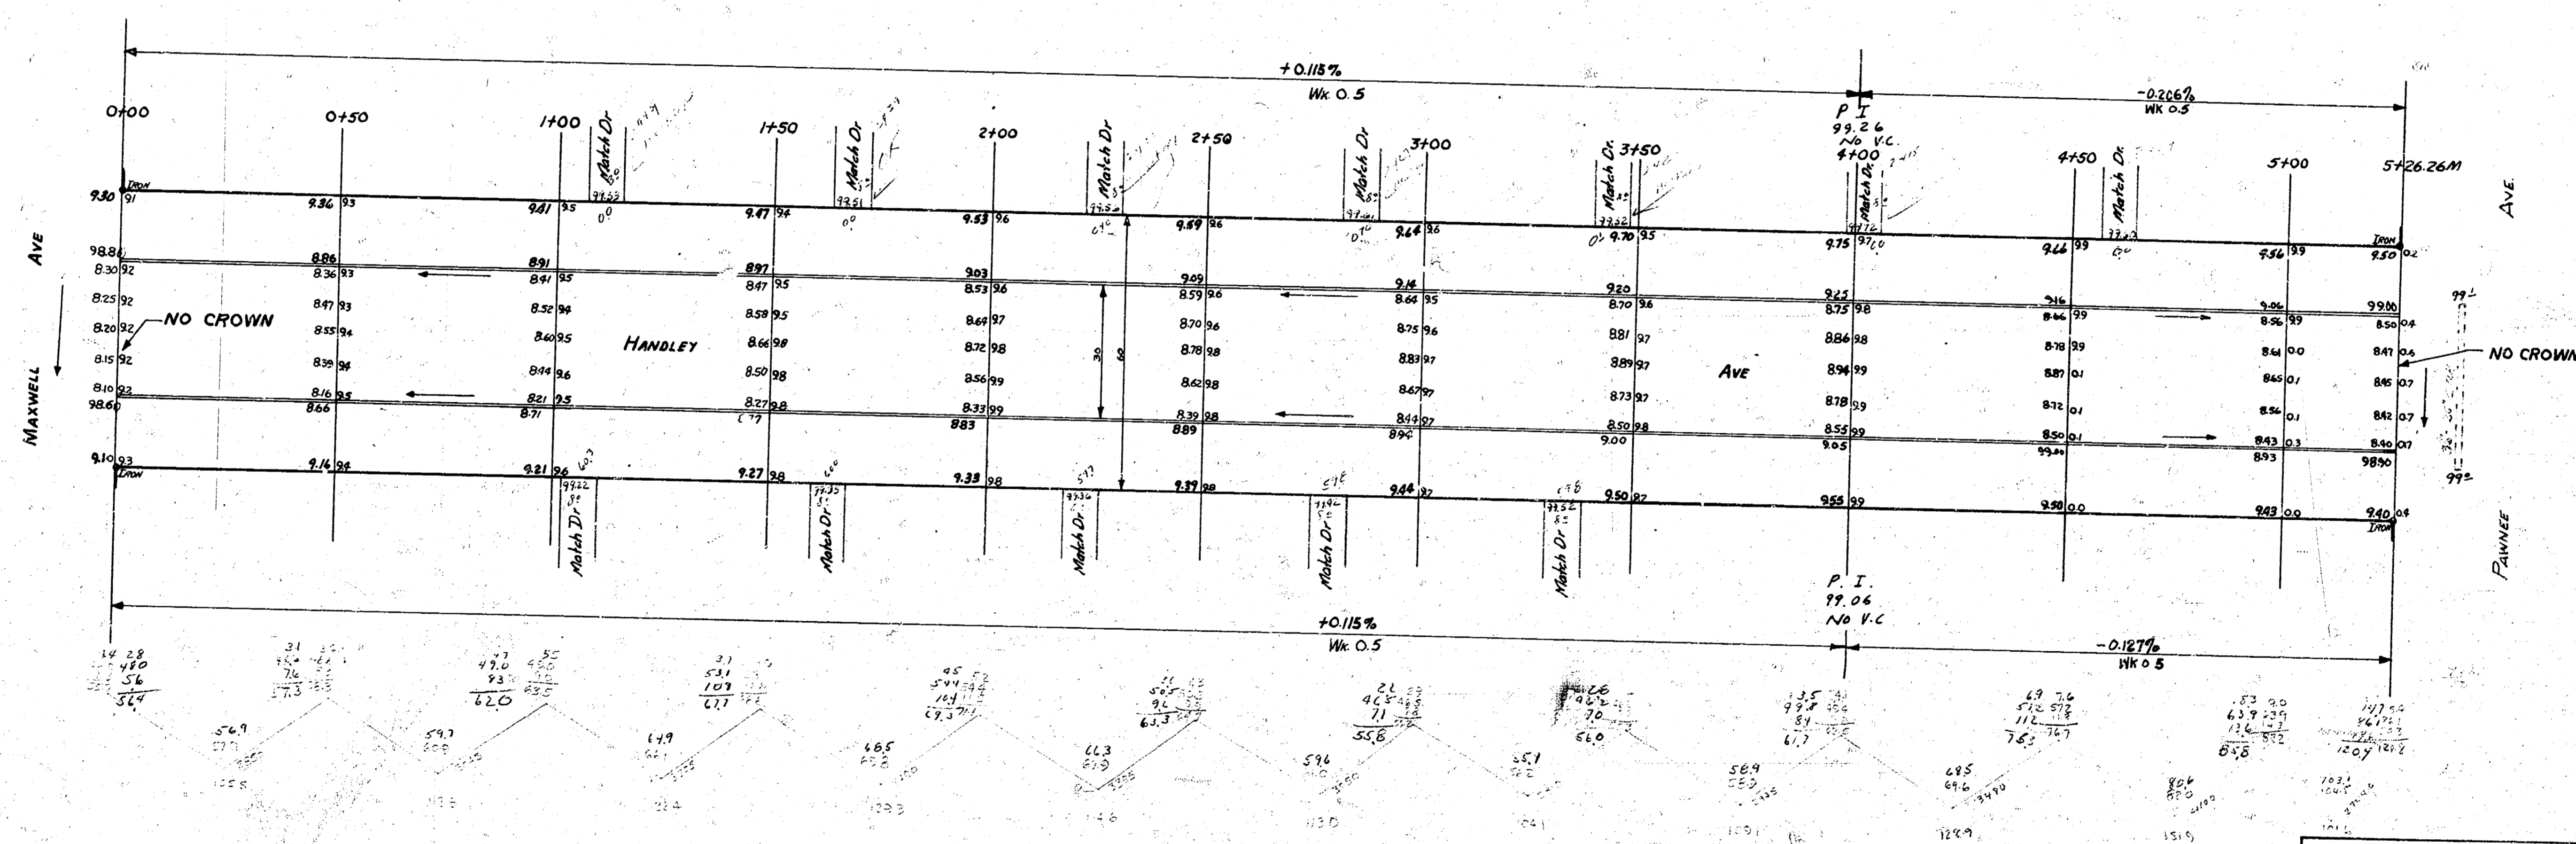

HANDLEY AVE
 N.L. MAXWELL TO S.L. PAWNEE
 30 CONC. & CO.
 CITY OF WICHITA, KANSAS
 B.E. SMITH CITY ENGINEER
 JULY 1956 PROJ. NO. C15-6

1 12 1 13