
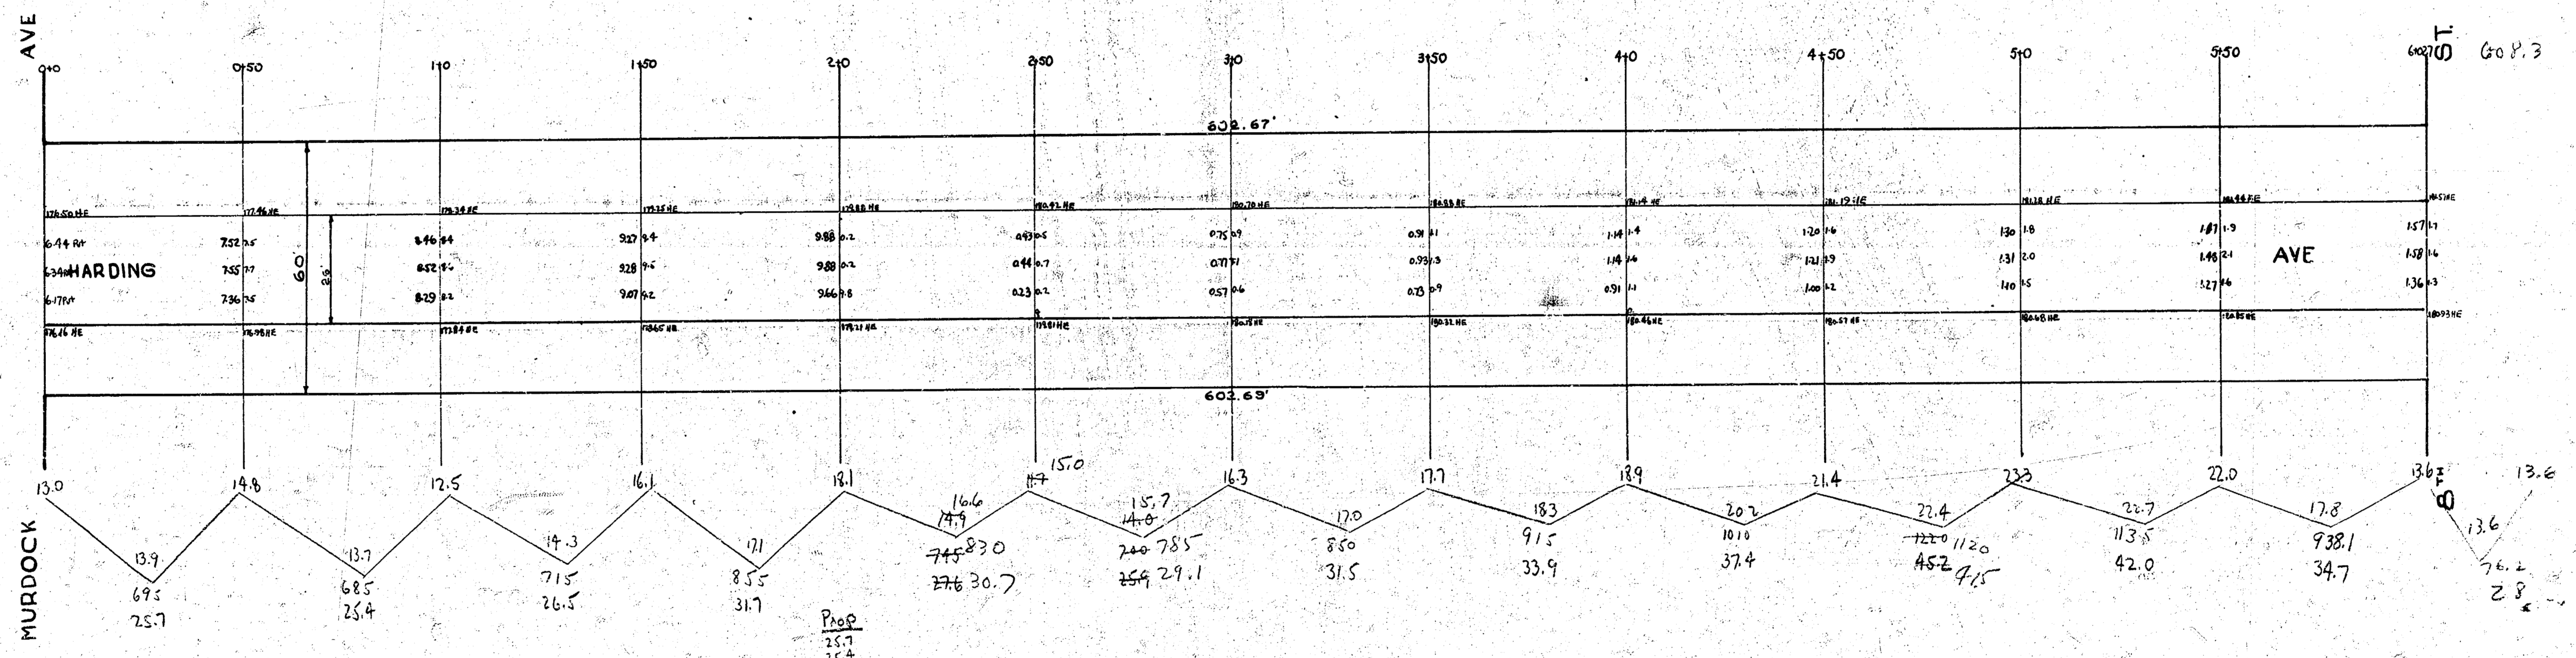


B.M. 180.99 6" in slope S. end Cb. Return S.W. Cor. Bathn to Murdock  
 B.M. 179.18 "T" in Tray Hyd. NW. Cor. Murdock to Harding

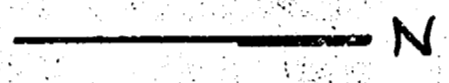

P.C. 26.7  
 25.7  
 25.9  
 26.5  
 27.7  
 29.1  
 30.7  
 31.5  
 31.8  
 32.9  
 37.2  
 40.2  
 41.5  
 43.0  
 44.7  
 47.5  
 390.1  
 416.3 cur. yds

CITY  
 2.8 cur. yds

HARDING AVE.  
 N.L. MURDOCK to SL 8<sup>TH</sup>  
 26' CONCRETE  
 CITY of WICHITA, KANS.  
 L.K. WHITE CITY ENGINEER  
 NOV. 1946