

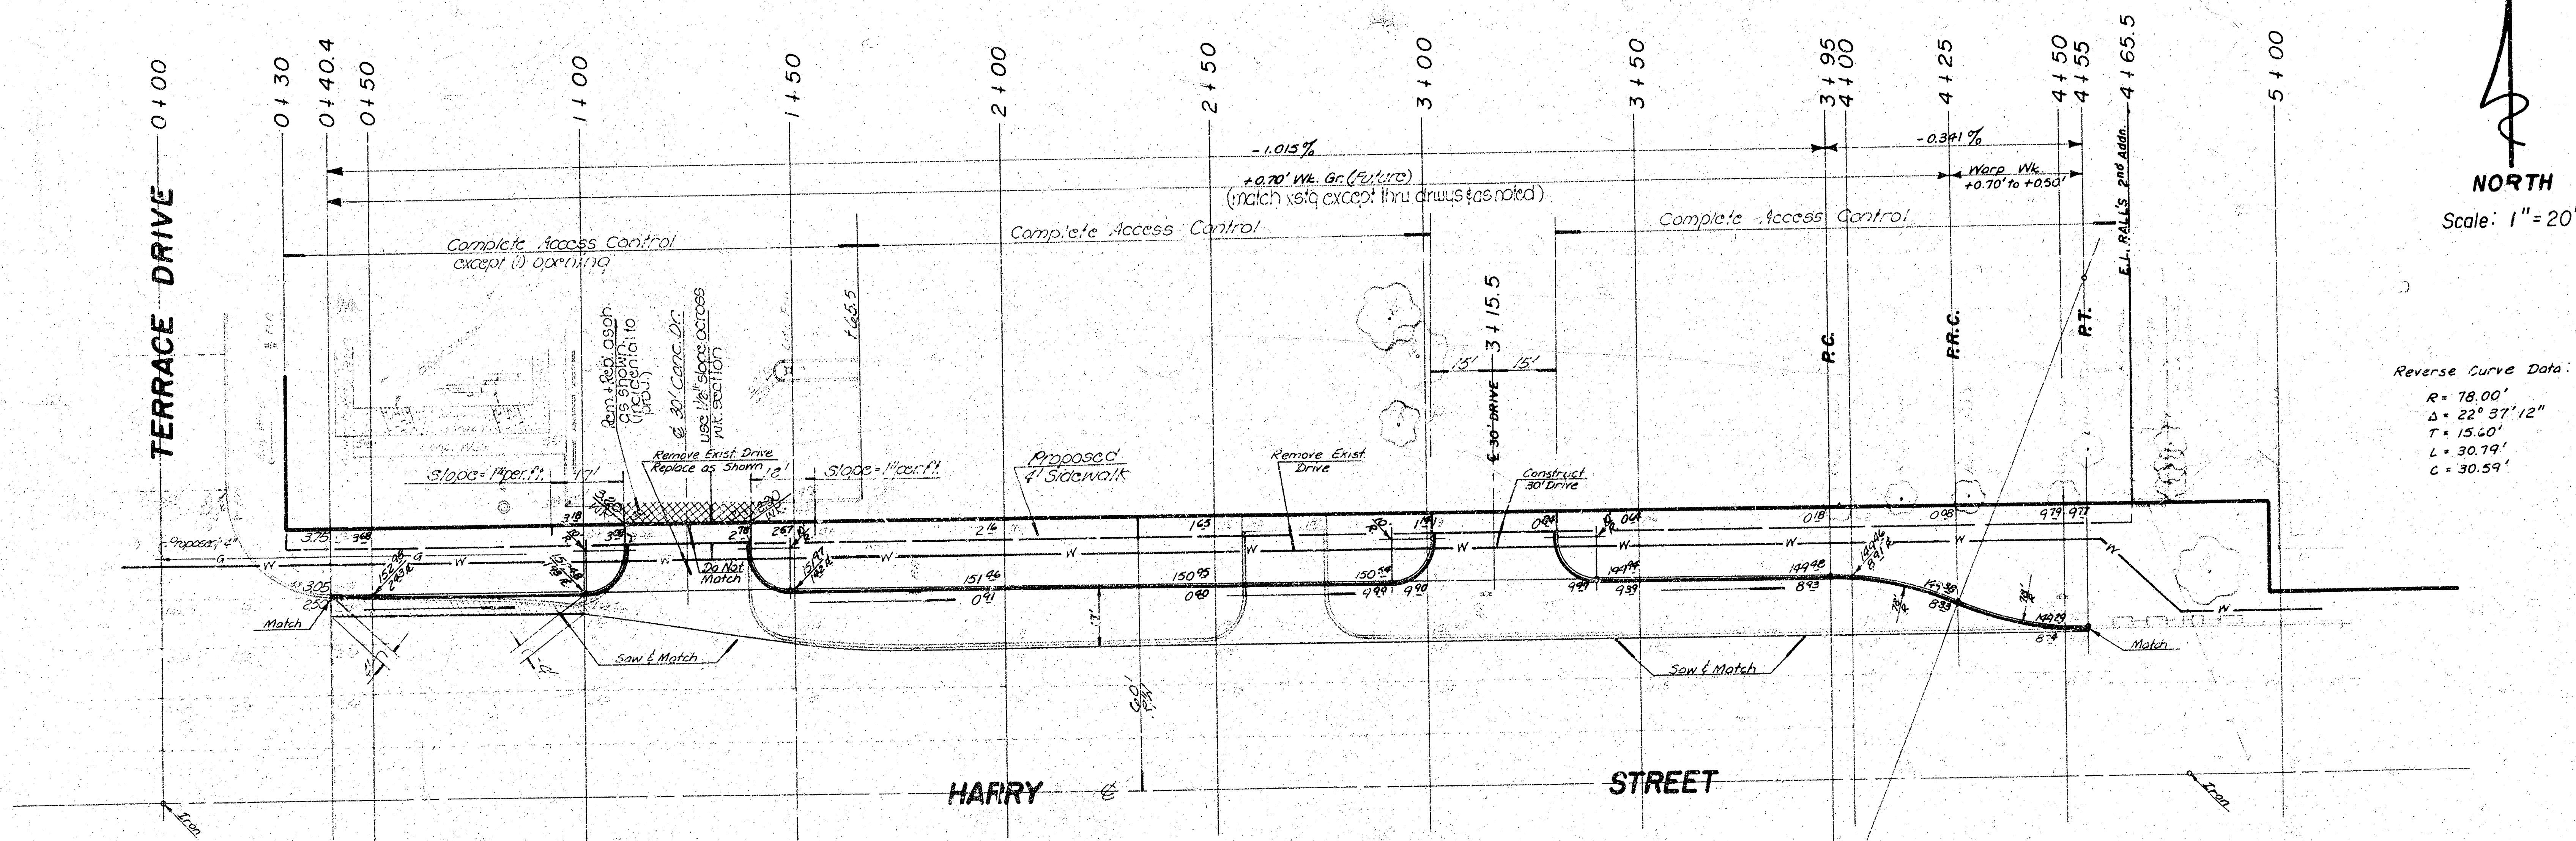


B.M. = 157.08 "□" Cut N.W. Cor. Conc. Base Meadow Lark Sign, S.S. Harry 100'± W. of W.L. Terrace Dr.
Baseline is 50' North of & Parallel to E Harry St.

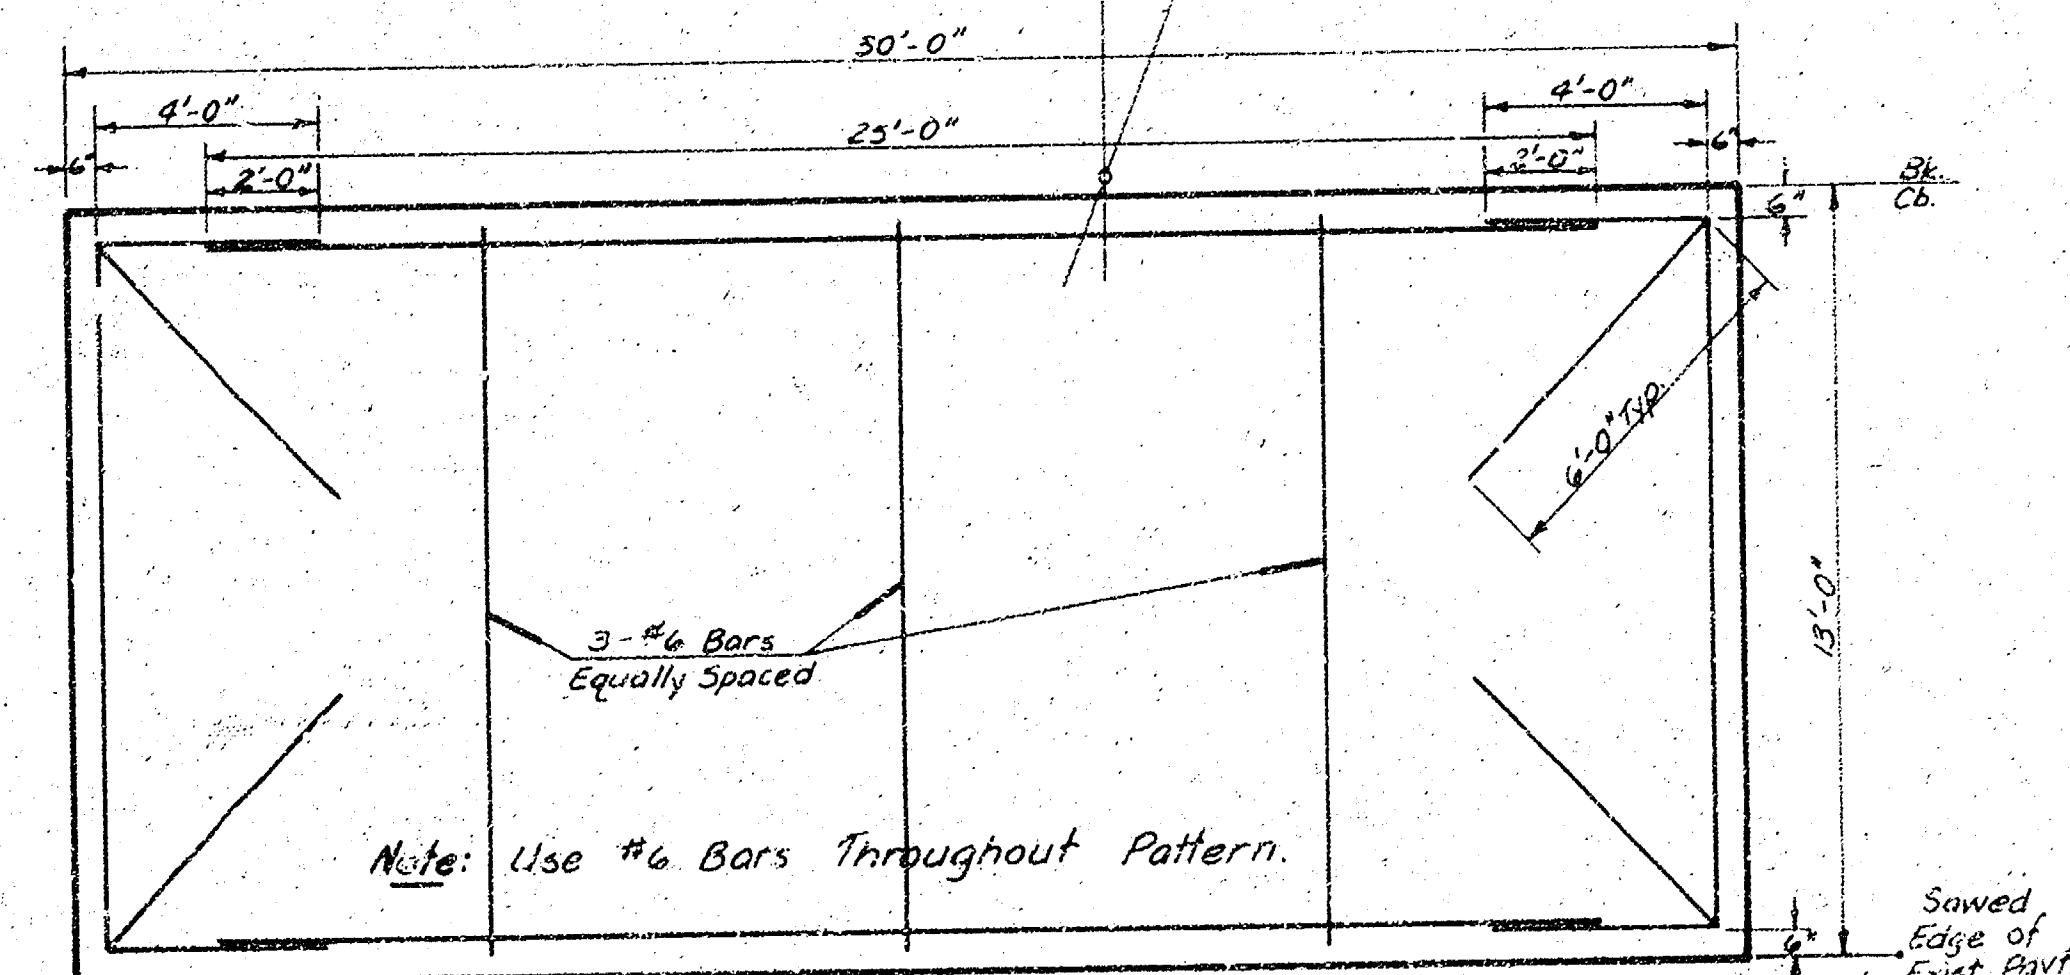

NOTE TO FIELD ENGINEER & CONTRACTOR
Grade parking and clear right-of-way for proposed sidewalk. Curbcut fill in sidewalk area to be constructed by contractor.

TYPE OF SUBGRADE TREATMENT SHALL BE DETERMINED BY FIELD ENGINEER. SUBGRADE TREATMENT SHALL BE USED TO FURNISH A FIRM, UNIFORM, AND DRAINAGE MODULUS. THIS OR ANY OTHER TYPE OF THESE.

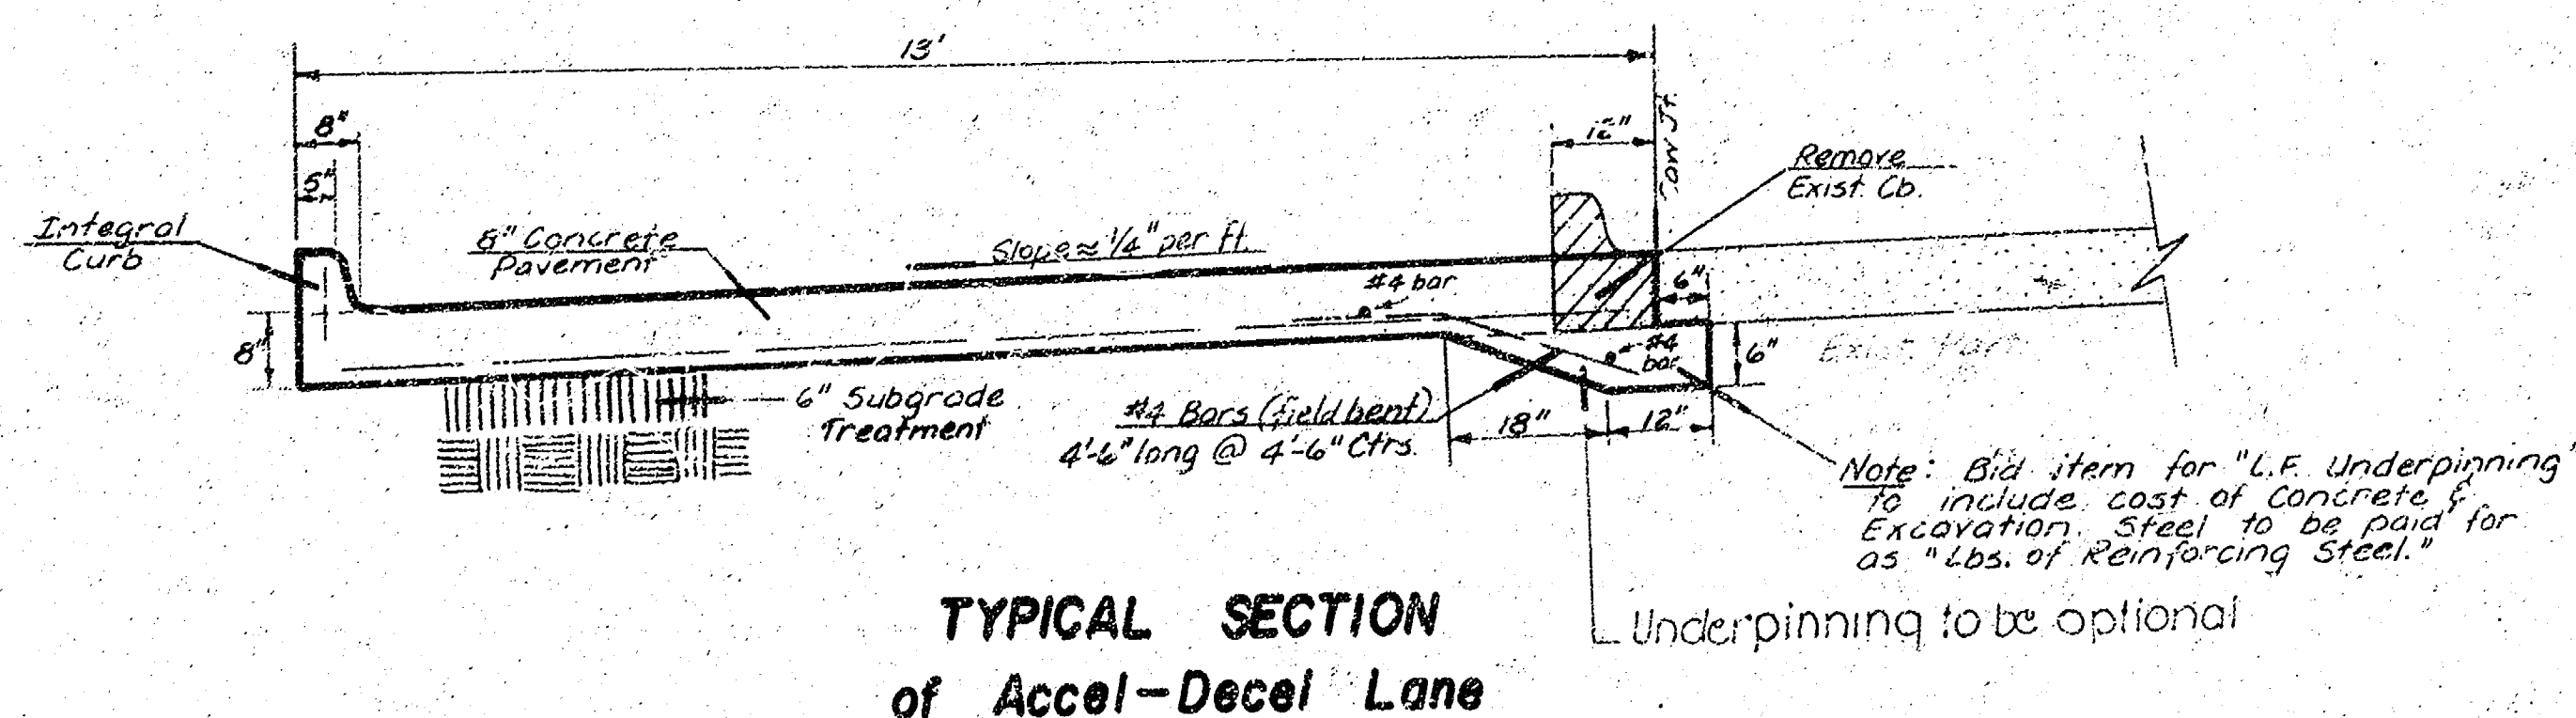

EARTHWORK	
Excavation	Property
+10%	387.1 C.Y.
	+ 38.7 C.Y.
	425.8 C.Y.
Manipulation	496.9 S.Y.

ACCEL-DECEL LANE
North Side HARRY STREET
E.L. Terrace Dr. to 70'E. of E.L. Ralls 2nd Addn.
(8" Concrete Pavt. with Integral Curb)
CITY OF WICHITA, KANSAS
R. W. Linn — City Engineer
Proj. No. DAKS576065
Date: _____

Plan revised 6-16-77 apb