



HILLSIDE AVE
N.L. 17TH TO S.L. 21ST
PROJ. NO. CI3-264

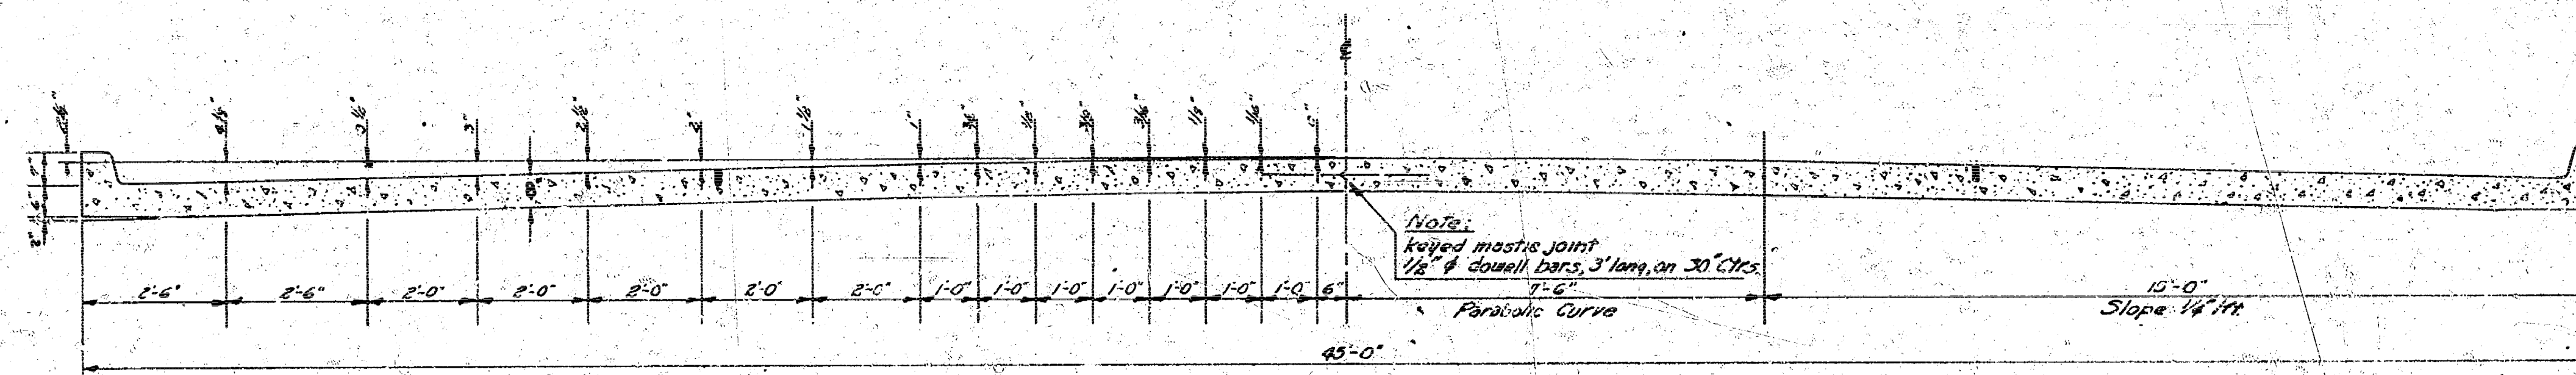


TYPICAL SECTION
NO SCALE

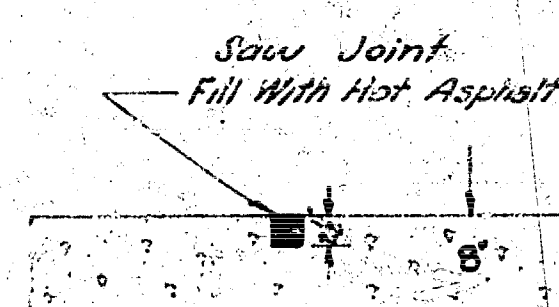


TRANSVERSE & LONGITUDINAL
JOINT DETAIL
NO SCALE

NOTE -

WHERE CURBS IN THE SAME SECTION
ARE AT DIFFERENT ELEVATIONS USE
ELEVATION SHOWN ON PLAN FOR
CONSTRUCTION JOINT.

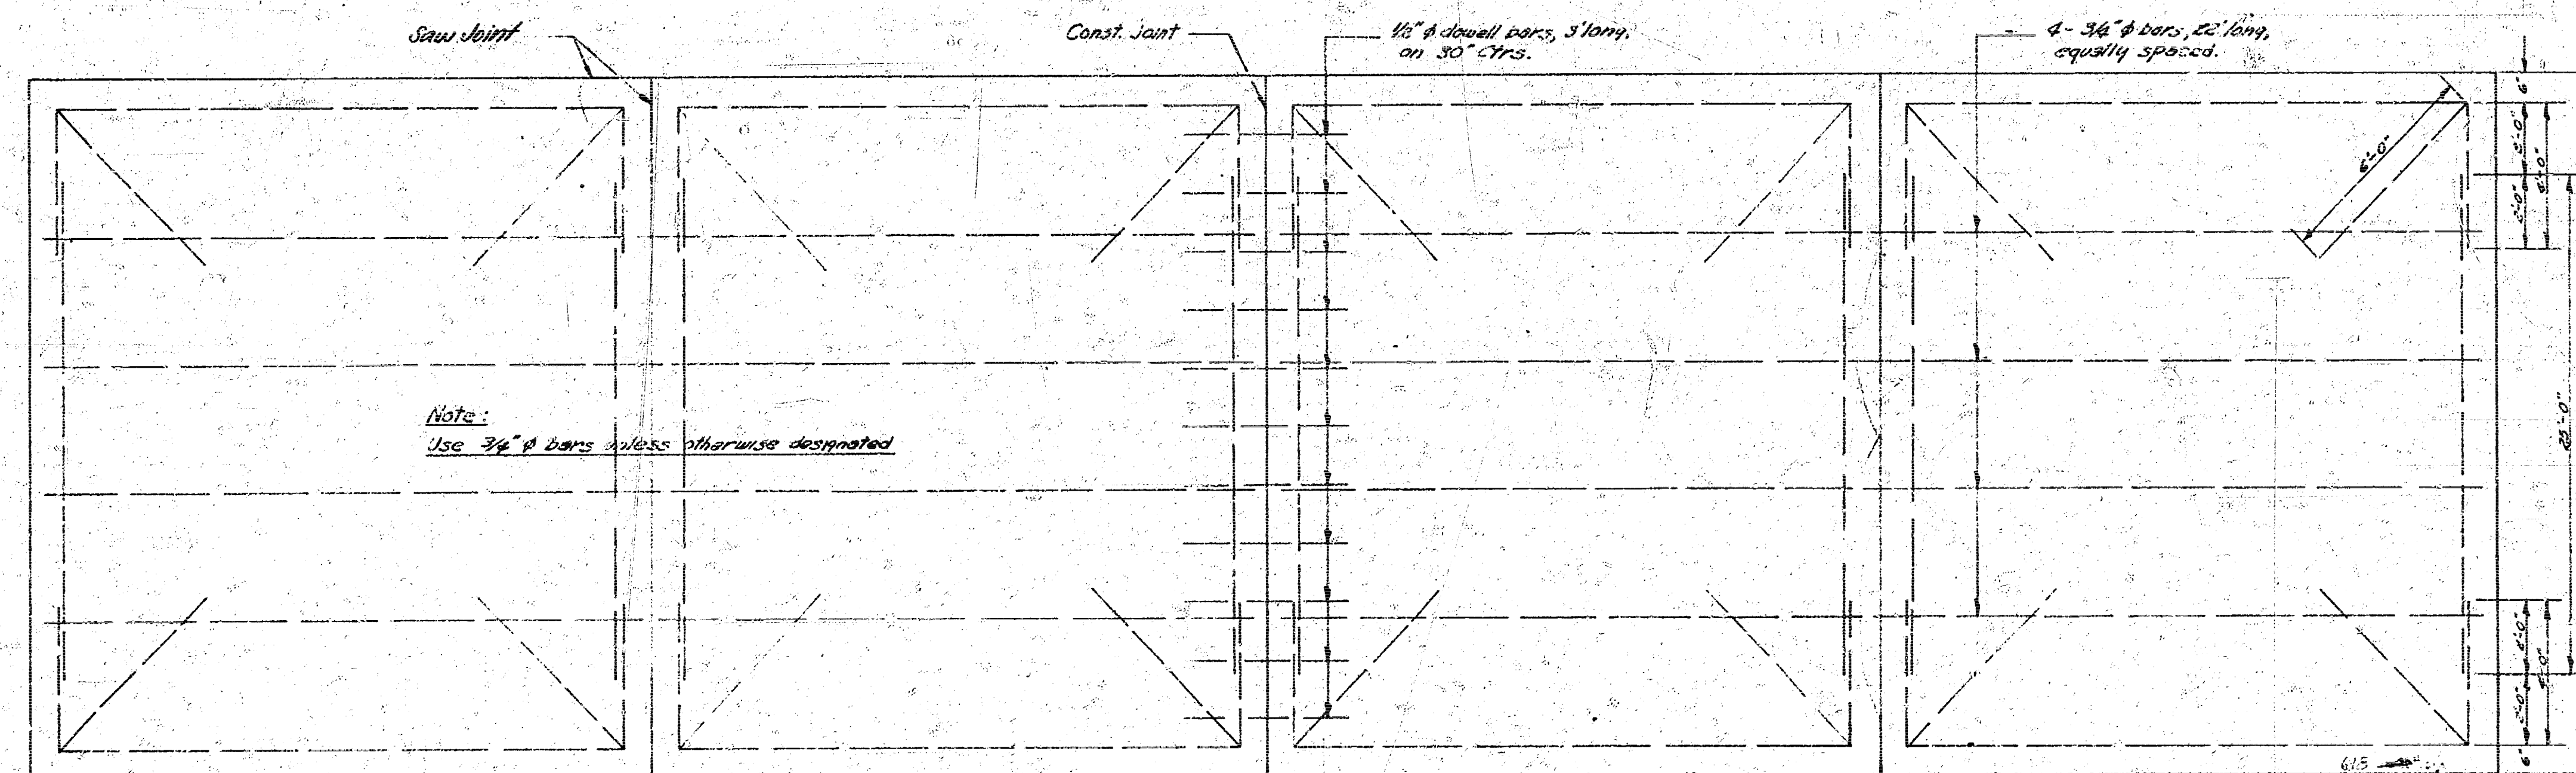



STEEL PATTERN
NO SCALE

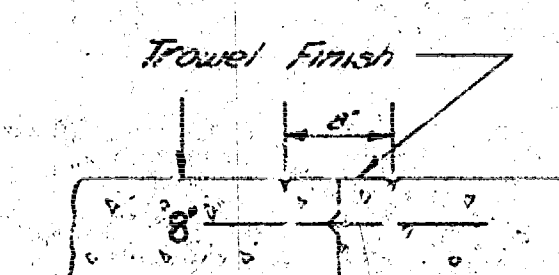



C.L. MARKER DETAIL
NO SCALE



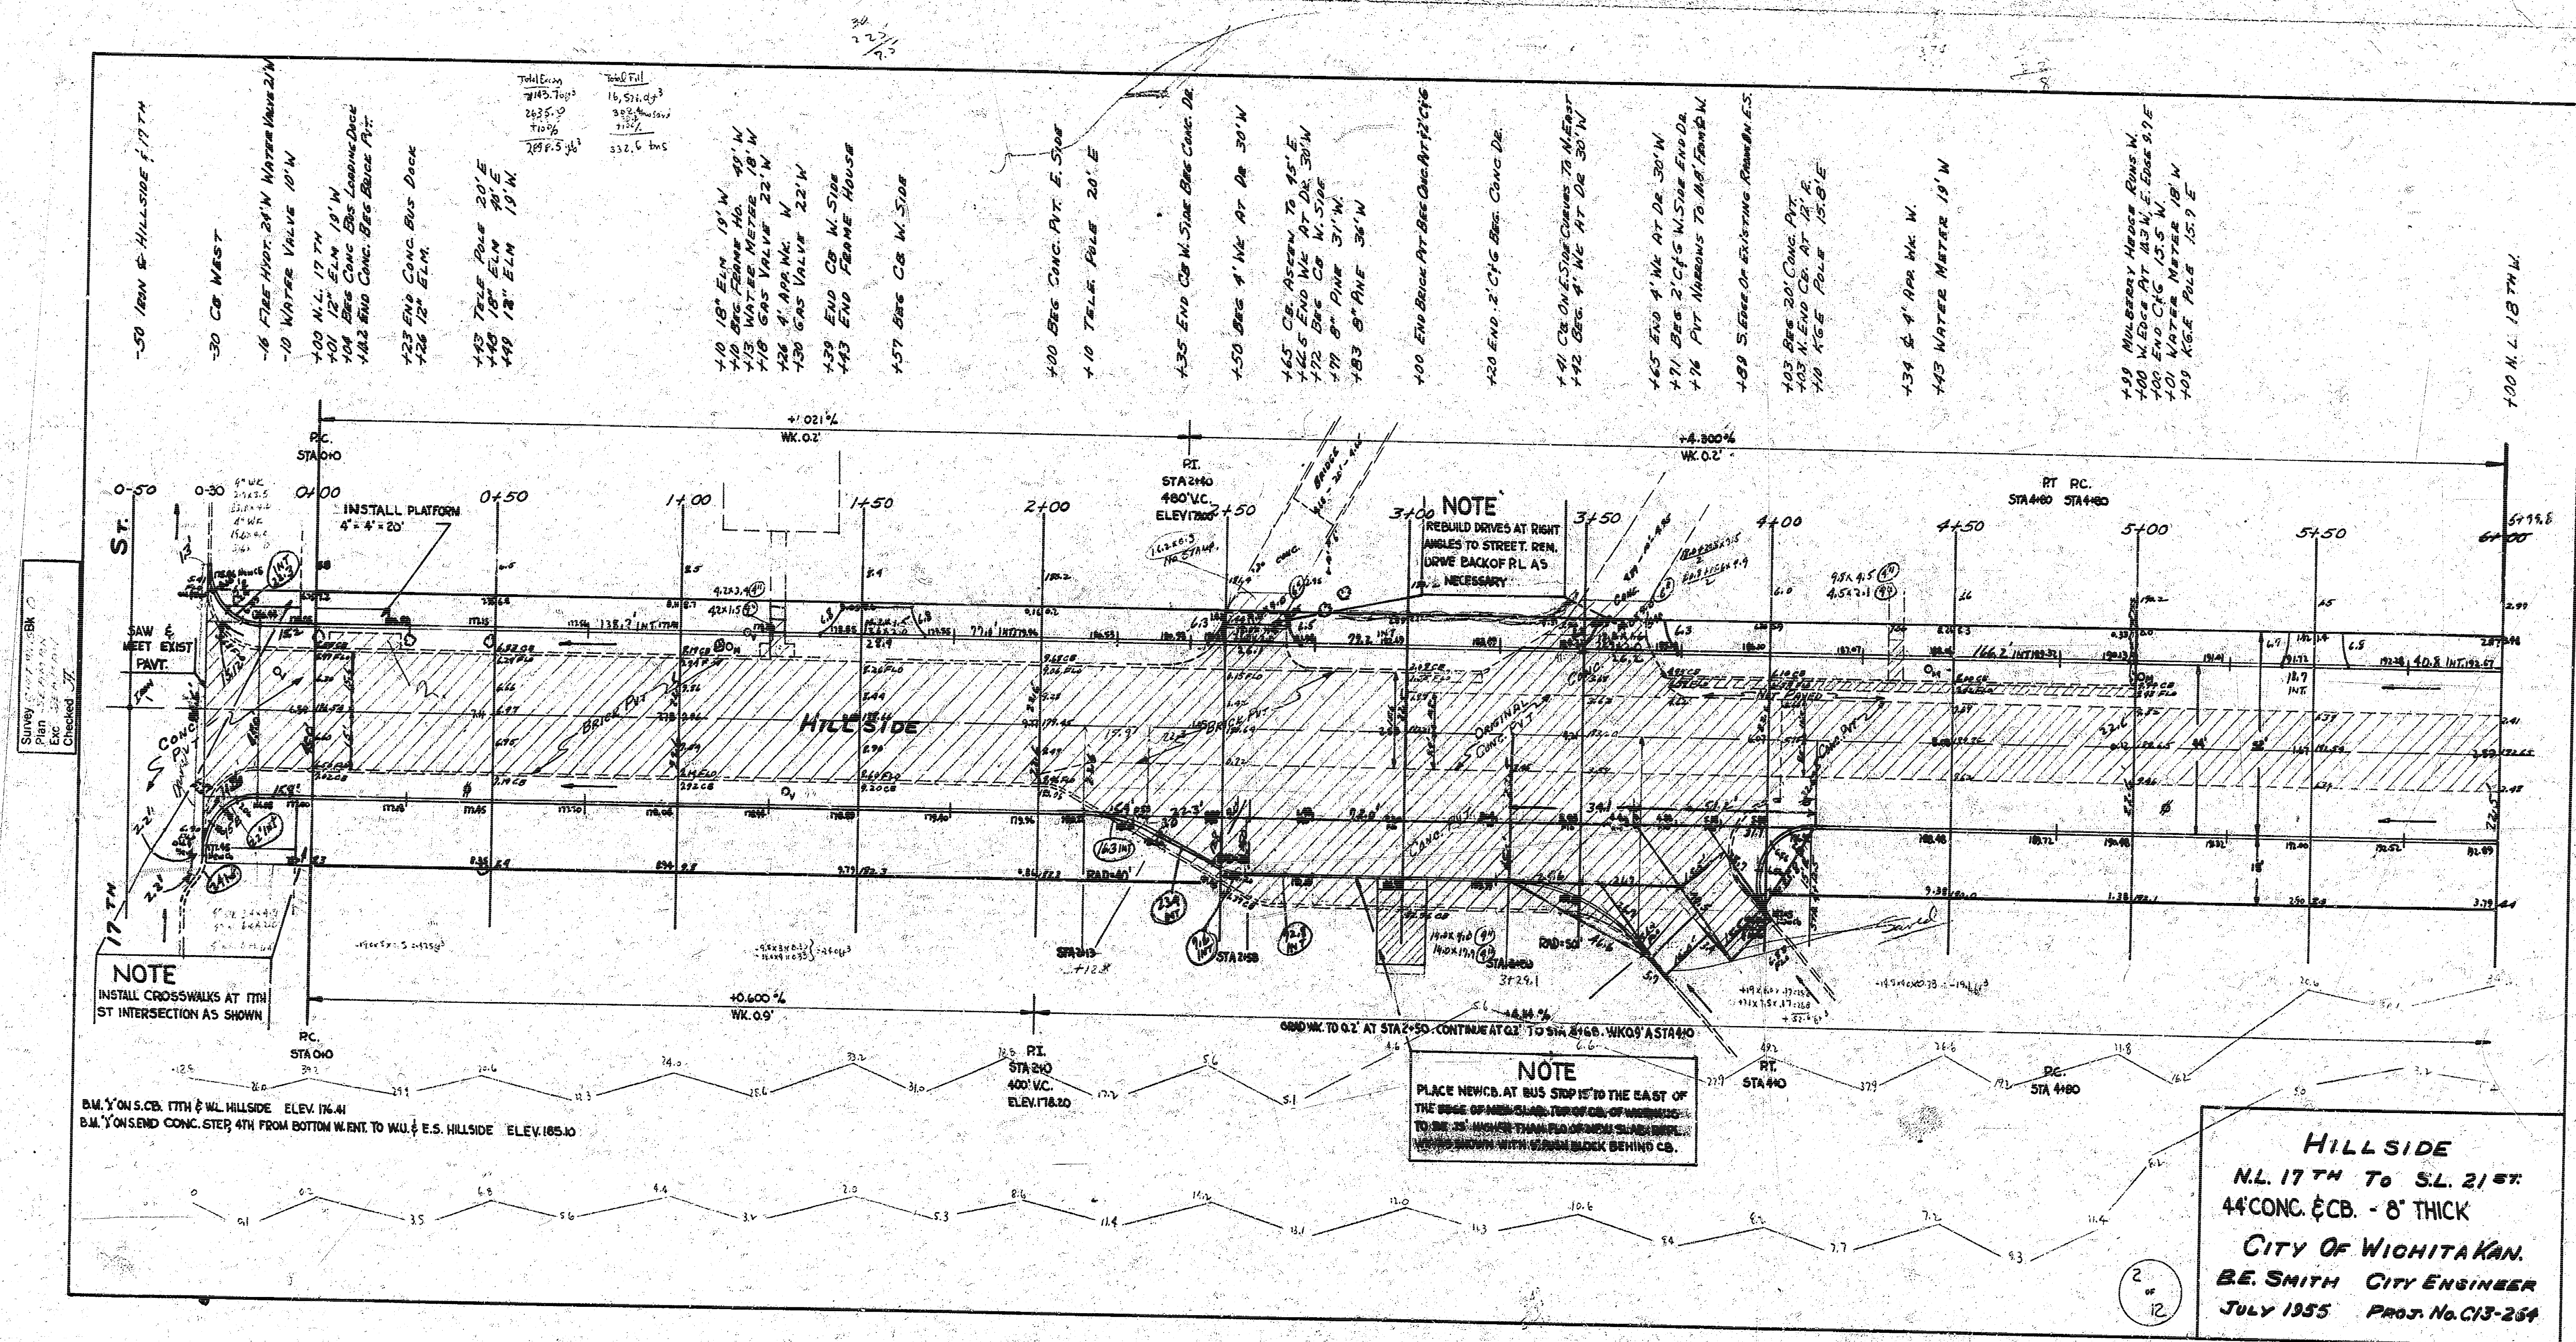


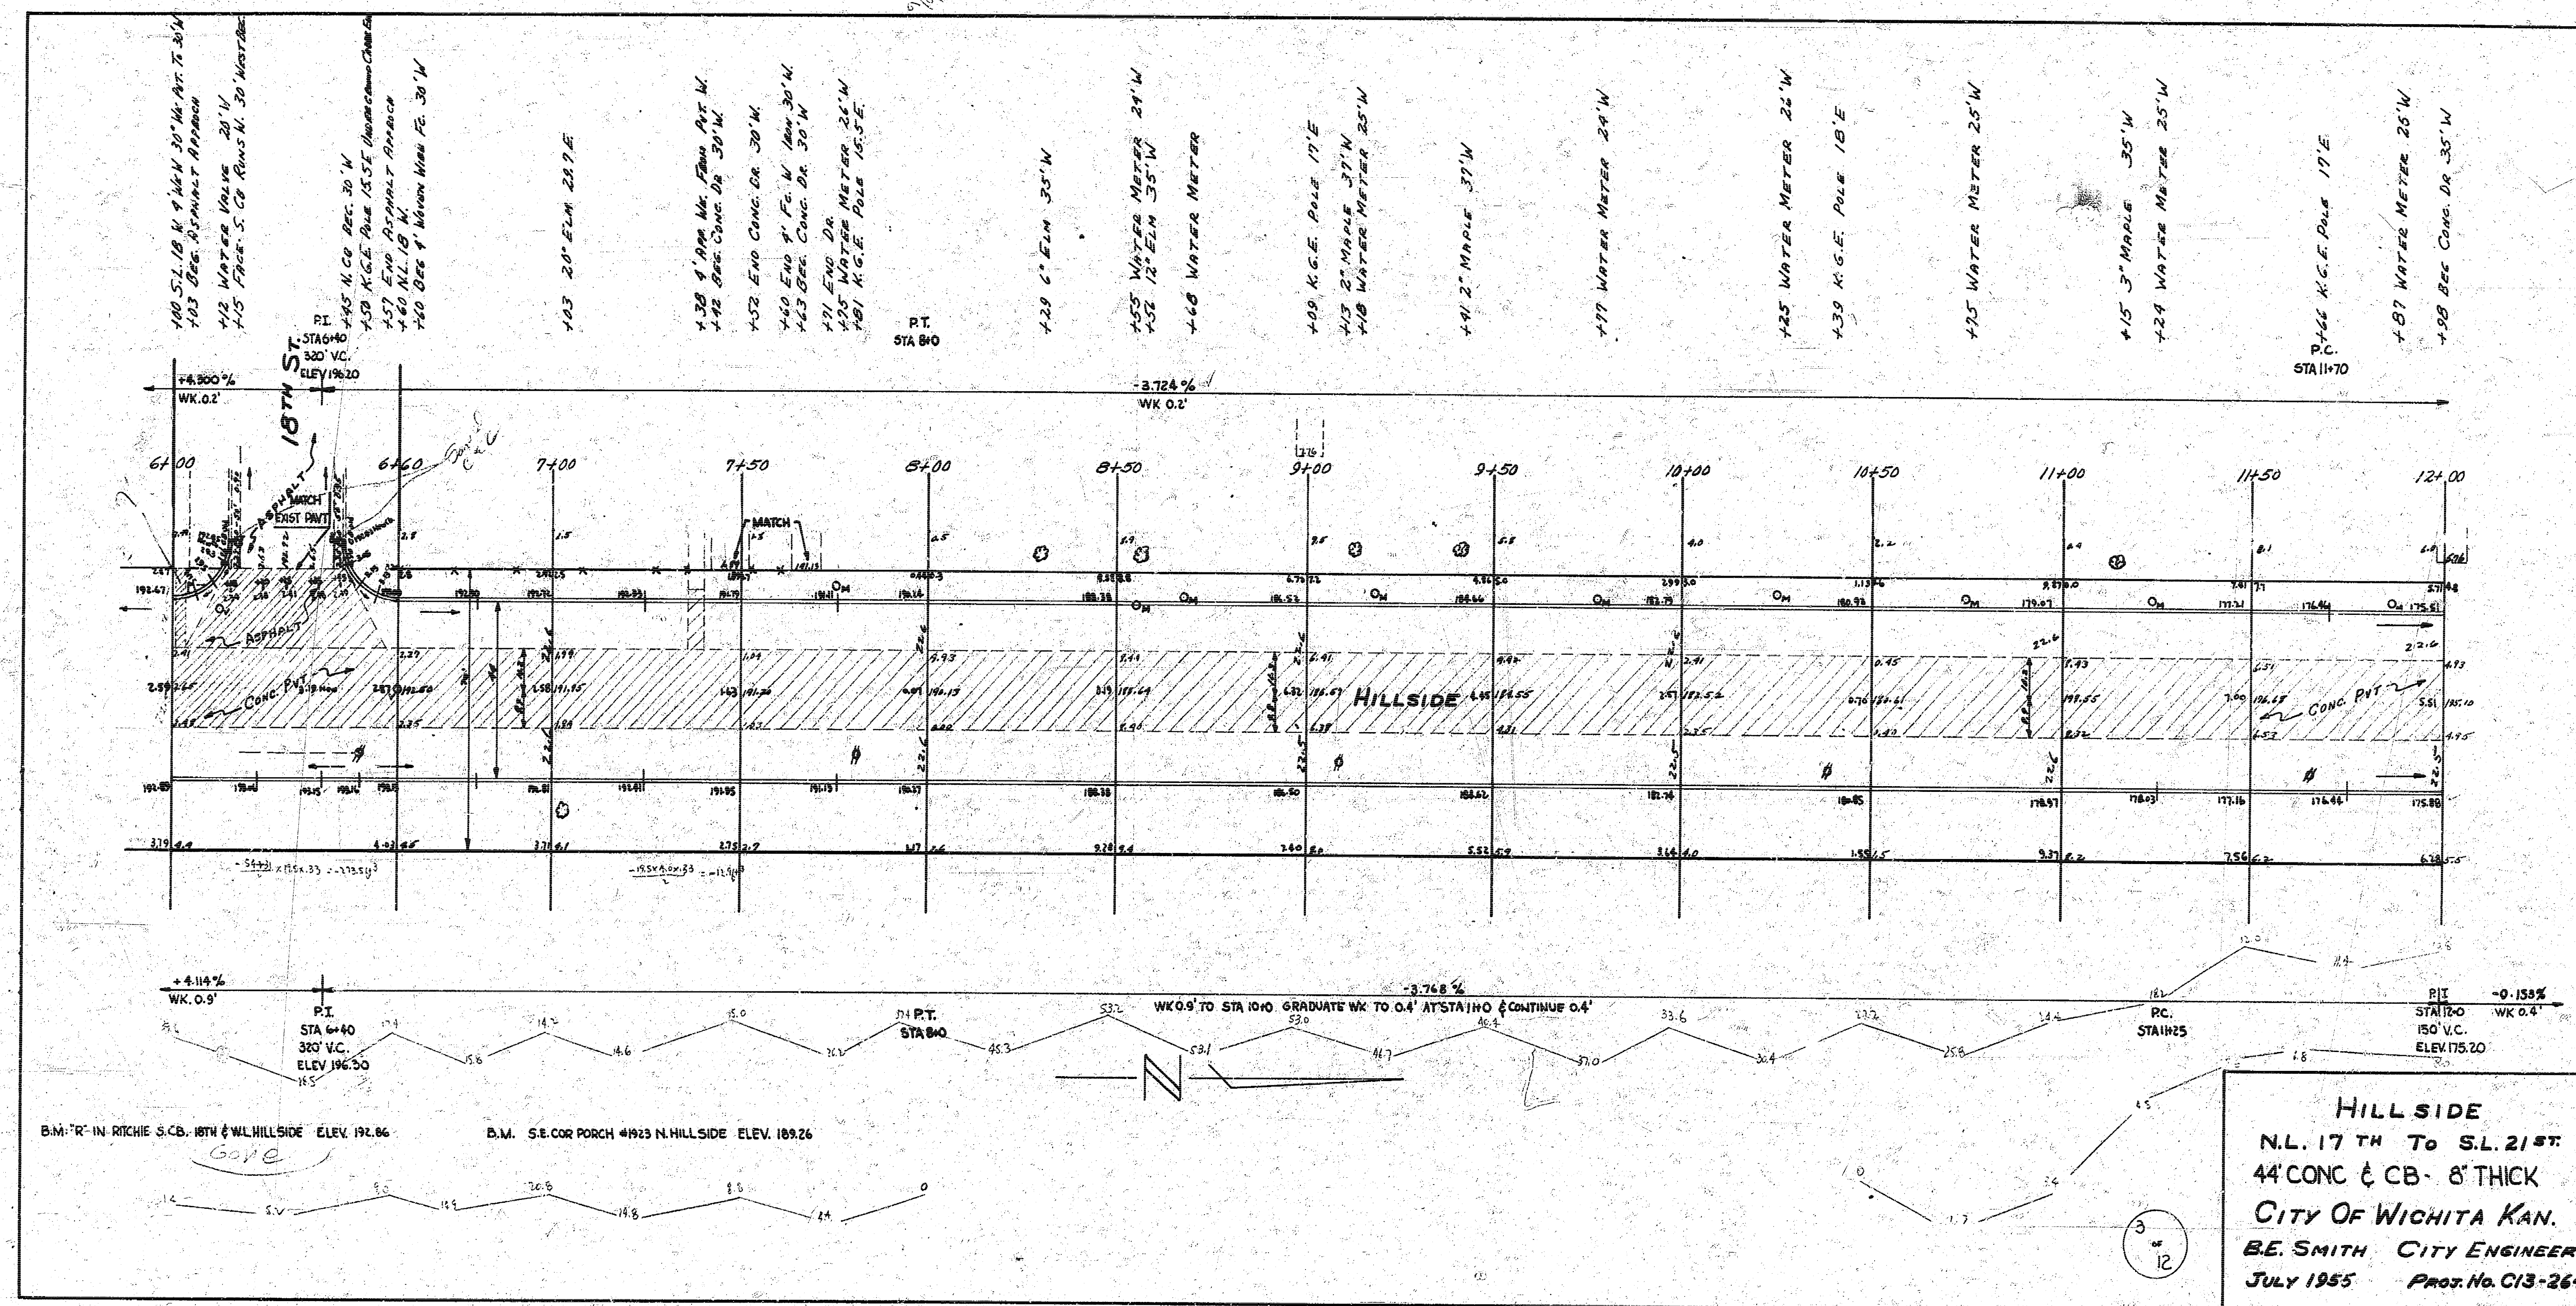

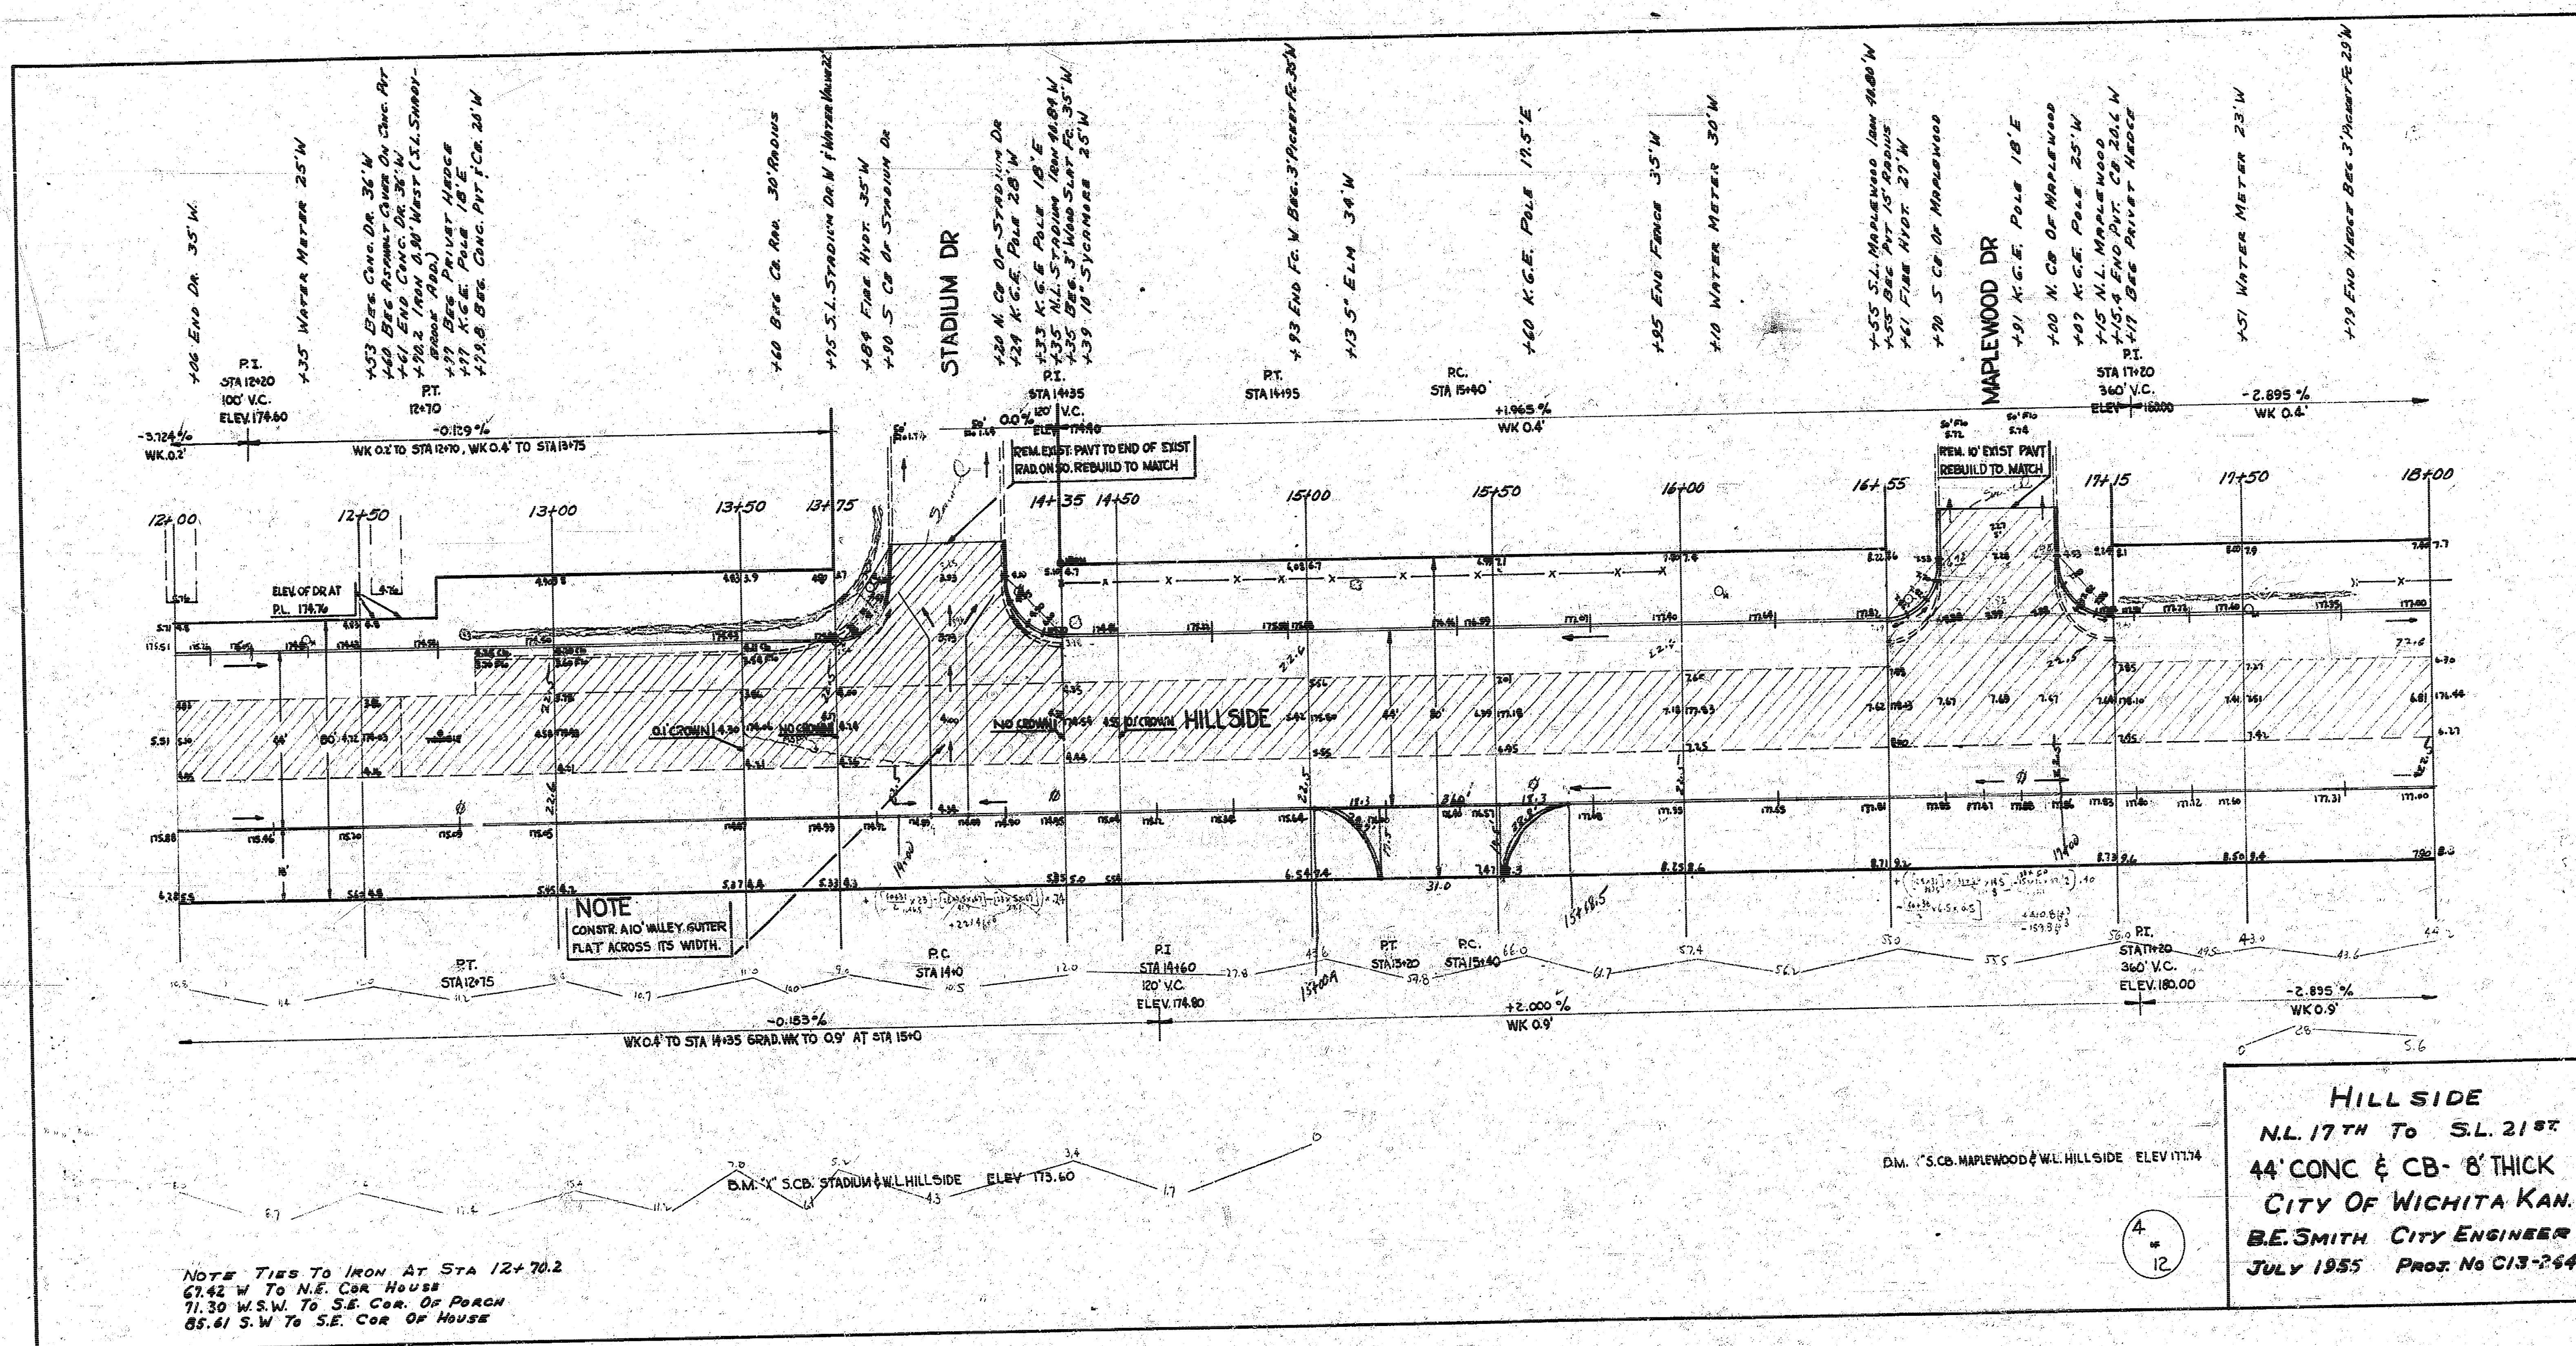


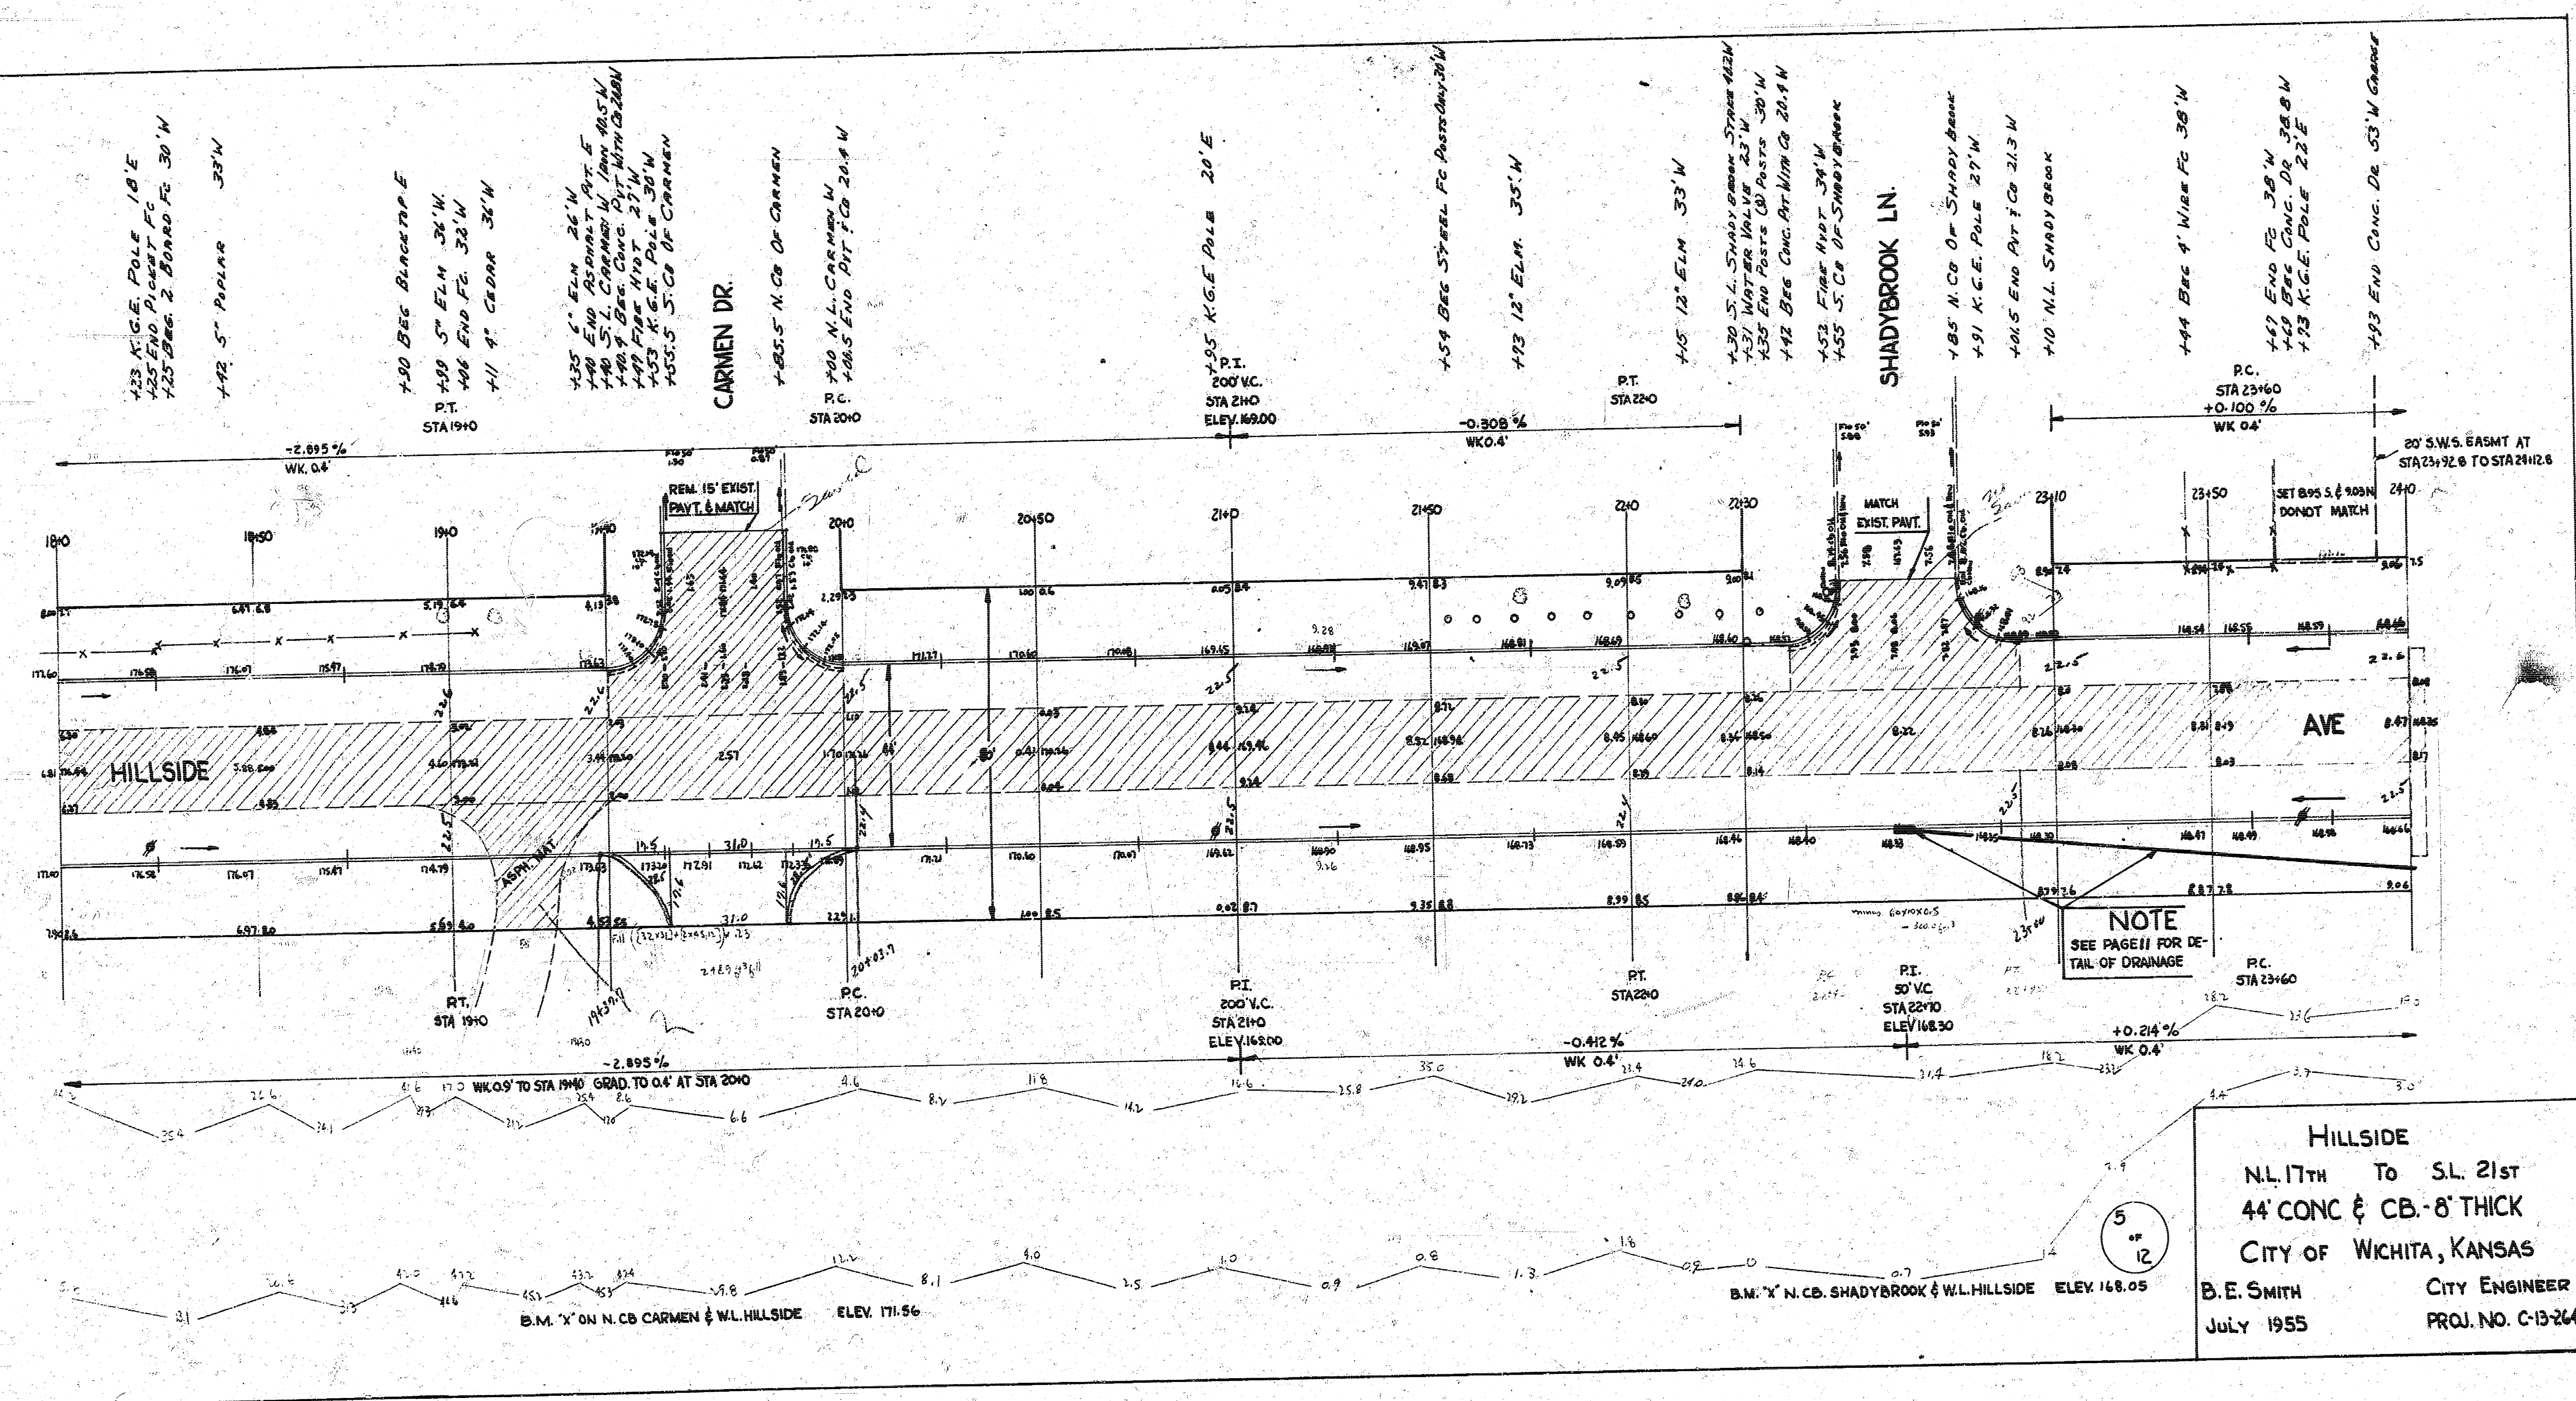


HILLSIDE
 N.L. 17th To S.L. 21st
 44' CONC & CB-8" THICK
 CITY OF WICHITA, KANSAS
 D.E. SMITH CITY ENGINEER
 JULY 1955 PROJ. NO. C-13-264

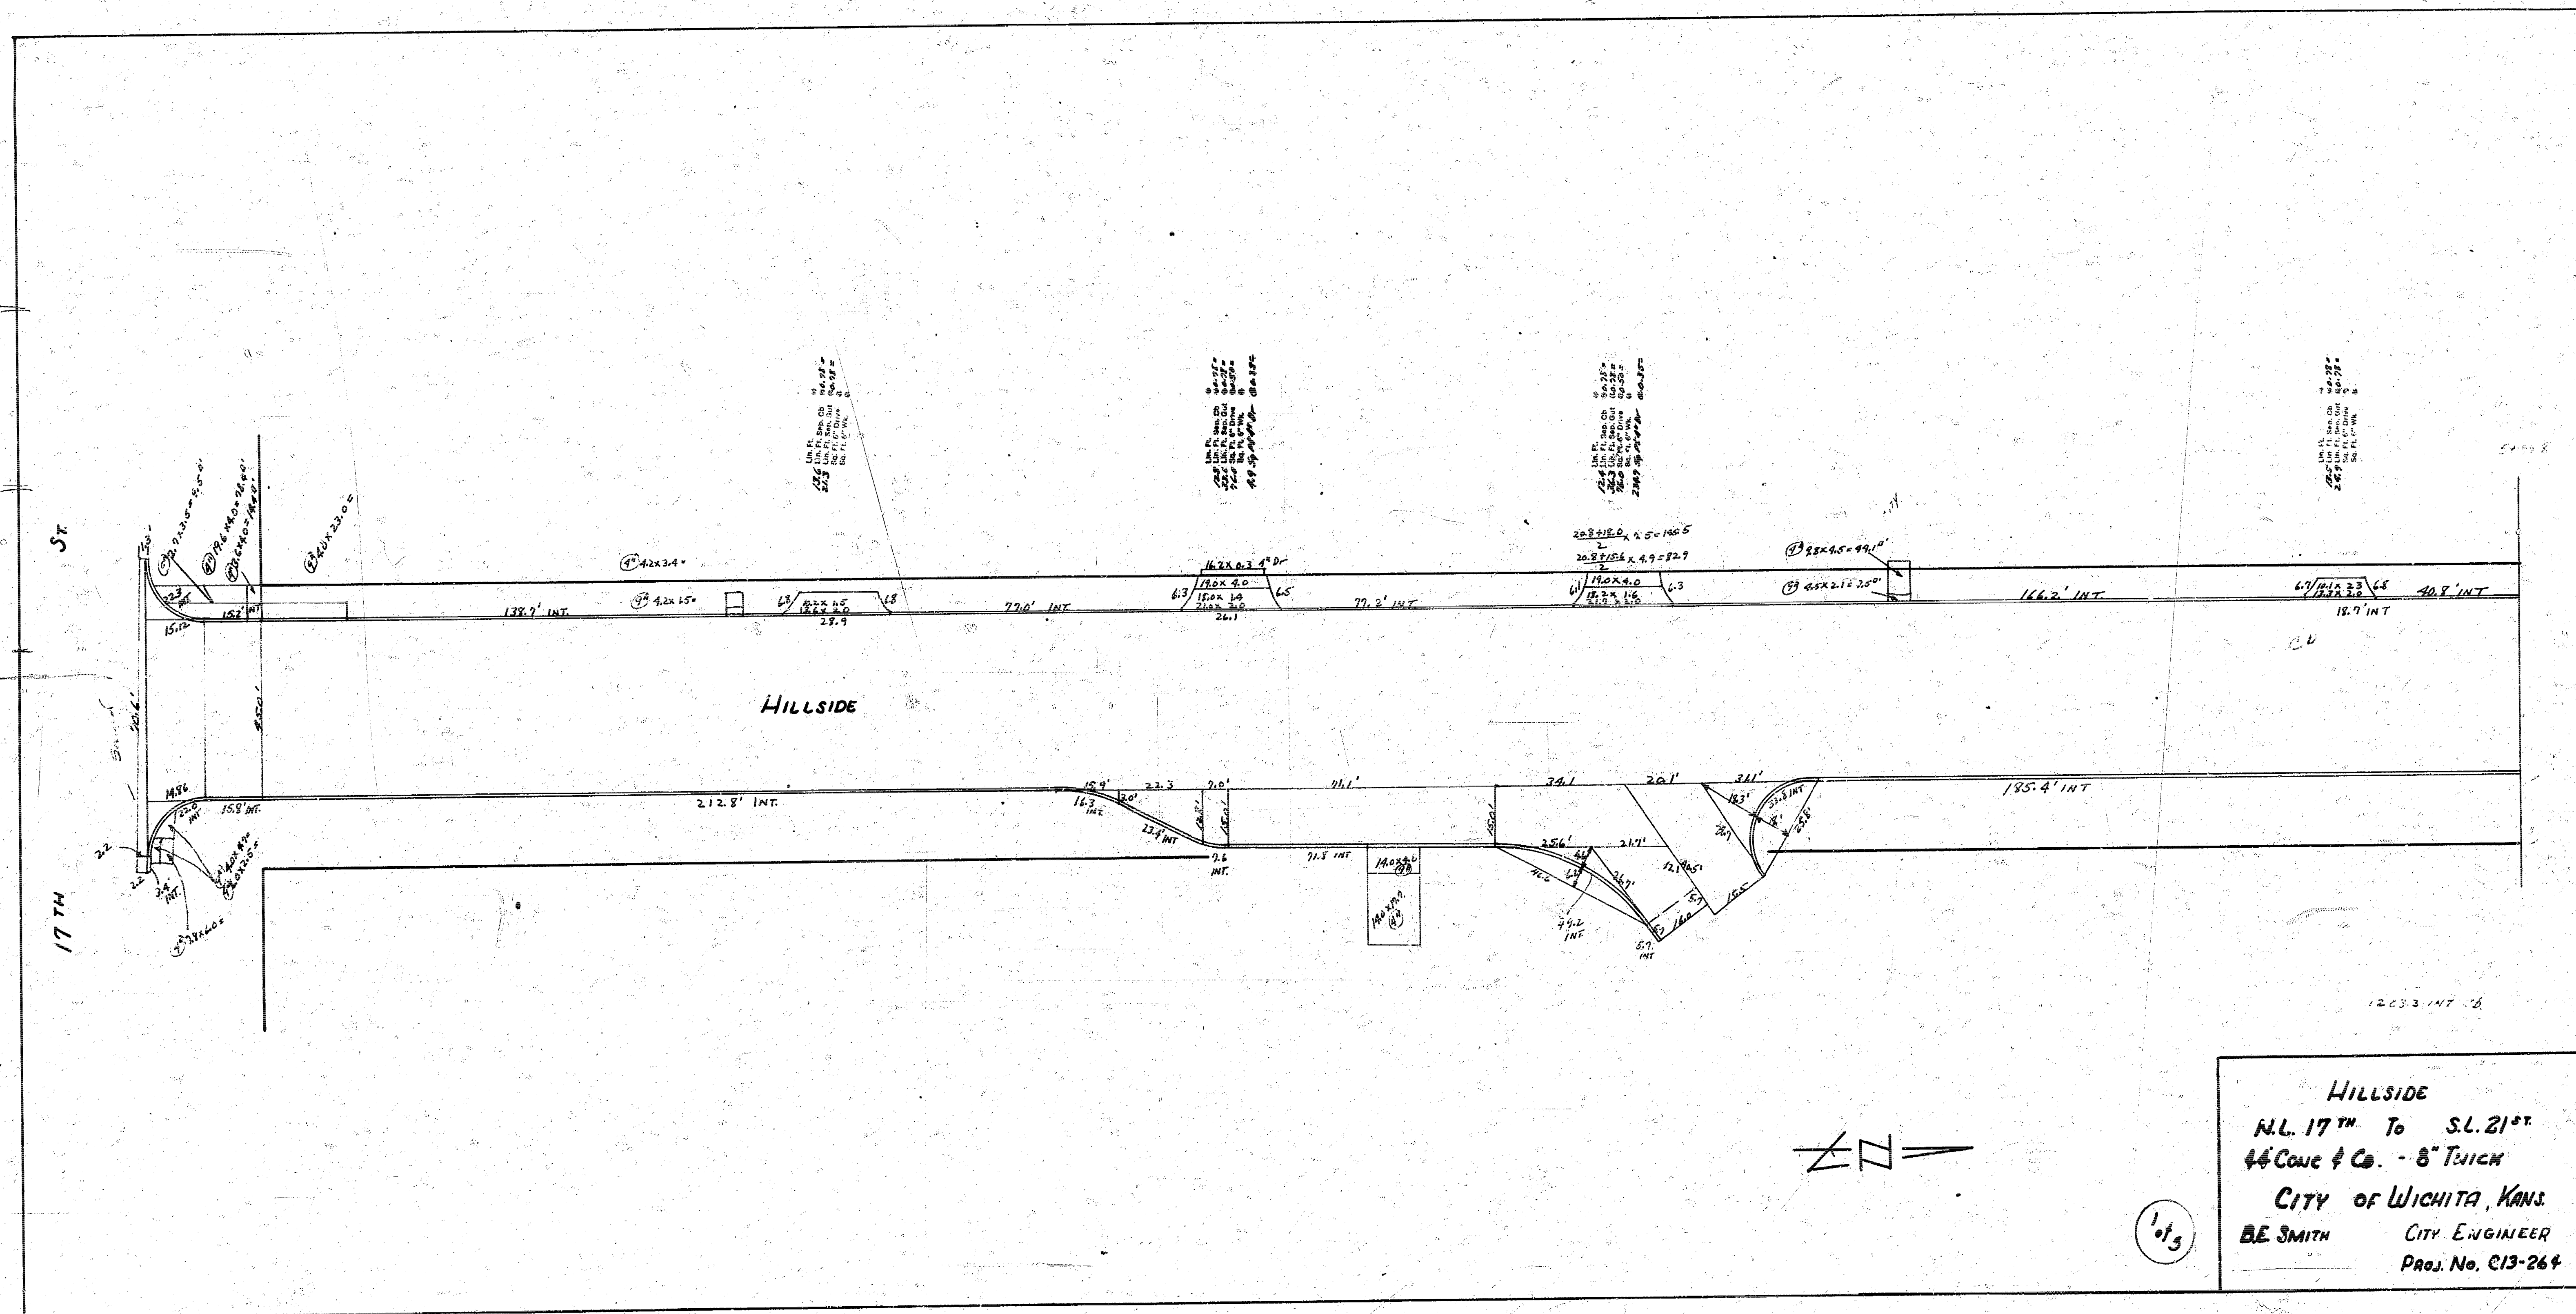

HILLSIDE
 H.L. 17TH To S.L. 21ST
 44" CONC. & CO. - 8" THICK
 CITY OF WICHITA, KANS.
 BE SMITH CITY ENGINEER
 Proj. No. C13-264

10/3

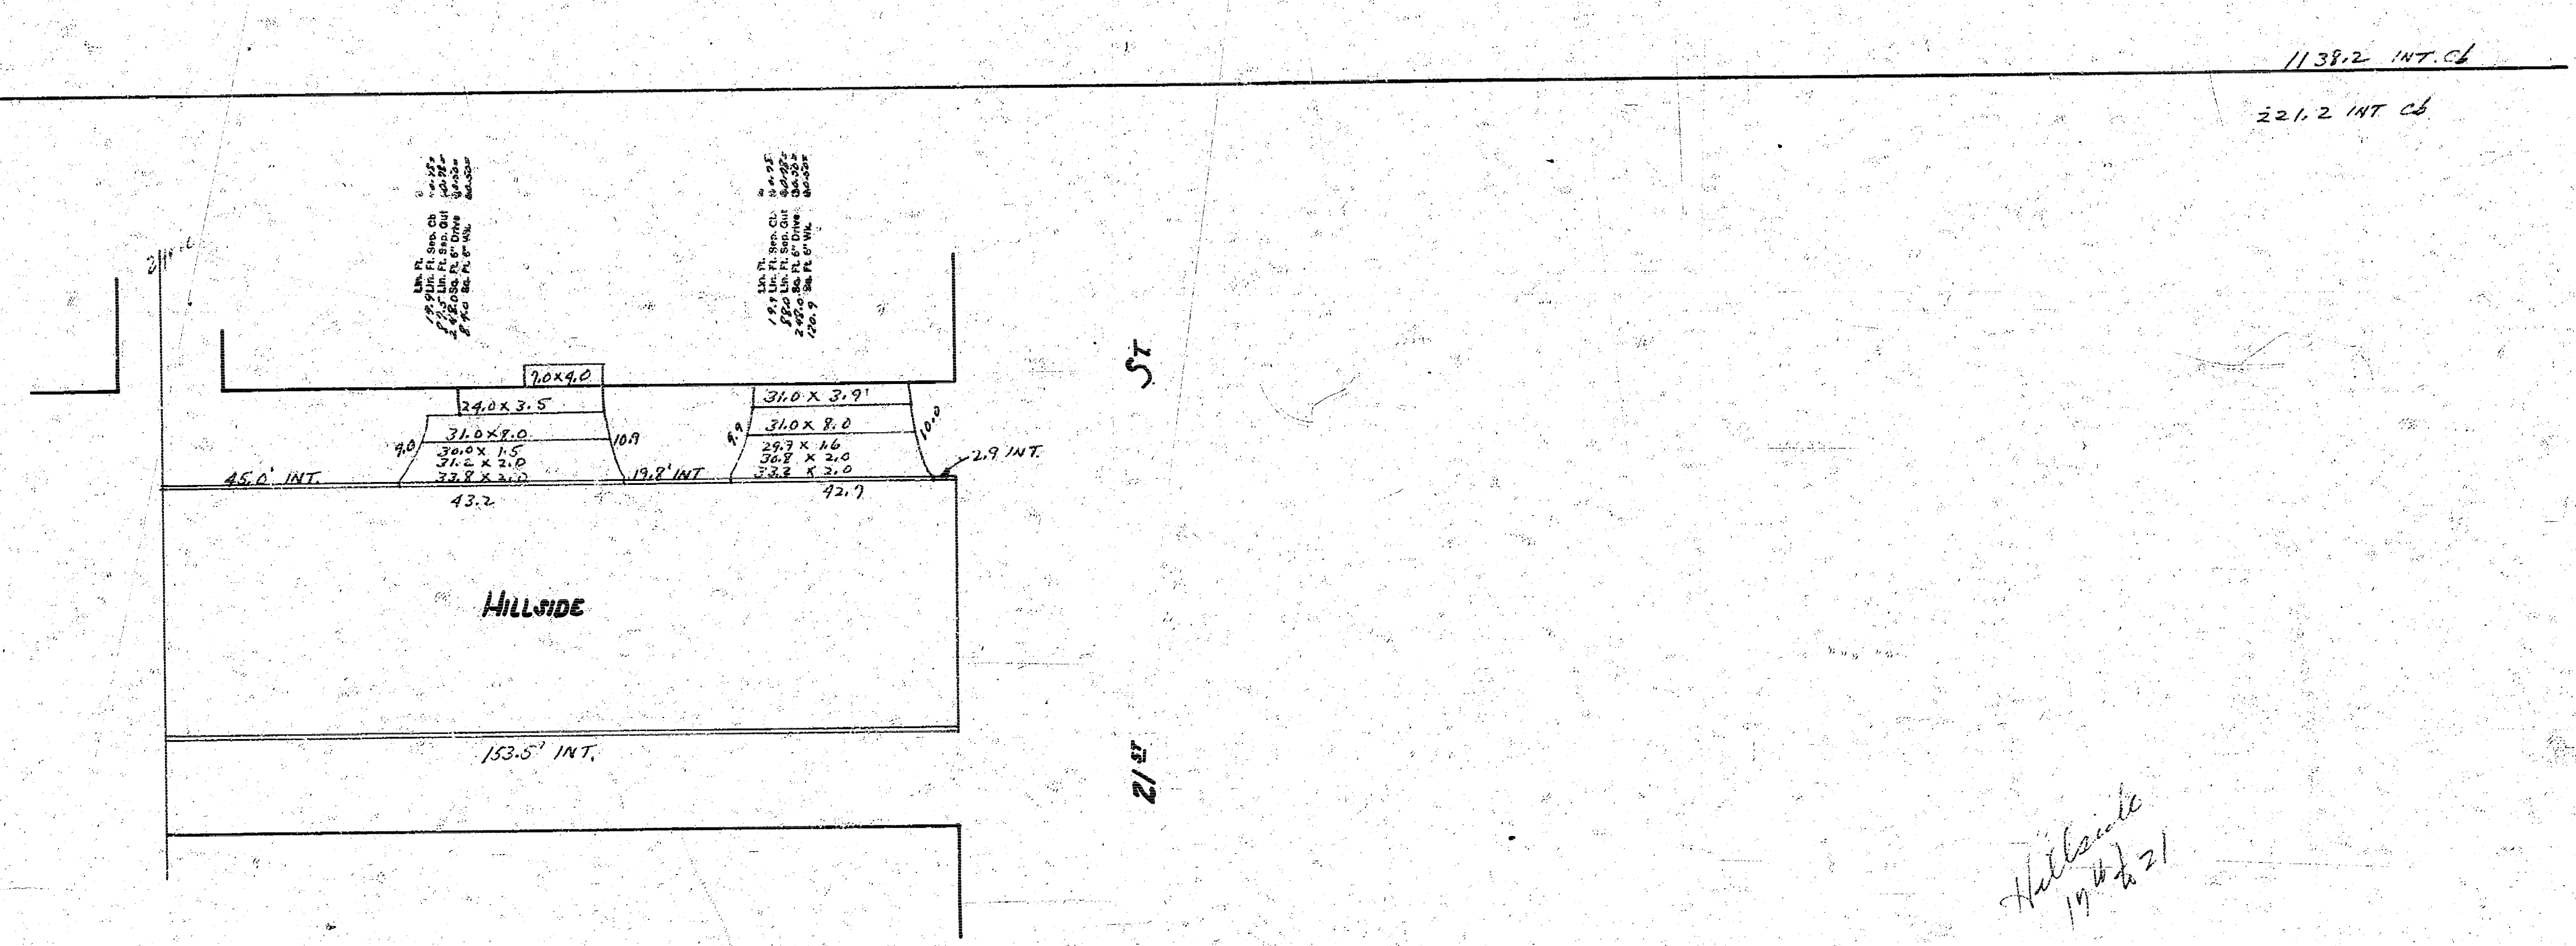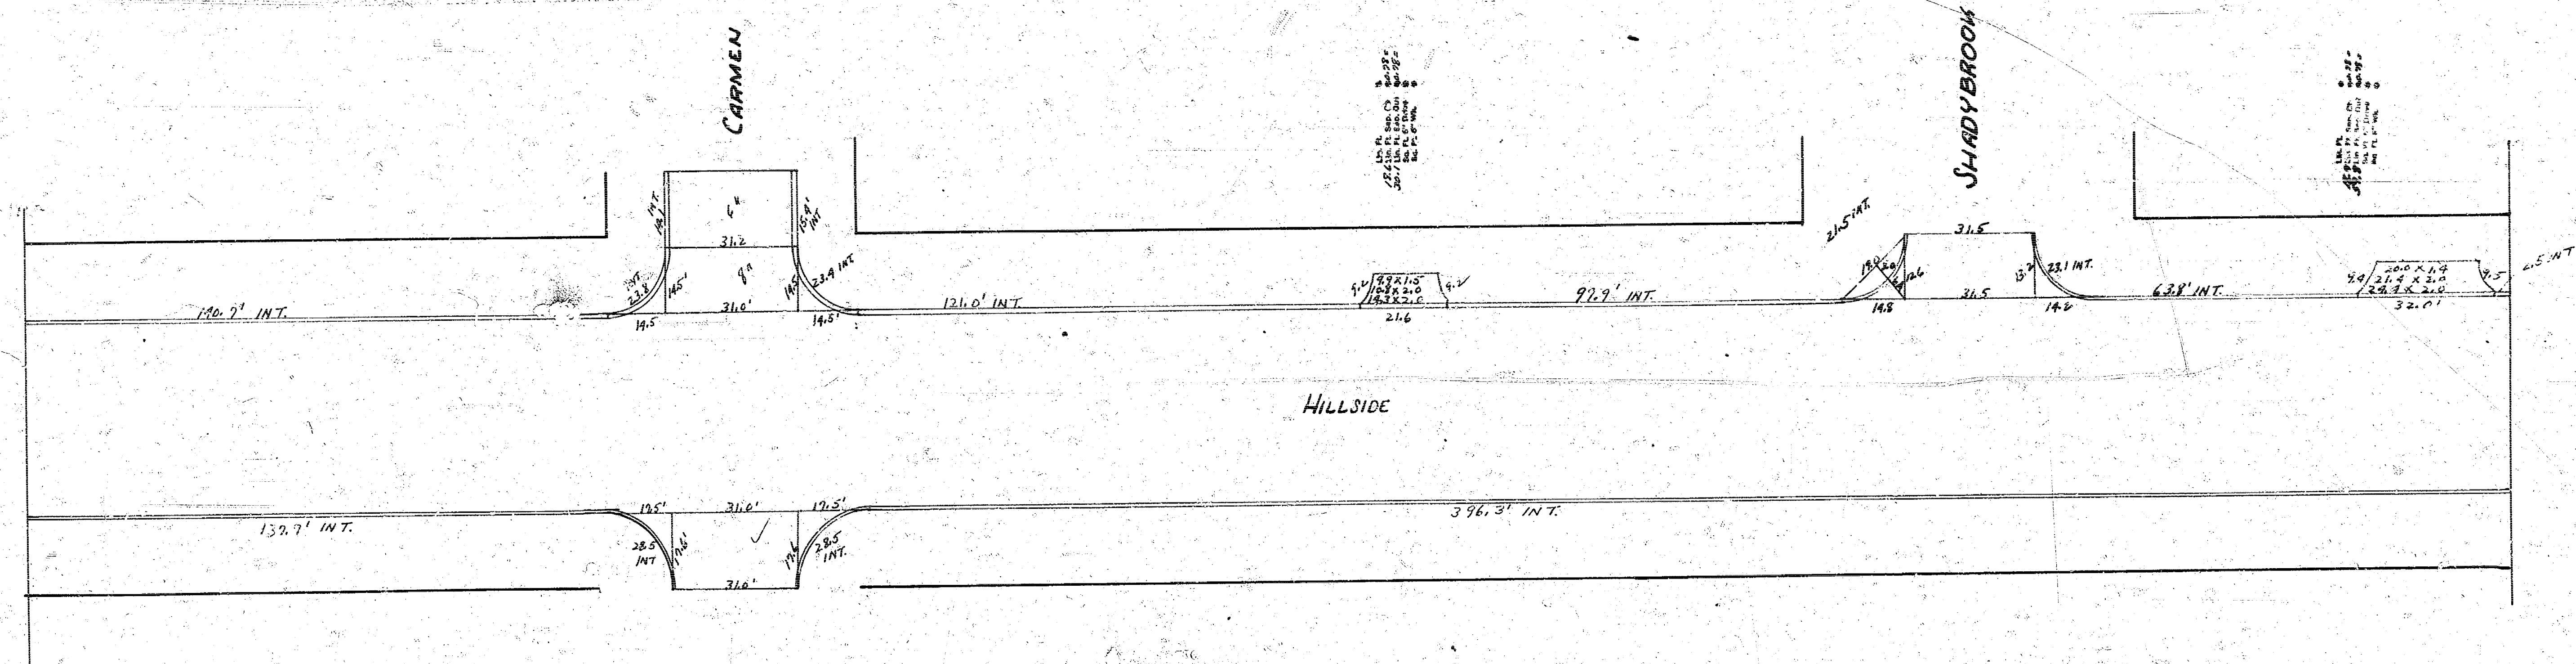

Hillside
19th & 21st



