

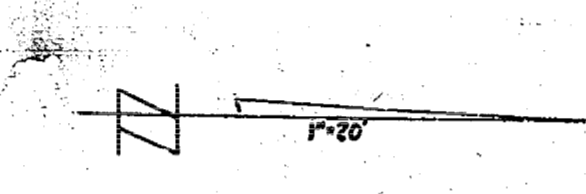


Sta On E. R.
 B.M. 9664 NE Cor Of 1st Conc. Str. Ho. NW Cor Hiram 4 33rd St. So.

	EXCAV	PROP.	FILL	PROP.
CITY			CITY	
249 CY		2032.9 CY	405 CY	237 CY
7.5	100%	203.3		
27.4 CY		2236.2 CY	20 TRAS	15 TRAS

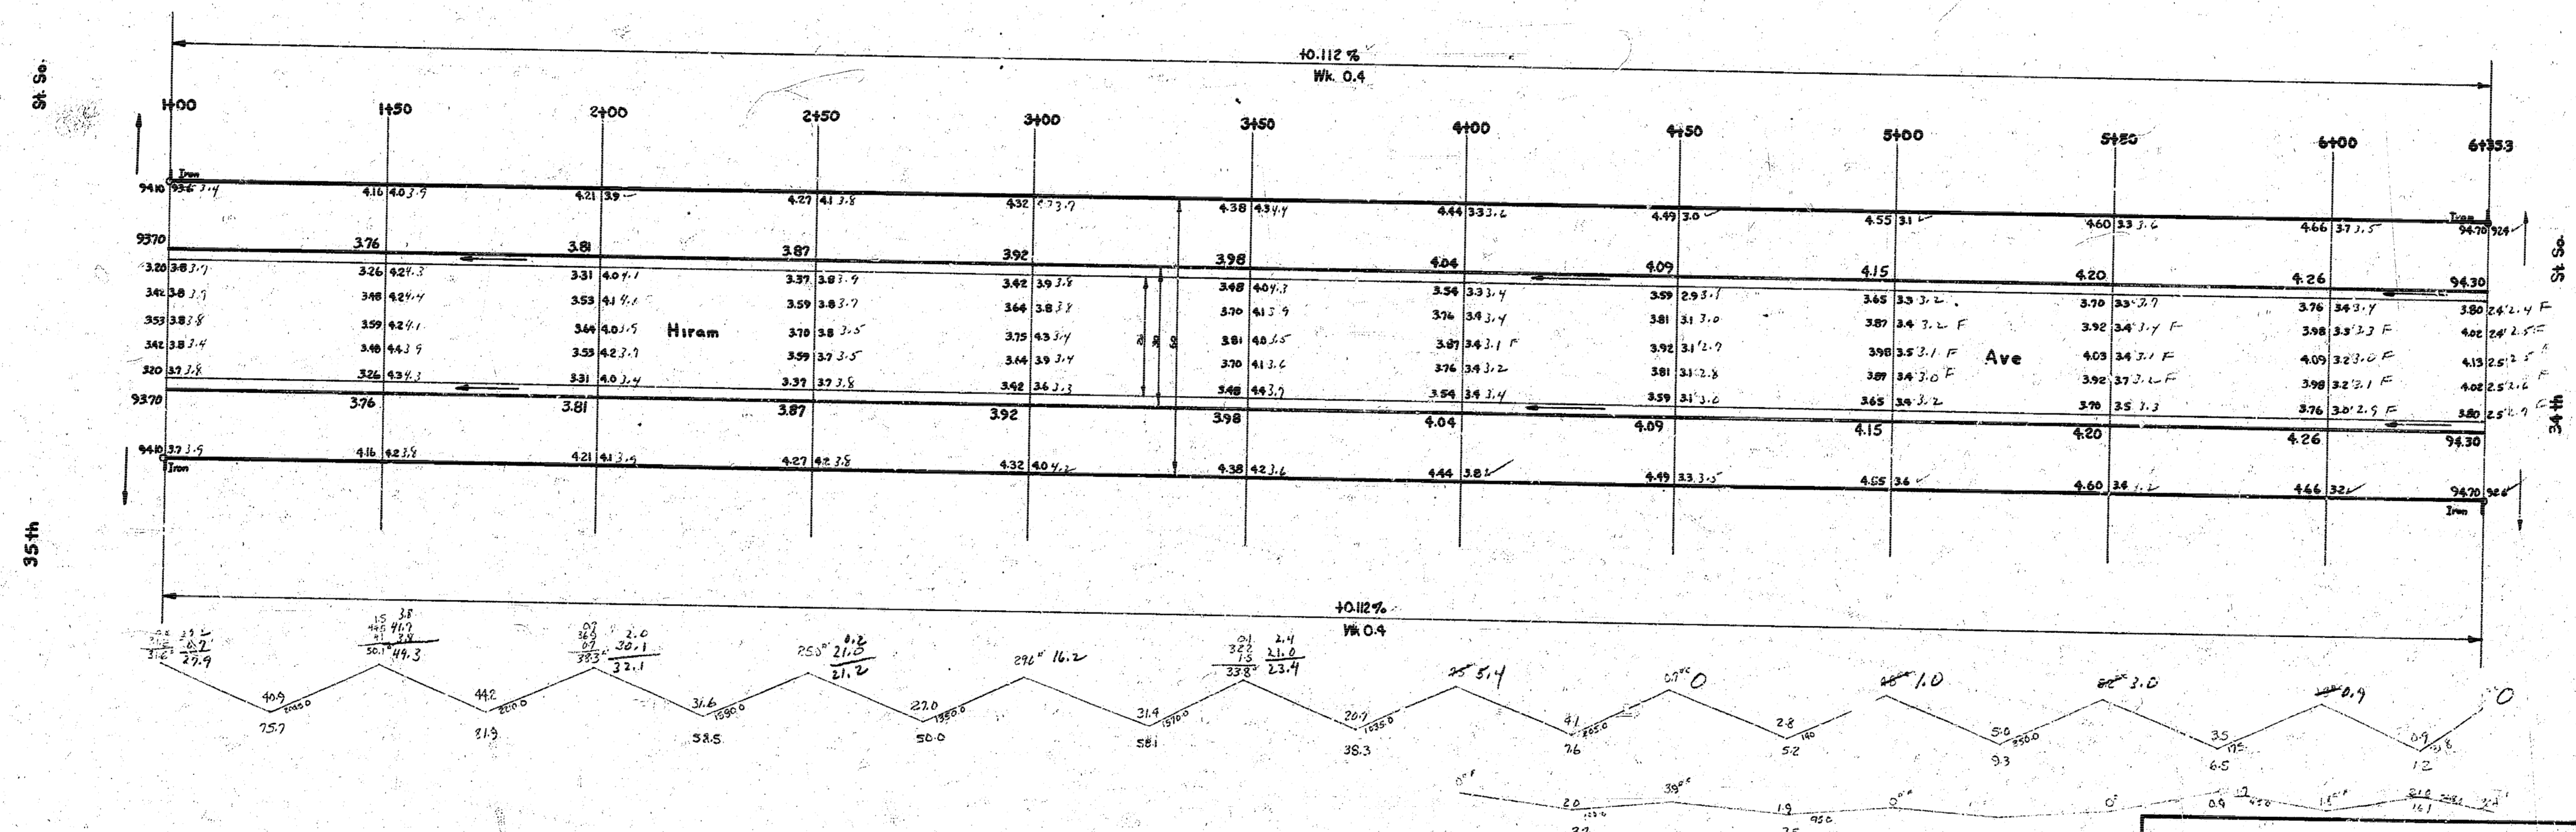


Young BK 113-y
 Survey Return
 Exc. Return
 Checked

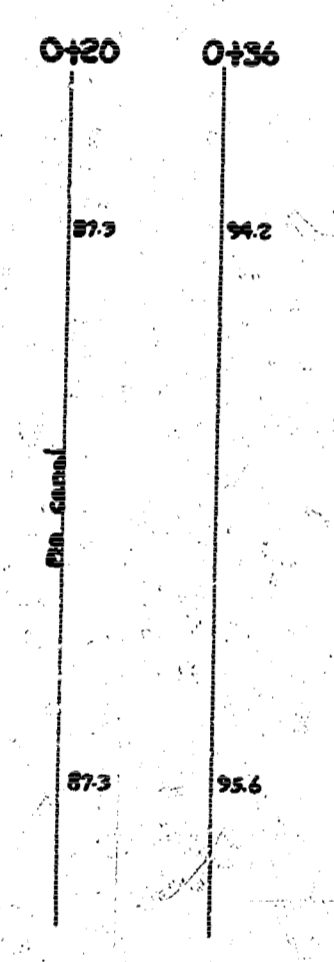

1/2

HIRAM
 NL 35th St. So. To SL 33rd St. So.
 26-2-30 AC
 City Of Wichita, Kansas
 B.E. Smith City Engineer
 Feb. 1956 Proj. No. C 15-73

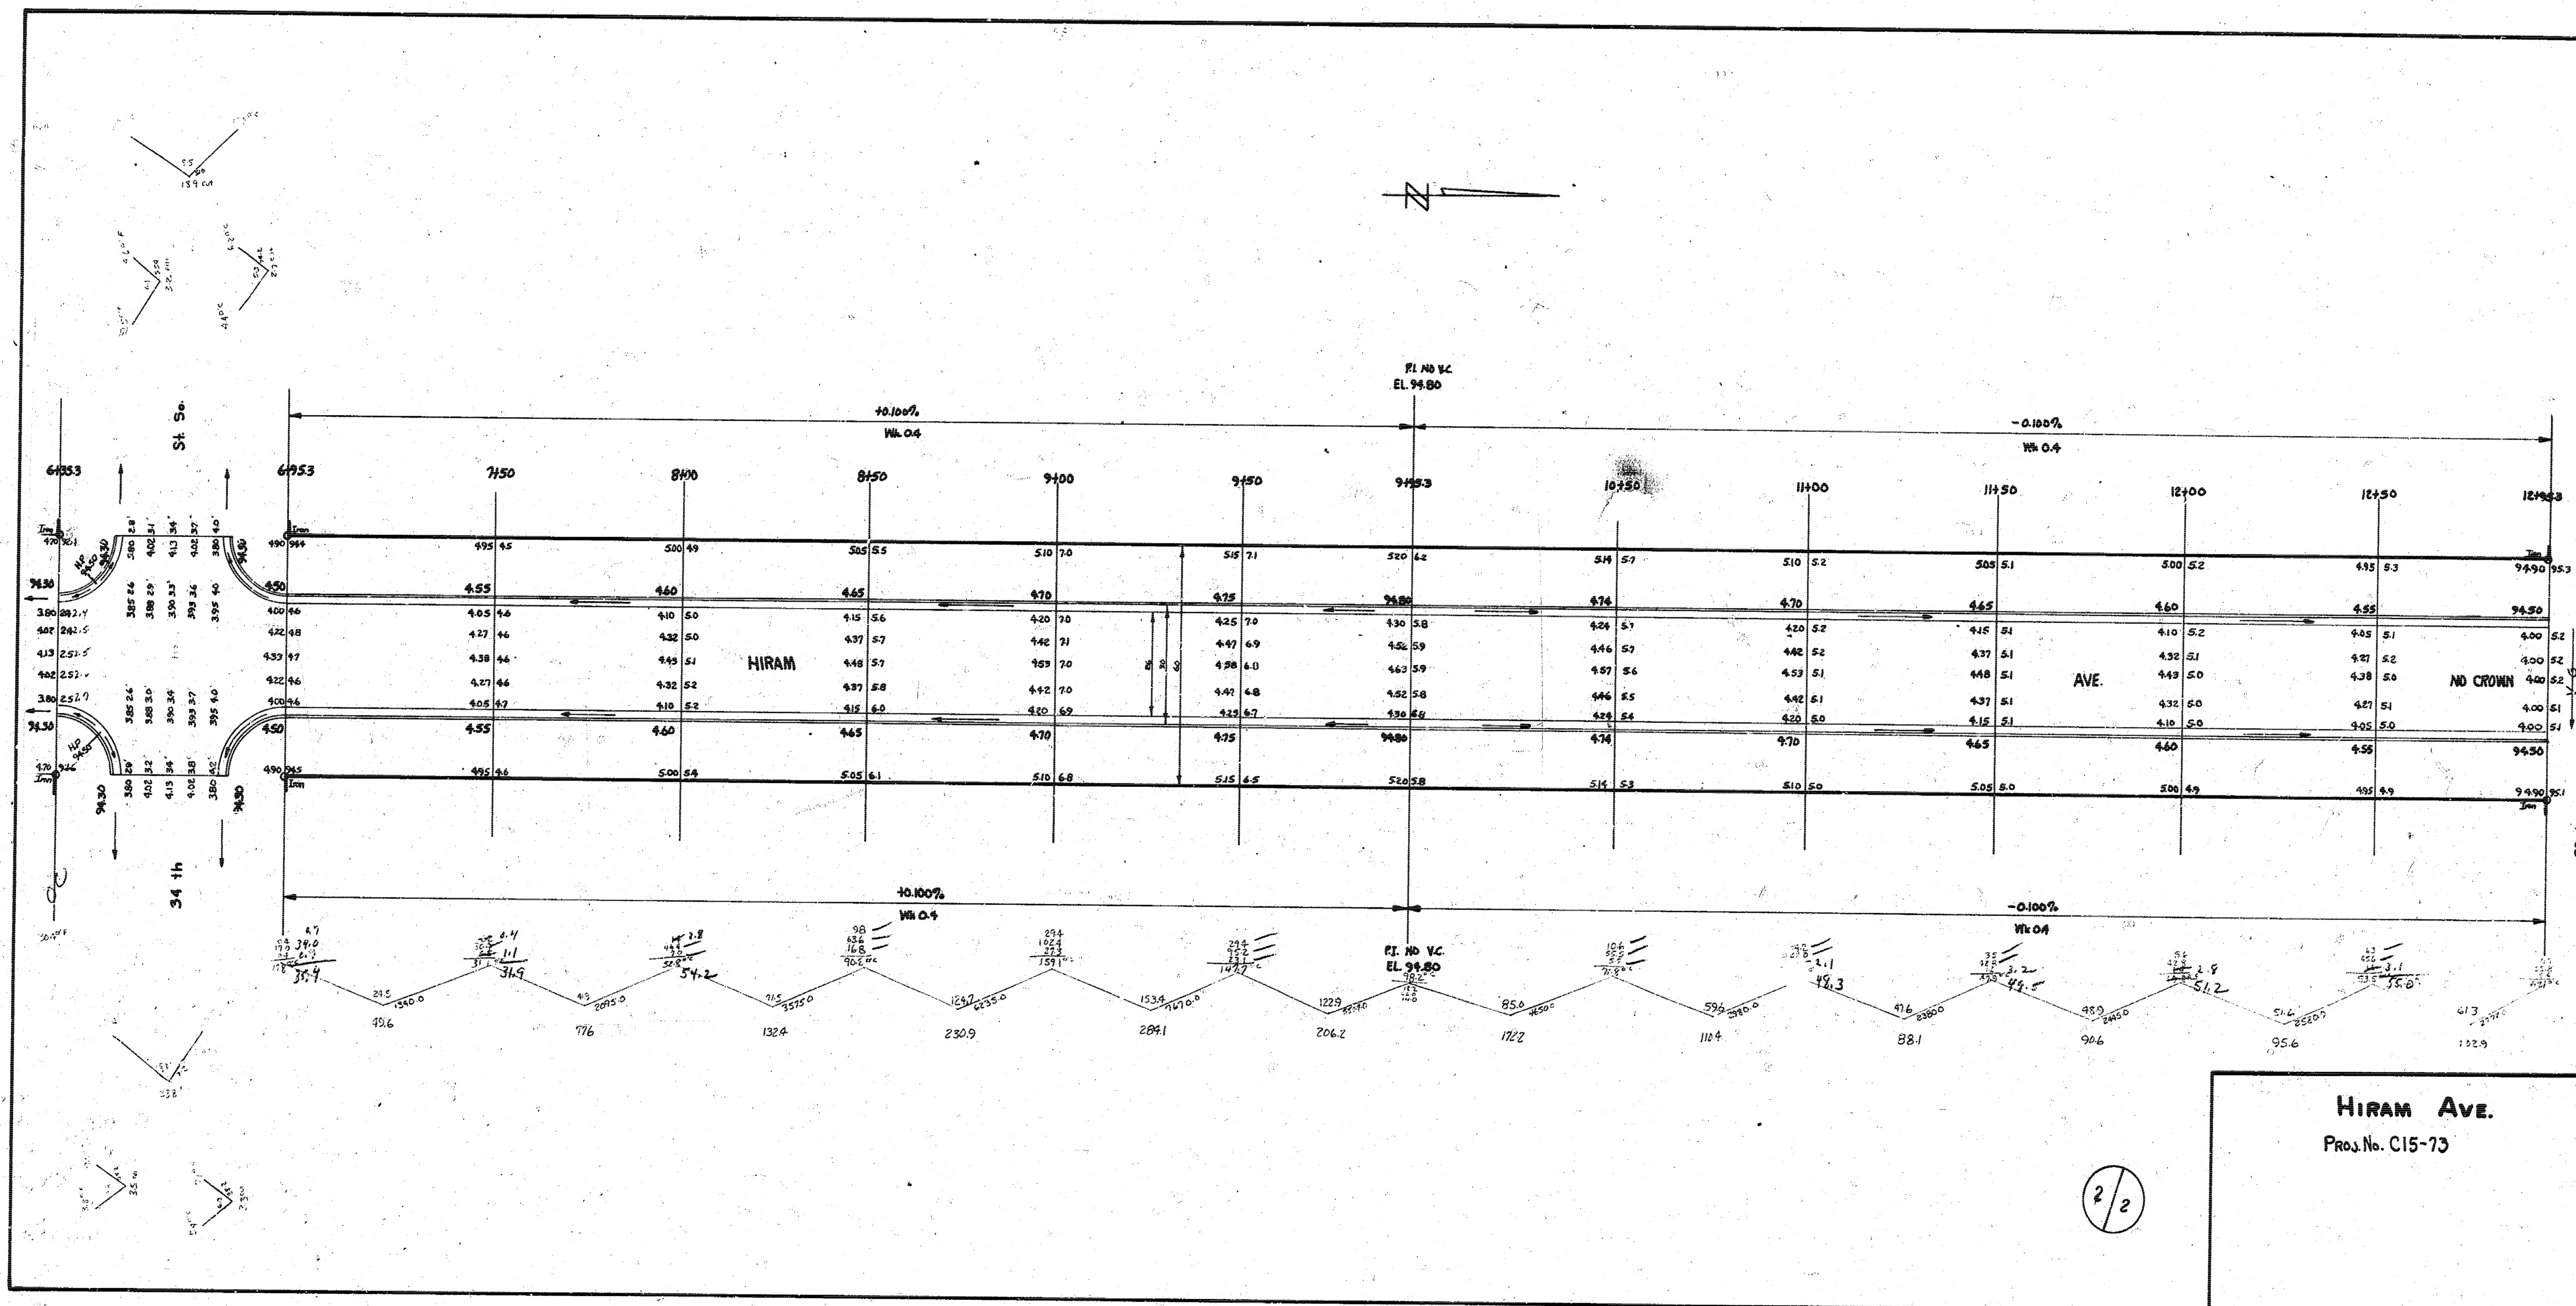

HIRAM AVE.
 Proj. No. C15-73

2/2