


NOTE  
SEE PAGE 11 FOR DETAIL OF  
DRAINAGE AT STA. 24+10.2

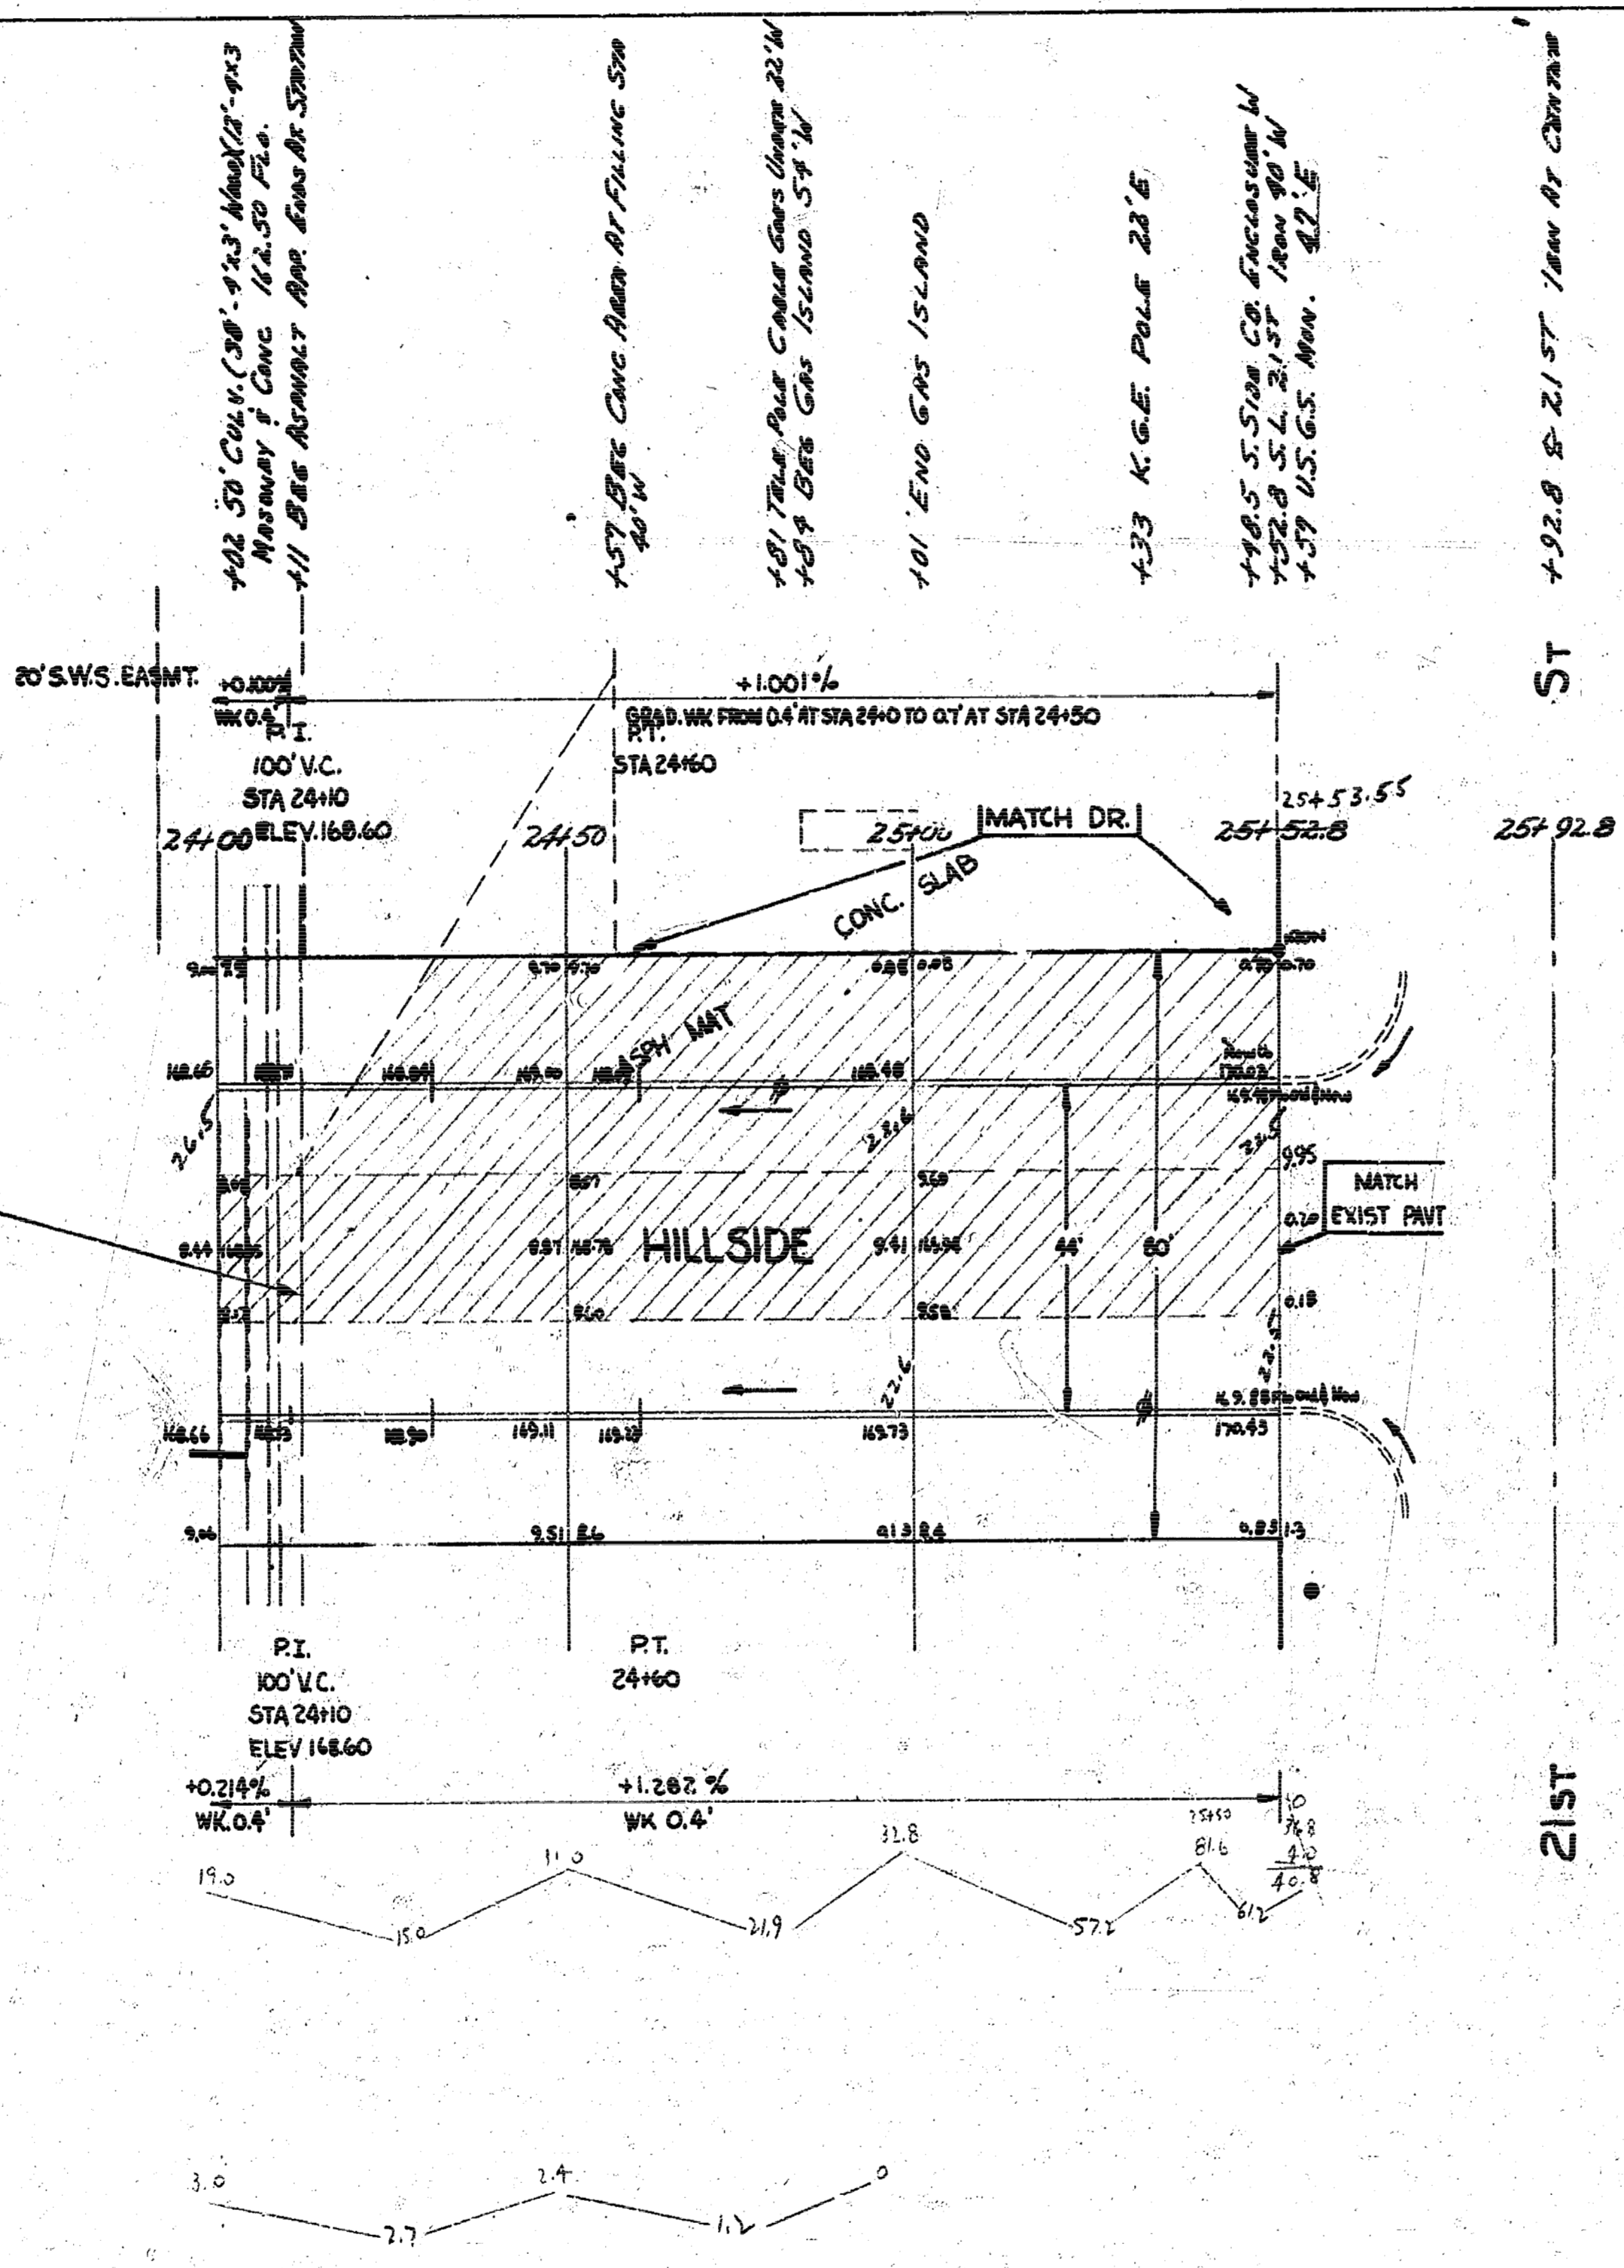

6  
of  
12

HILLSIDE AVE  
 N.L. 17TH TO S.L. 21ST  
 44' CONC & CB. - 8" THICK  
 CITY OF WICHITA, KANSAS  
 S.E. SMITH CITY ENGINEER  
 JULY 1955 PROJ. NO. C19-264