
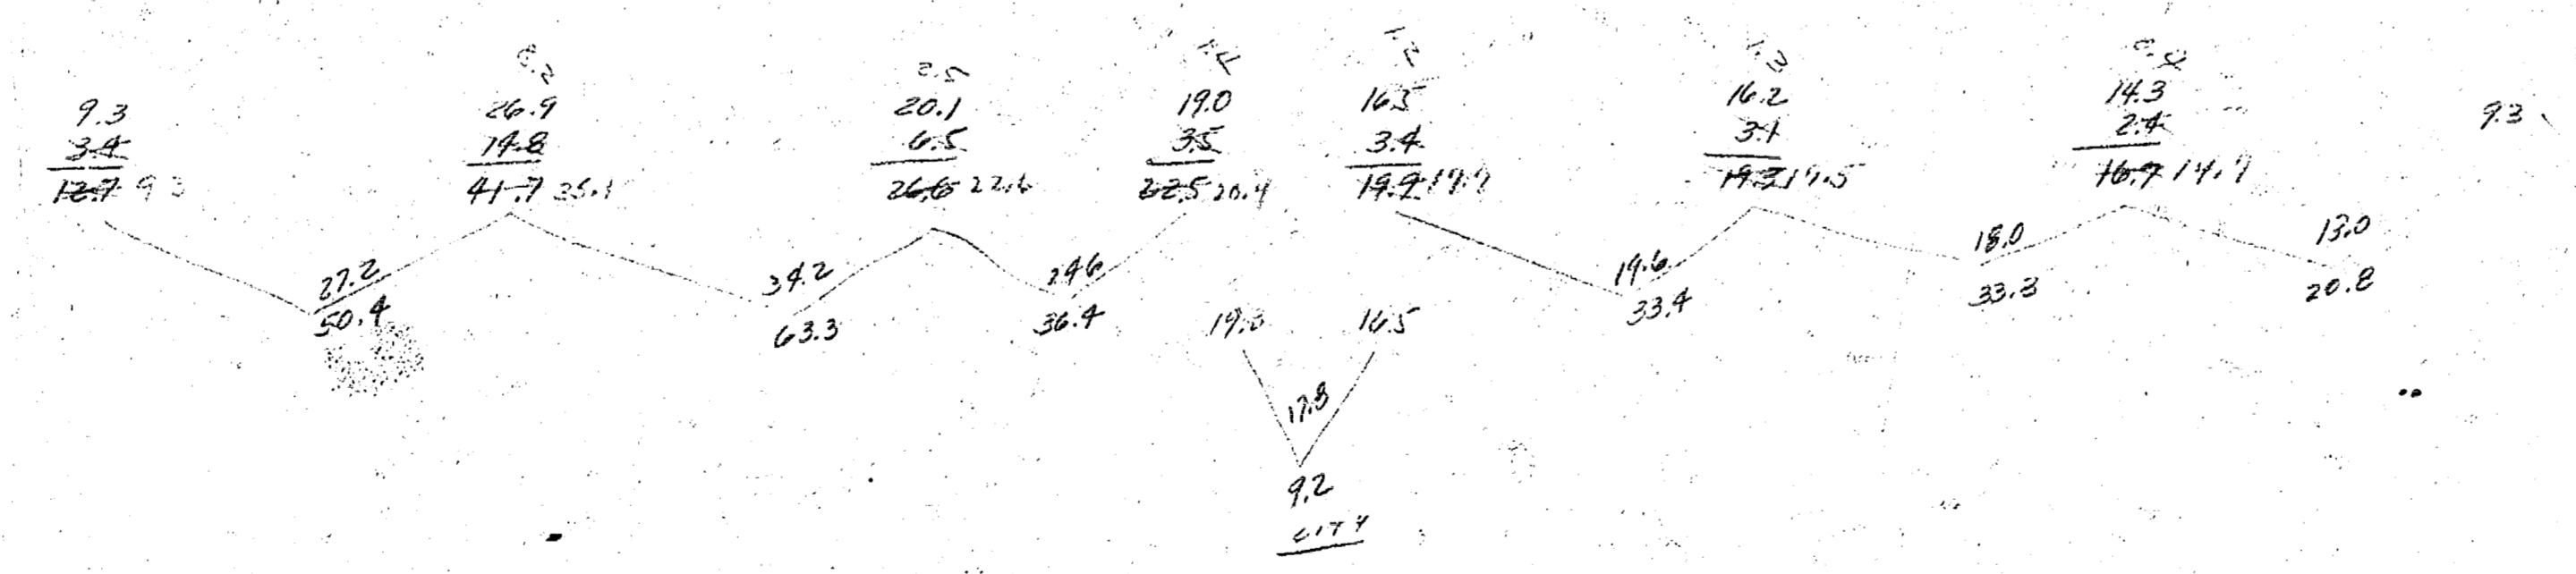


B.M. 98.32 "G" IN GLOBE S. END CO. N.E. COR. MINNEAPOLIS & HODSON  
 CHAINING E. ON & HODSON

E.I.C.	
Prop.	Exc.
237.0	18.6
+16.9	21.2
261.9	20.5

0155 8" WIRE FENCE 37 FT.  
 0160 8" WIRE FENCE 36 FT.  
 0177 7" WIRE FENCE 38 FT.  
 1126 8" WIRE FENCE 30 FT.  
 1129 8" WIRE FENCE 30 FT.  
 1145 8" WIRE FENCE 37 FT.  
 1146 8" WIRE FENCE 30 FT.  
 1153 8" WIRE FENCE 30 FT.

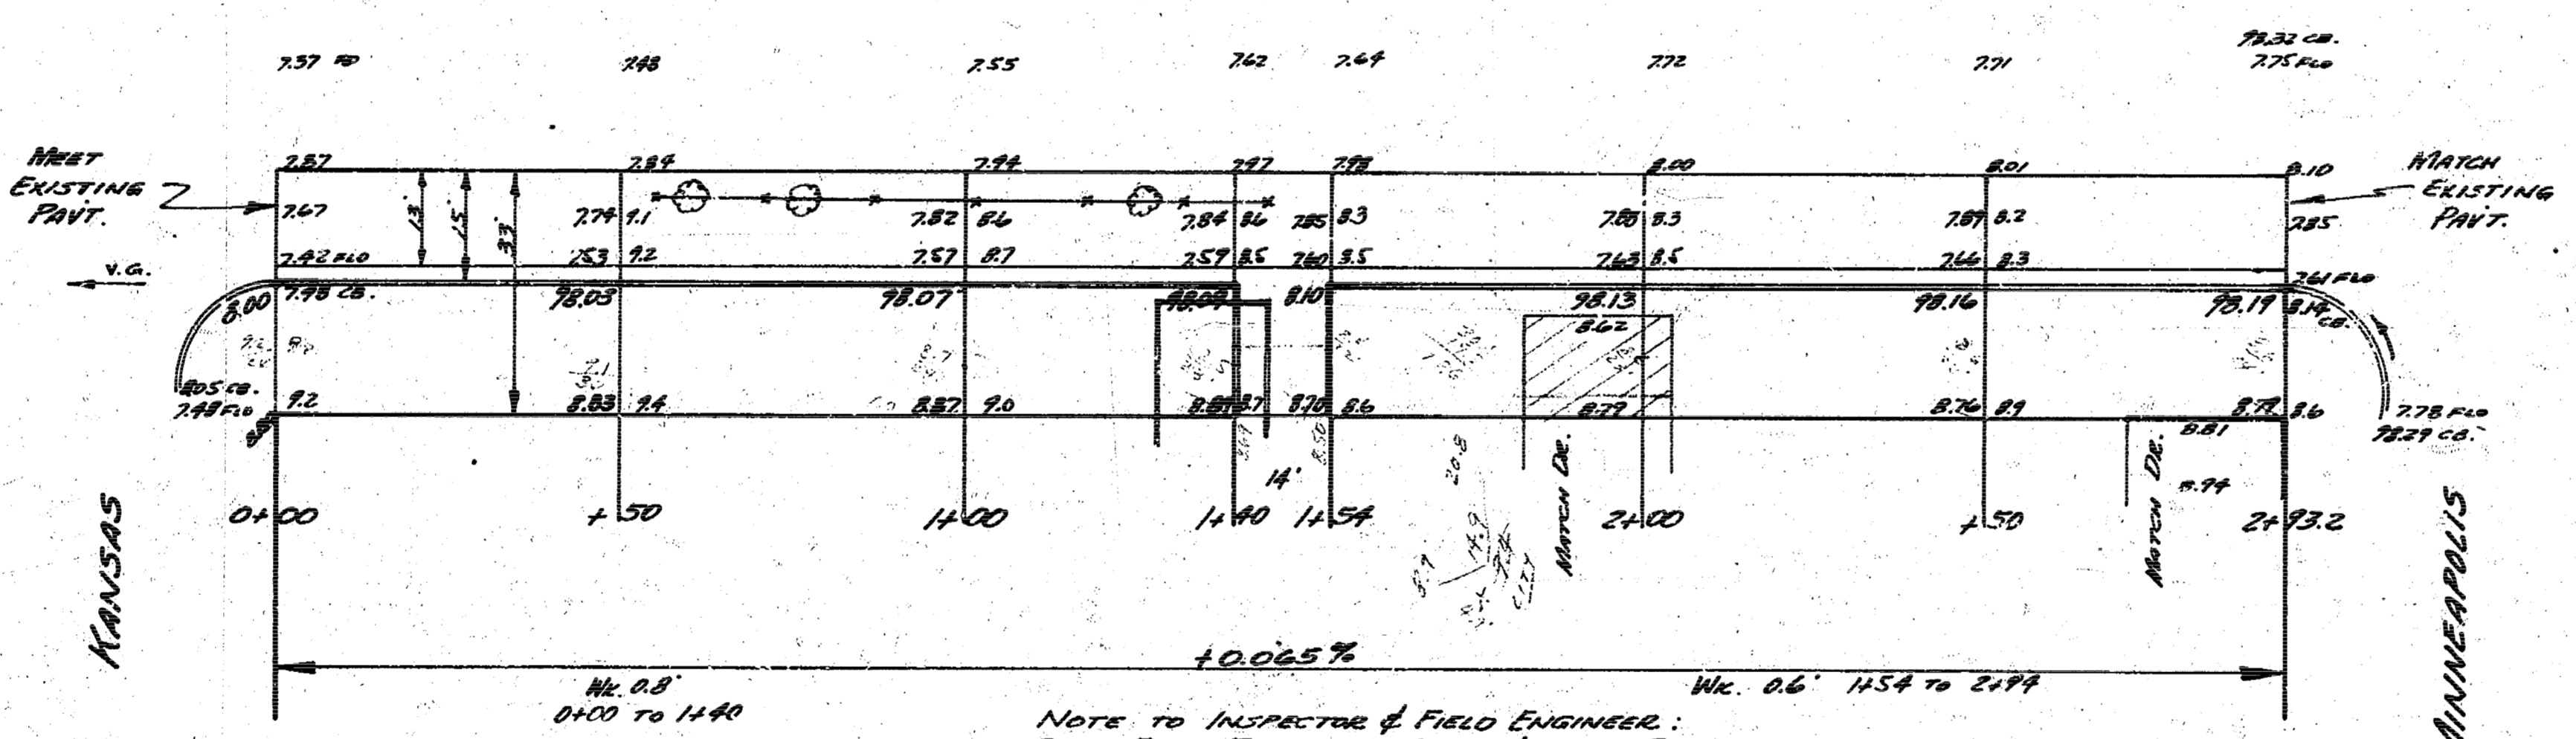

Surveyed by  
 Plans  
 Exc.  
 Checked



S 1/2 HODSON  
 E. L. KANSAS TO W. L. MINNEAPOLIS  
 13-2-15 A.C.  
 CITY OF WICHITA, KANSAS  
 B. E. SMITH, CITY ENGINEER  
 AUGUST, 1933 PROJ. C13-113