5-6

BM 98.32 "G" in Globe S. end cb. N.E. cor. Minneapolis & NL Hodson.

22.8
19.4
19.0
17.0
19.0
19.3
19.1
22.6
158.2
175.9
334.1
34
368.1

SCALE 1"=20'

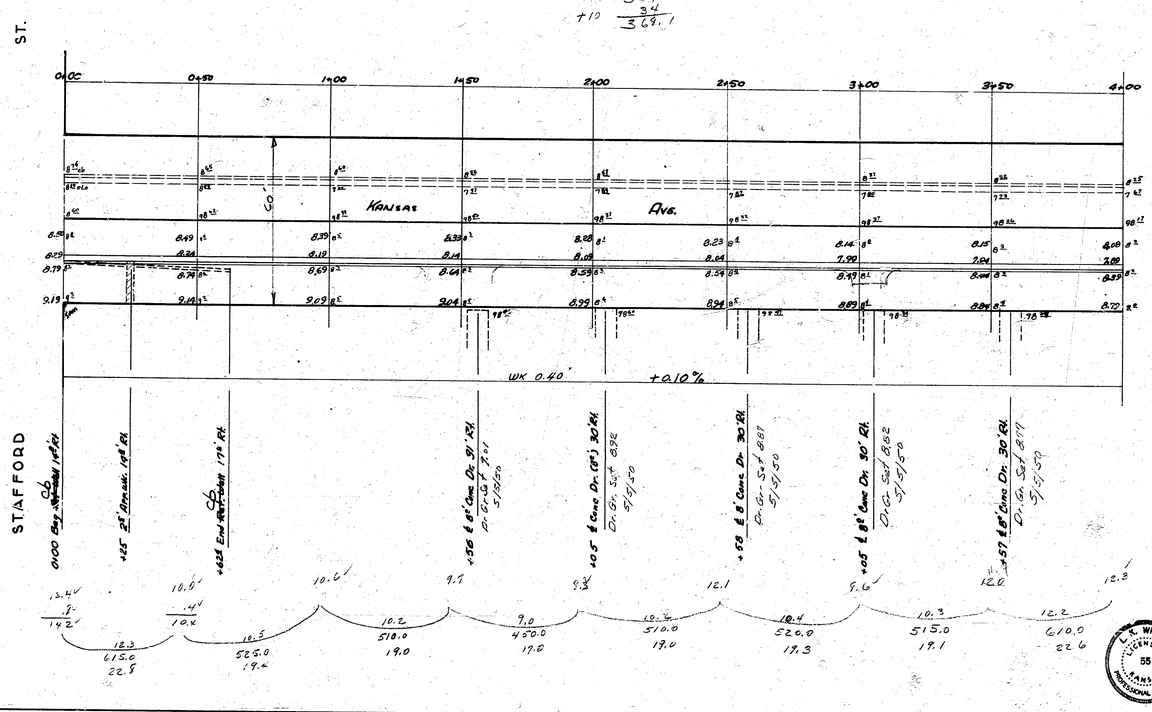

L. K. WHITE LICENSED 55 KANSAS PROFESSIONAL ENGINEER

1/2

KANSAS AVE., E. ½
NL STAFFORD ST. TO SL HODSON ST.
13-2-15 A.C.

CITY OF WICHITA, KANSAS
L.K. WHITE — CITY ENGINEER
OCT., 1951 — PROJ. NO. C 11-171

22.4
20.4
19.4
21.3
23.3
25.7
25.0
15.4
175.9

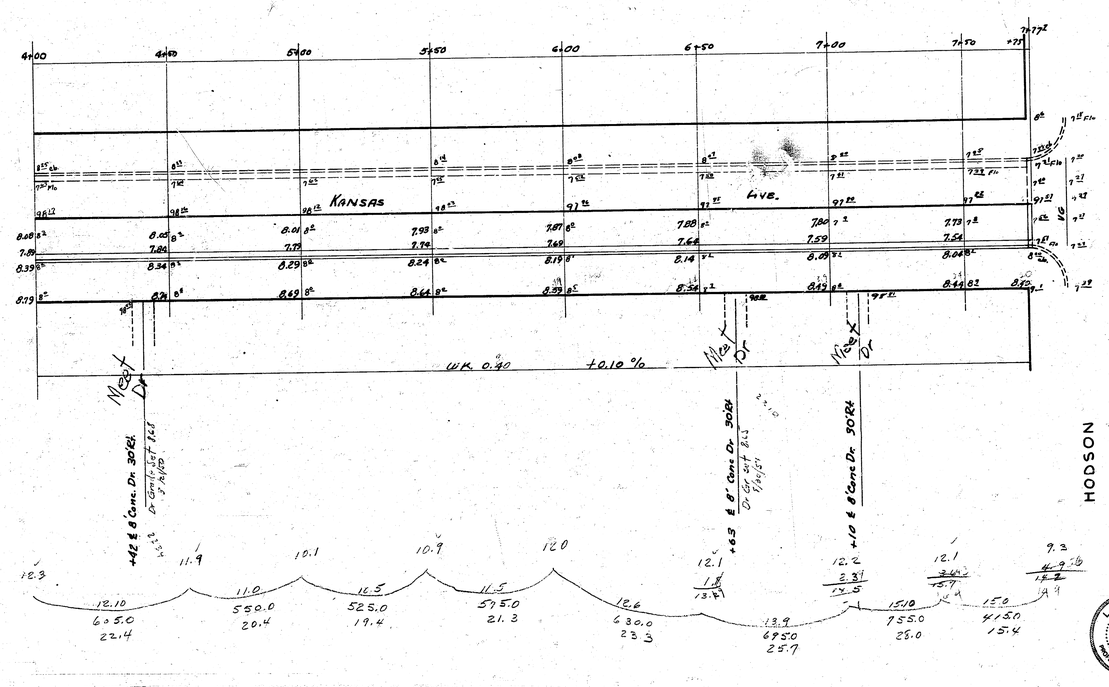

L. K. WHITE
LICENSED
55
KANSAS
PROFESSIONAL ENGINEER

2/2

B.M. 99.16 N.W. Corner conc. porch No. 1731 SS. Stafford 25' W. of Kansas.
B.M. Book 39, p.64, 99.45 N.E. Cor. conc. porch, No. S.W. Kansas & Hodson.

N

-.10%
WK. 0.4

KANSAS AVE.

STAFFORD

Property

	8.9
	10.0
	12.6
	6.9
	6.6
	2.2
	7.8
	13.3
	22.8
	24.0
	106.7
+10%	10.6
total	117.3

W ½ KANSAS AVE.

SL. HODSON to NL. STAFFORD

13-2-15 A.C.

CITY of WICHITA, KANS.

Engineering Division

L.K. WHITE CITY ENGINEER

July 1947

1/2

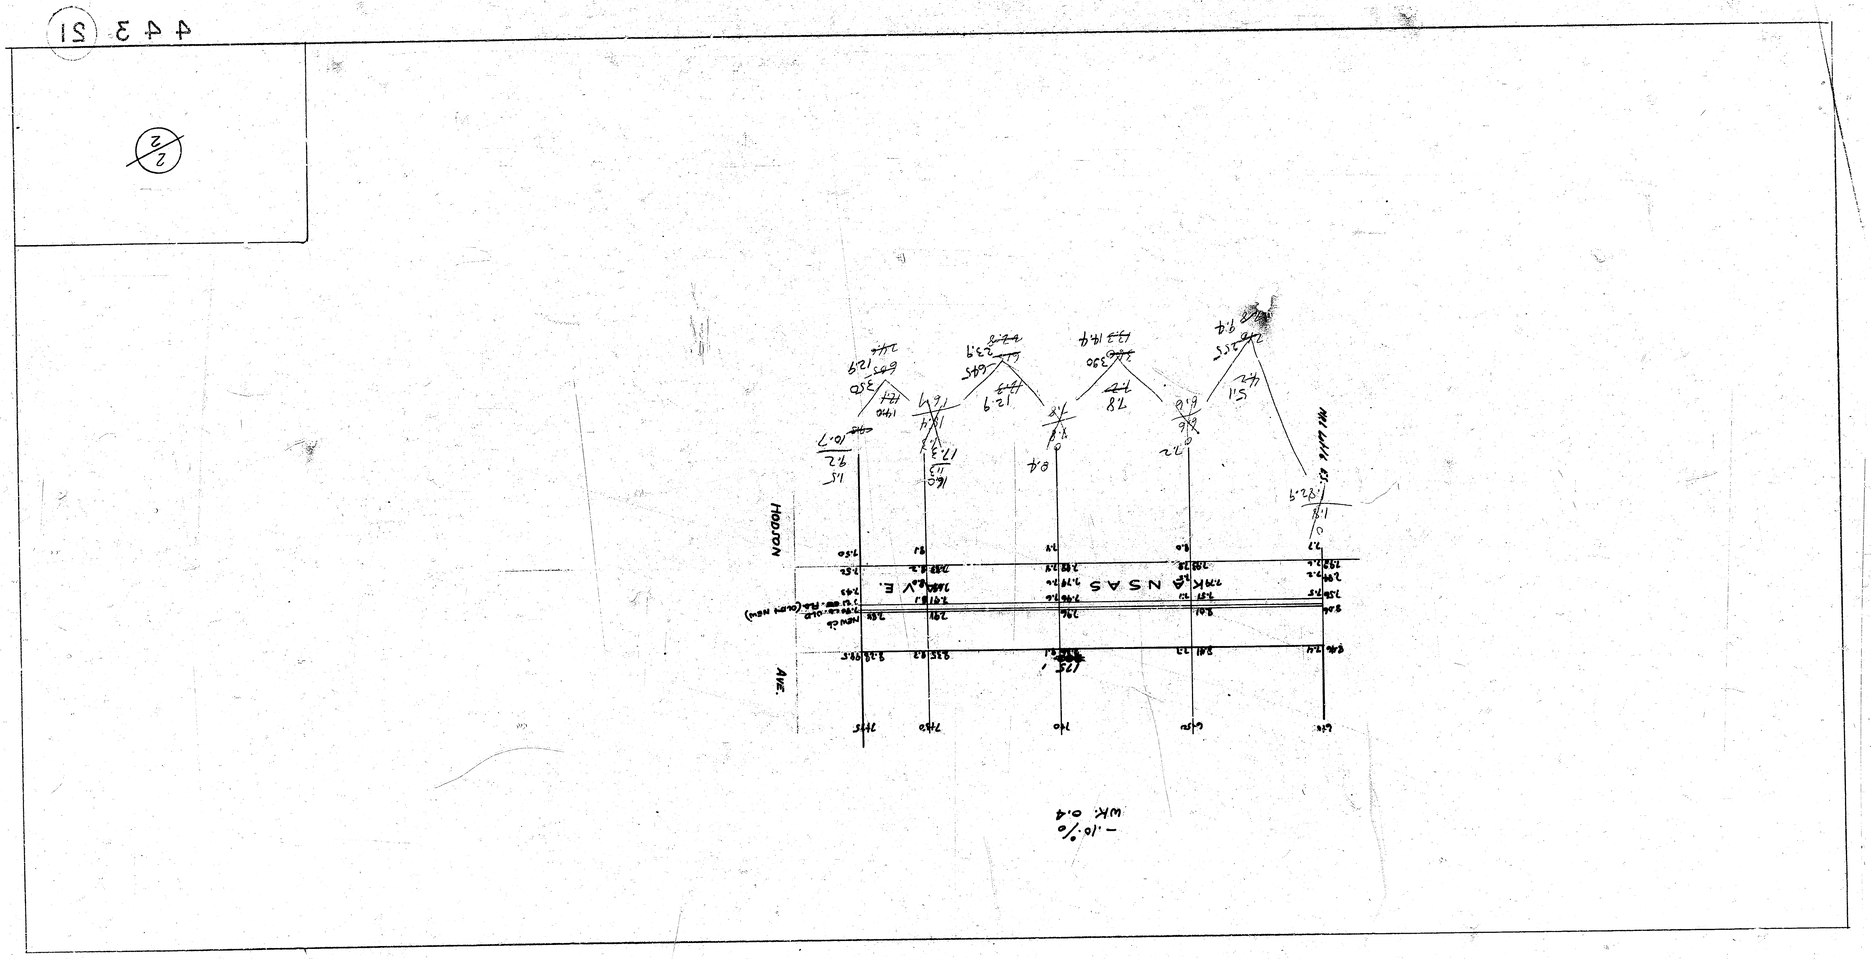
443
51
2
2
HUDSON
KANSAS AVE.
-10%
WK 0.4