B.M. 163.12 "X" on N.W. Cor. of N. Headwall on Crossroad Culvert 175'E of E. Winona Rd. K.S. Kellogg

COURTLEIGH DRIVE

WINDSOR ROAD

KELLOGG DRIVE

24" R.C.P.

SCALE 1"=20'

-0.23%

-0.20%

-0.20%

KELLOGG DRIVE
E.L. Courtleigh Drive to W.L. Windsor Road
21-2-25 A.C.
CITY OF WICHITA, KANSAS
L.K. WHITE CITY ENGINEER
SEPT. 1951 PROJ. NO. C 11-105

L. K. WHITE LICENSED 55 KANSAS PROFESSIONAL ENGINEER

SURVEY IN S.S. T-1 12-26-51
BEND IN D.D. " 2-19-52
GRADE BY EC. & U.A.

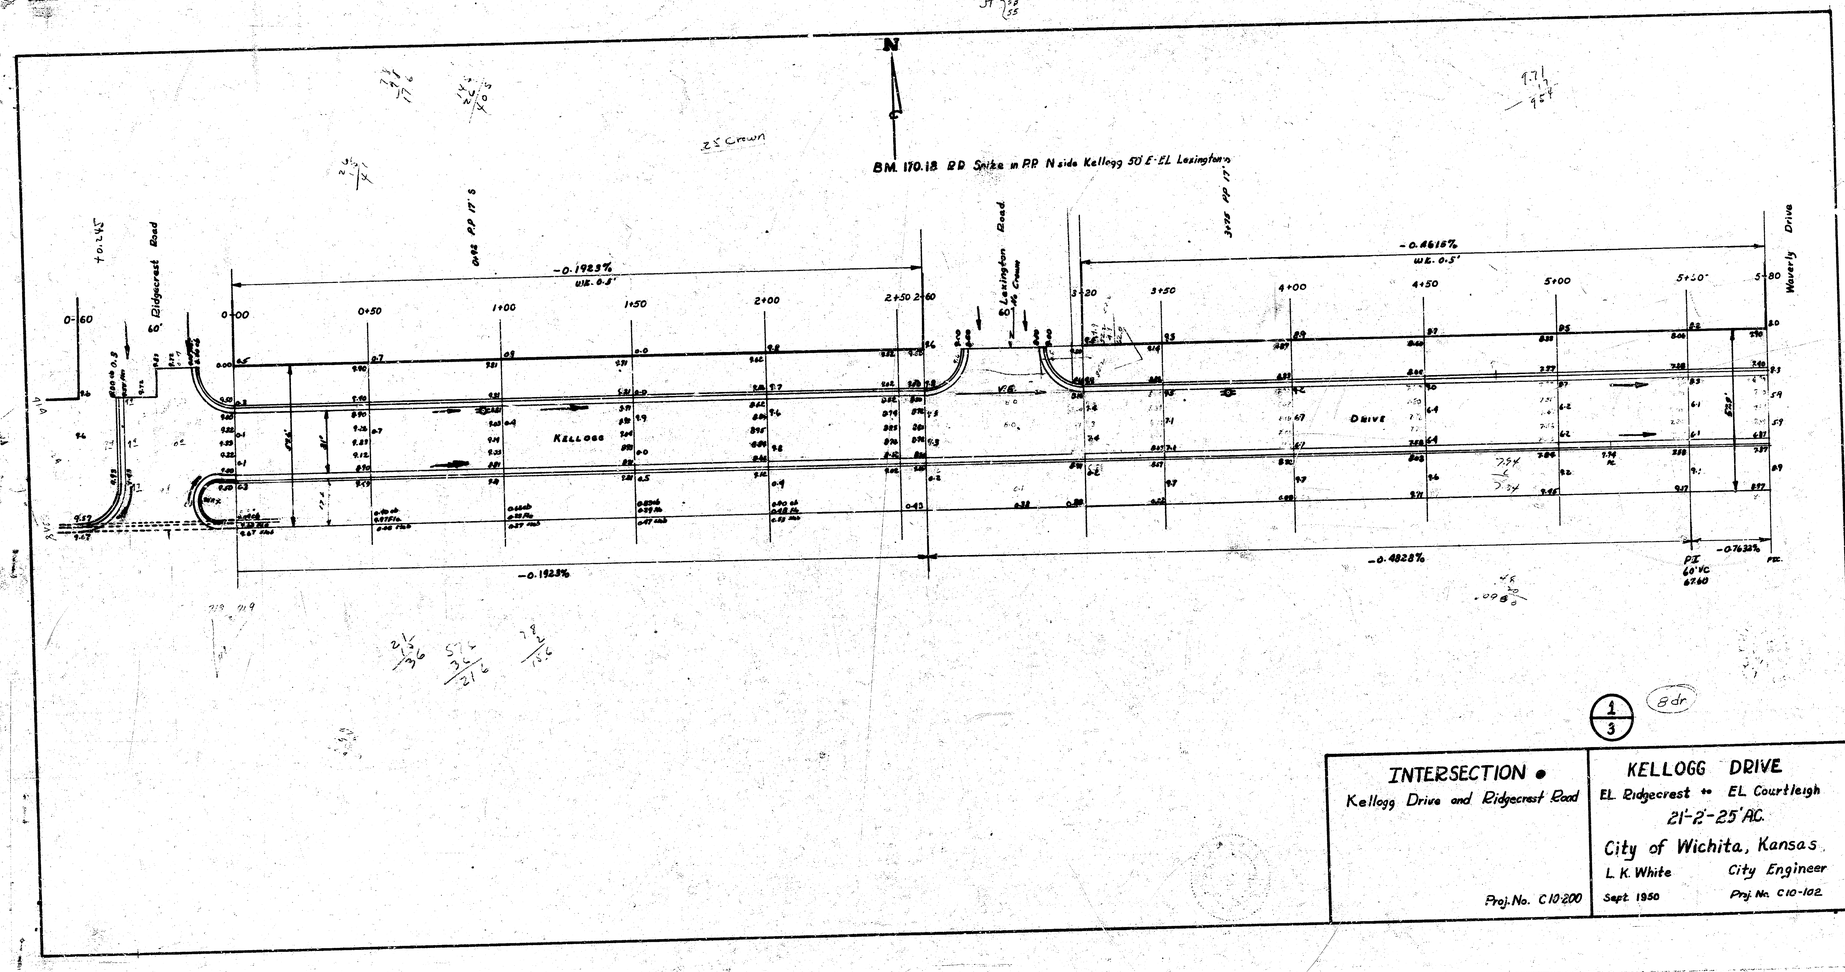

INTERSECTION ● Kellogg Drive and Ridgecrest Road Proj. No. C10-200	**KELLOGG DRIVE** EL Ridgecrest ++ EL Courtleigh 21'-2'-25' AC. City of Wichita, Kansas L. K. White — City Engineer Sept. 1950 — Proj. No. C10-102

1/3

8dr

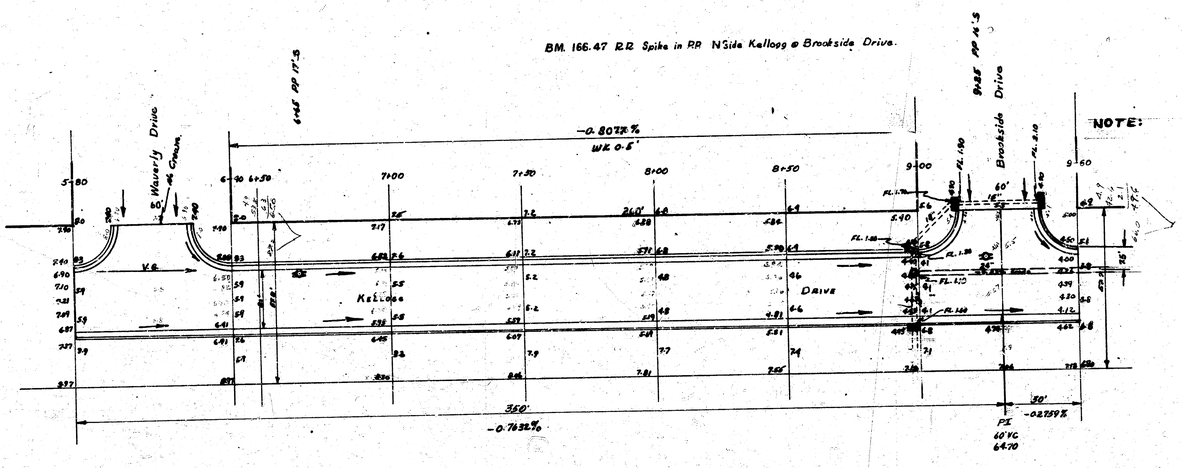

2/3

KELLOGG DRIVE

BM. 165.83 R.R. Spike in P.P. N side Kellogg 20' W. of Courtleigh

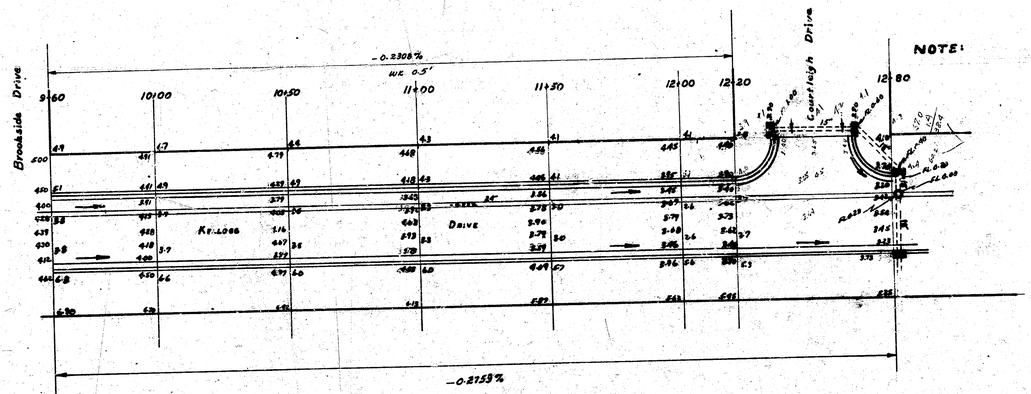

3/3

KELLOGG DRIVE

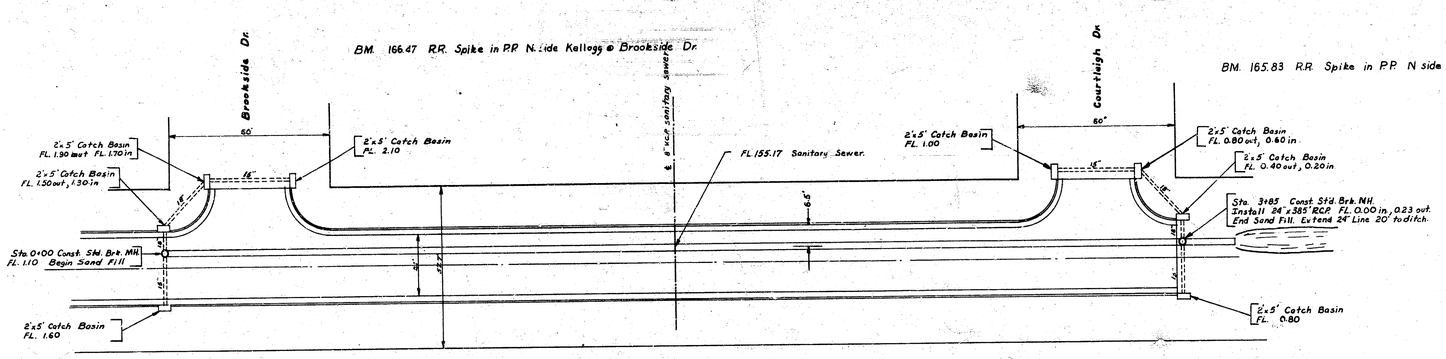

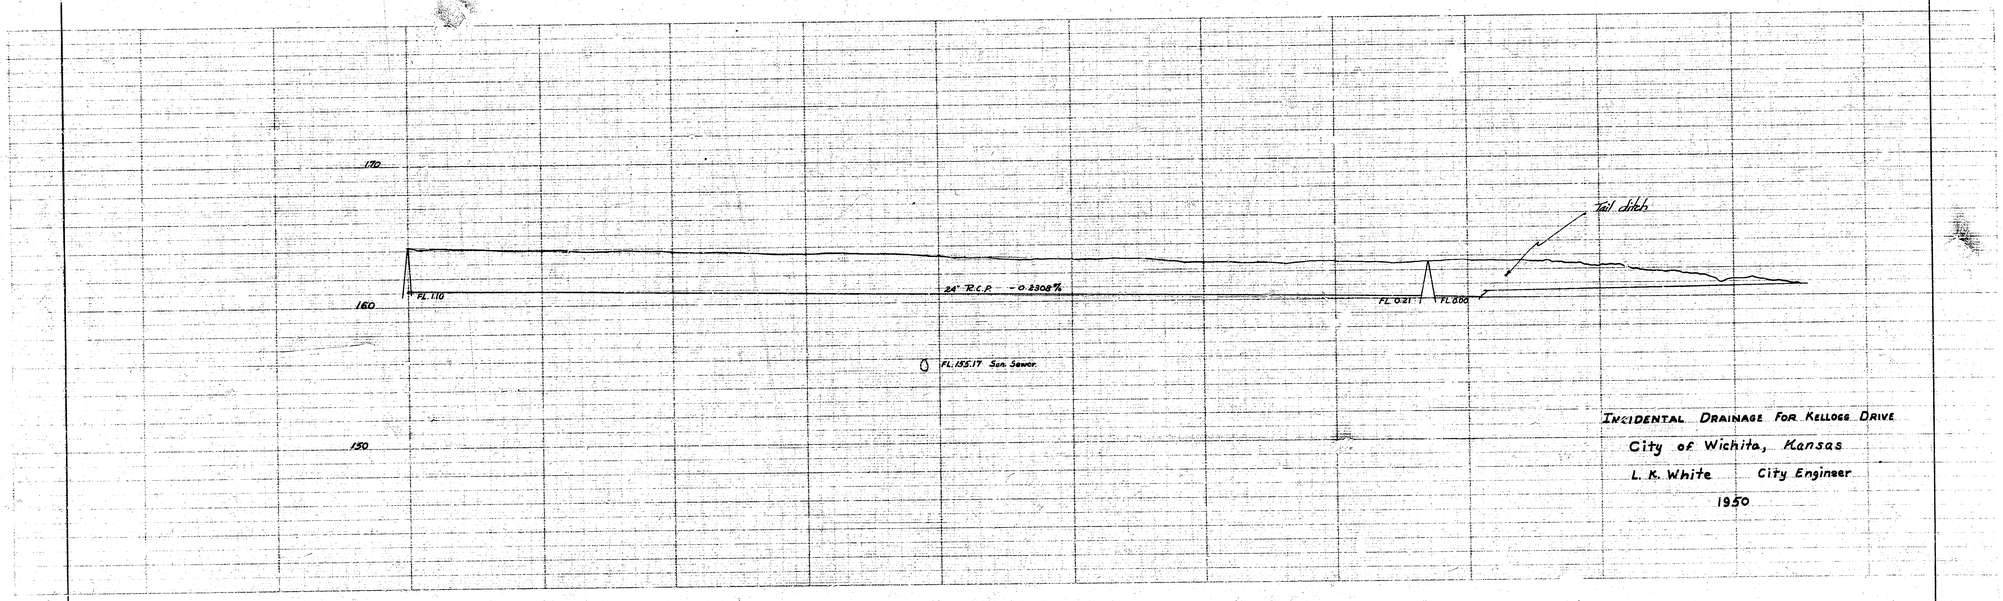

INCIDENTAL DRAINAGE FOR KELLOGG DRIVE

City of Wichita, Kansas

L. K. White City Engineer

1950

E 3 12