Jefferson N.L. 11th S.L. 12th

26' concr.

N.D. Iron 476.0' N. of 11th

X on Walk at 11th

B.M. Elev. 1218. Iron in Thim. W.S. Wiley & C Franklin.
" " 116.80 "B." in Berdner C WE SE 10th Jefferson.
" " 117.25 "N" in Moore C wk. N.NE 11th "
" " 120.01 "R" in Rep-agle C wk S.SW.12 "

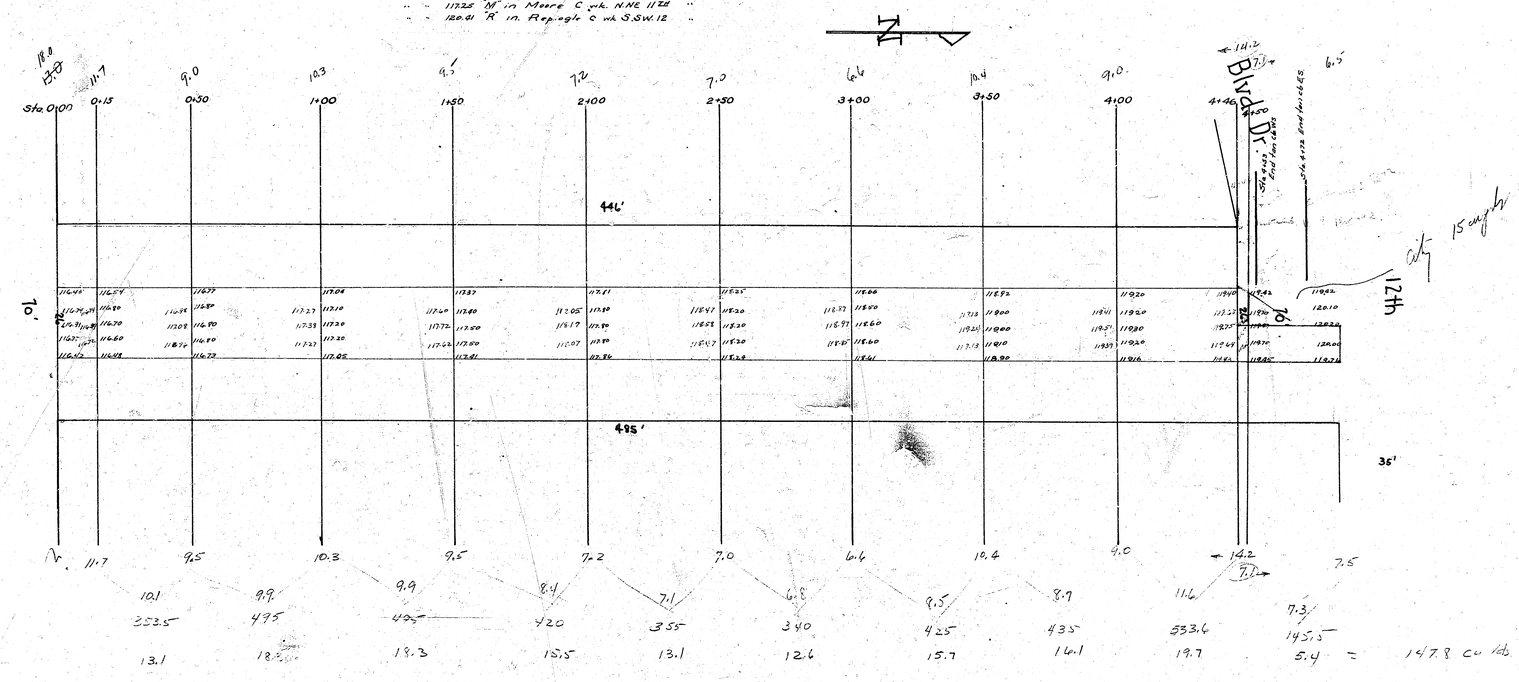

Paving Plan
1946
Jefferson
N.L. 11th
S.L. 12th