


BM. 120.92 E in E. D. B. N. Co. 1/4 E. L. Garland
 BM. 125.75 5th Bench Nail in Power Pole S.E. Cor. 17th & Porter

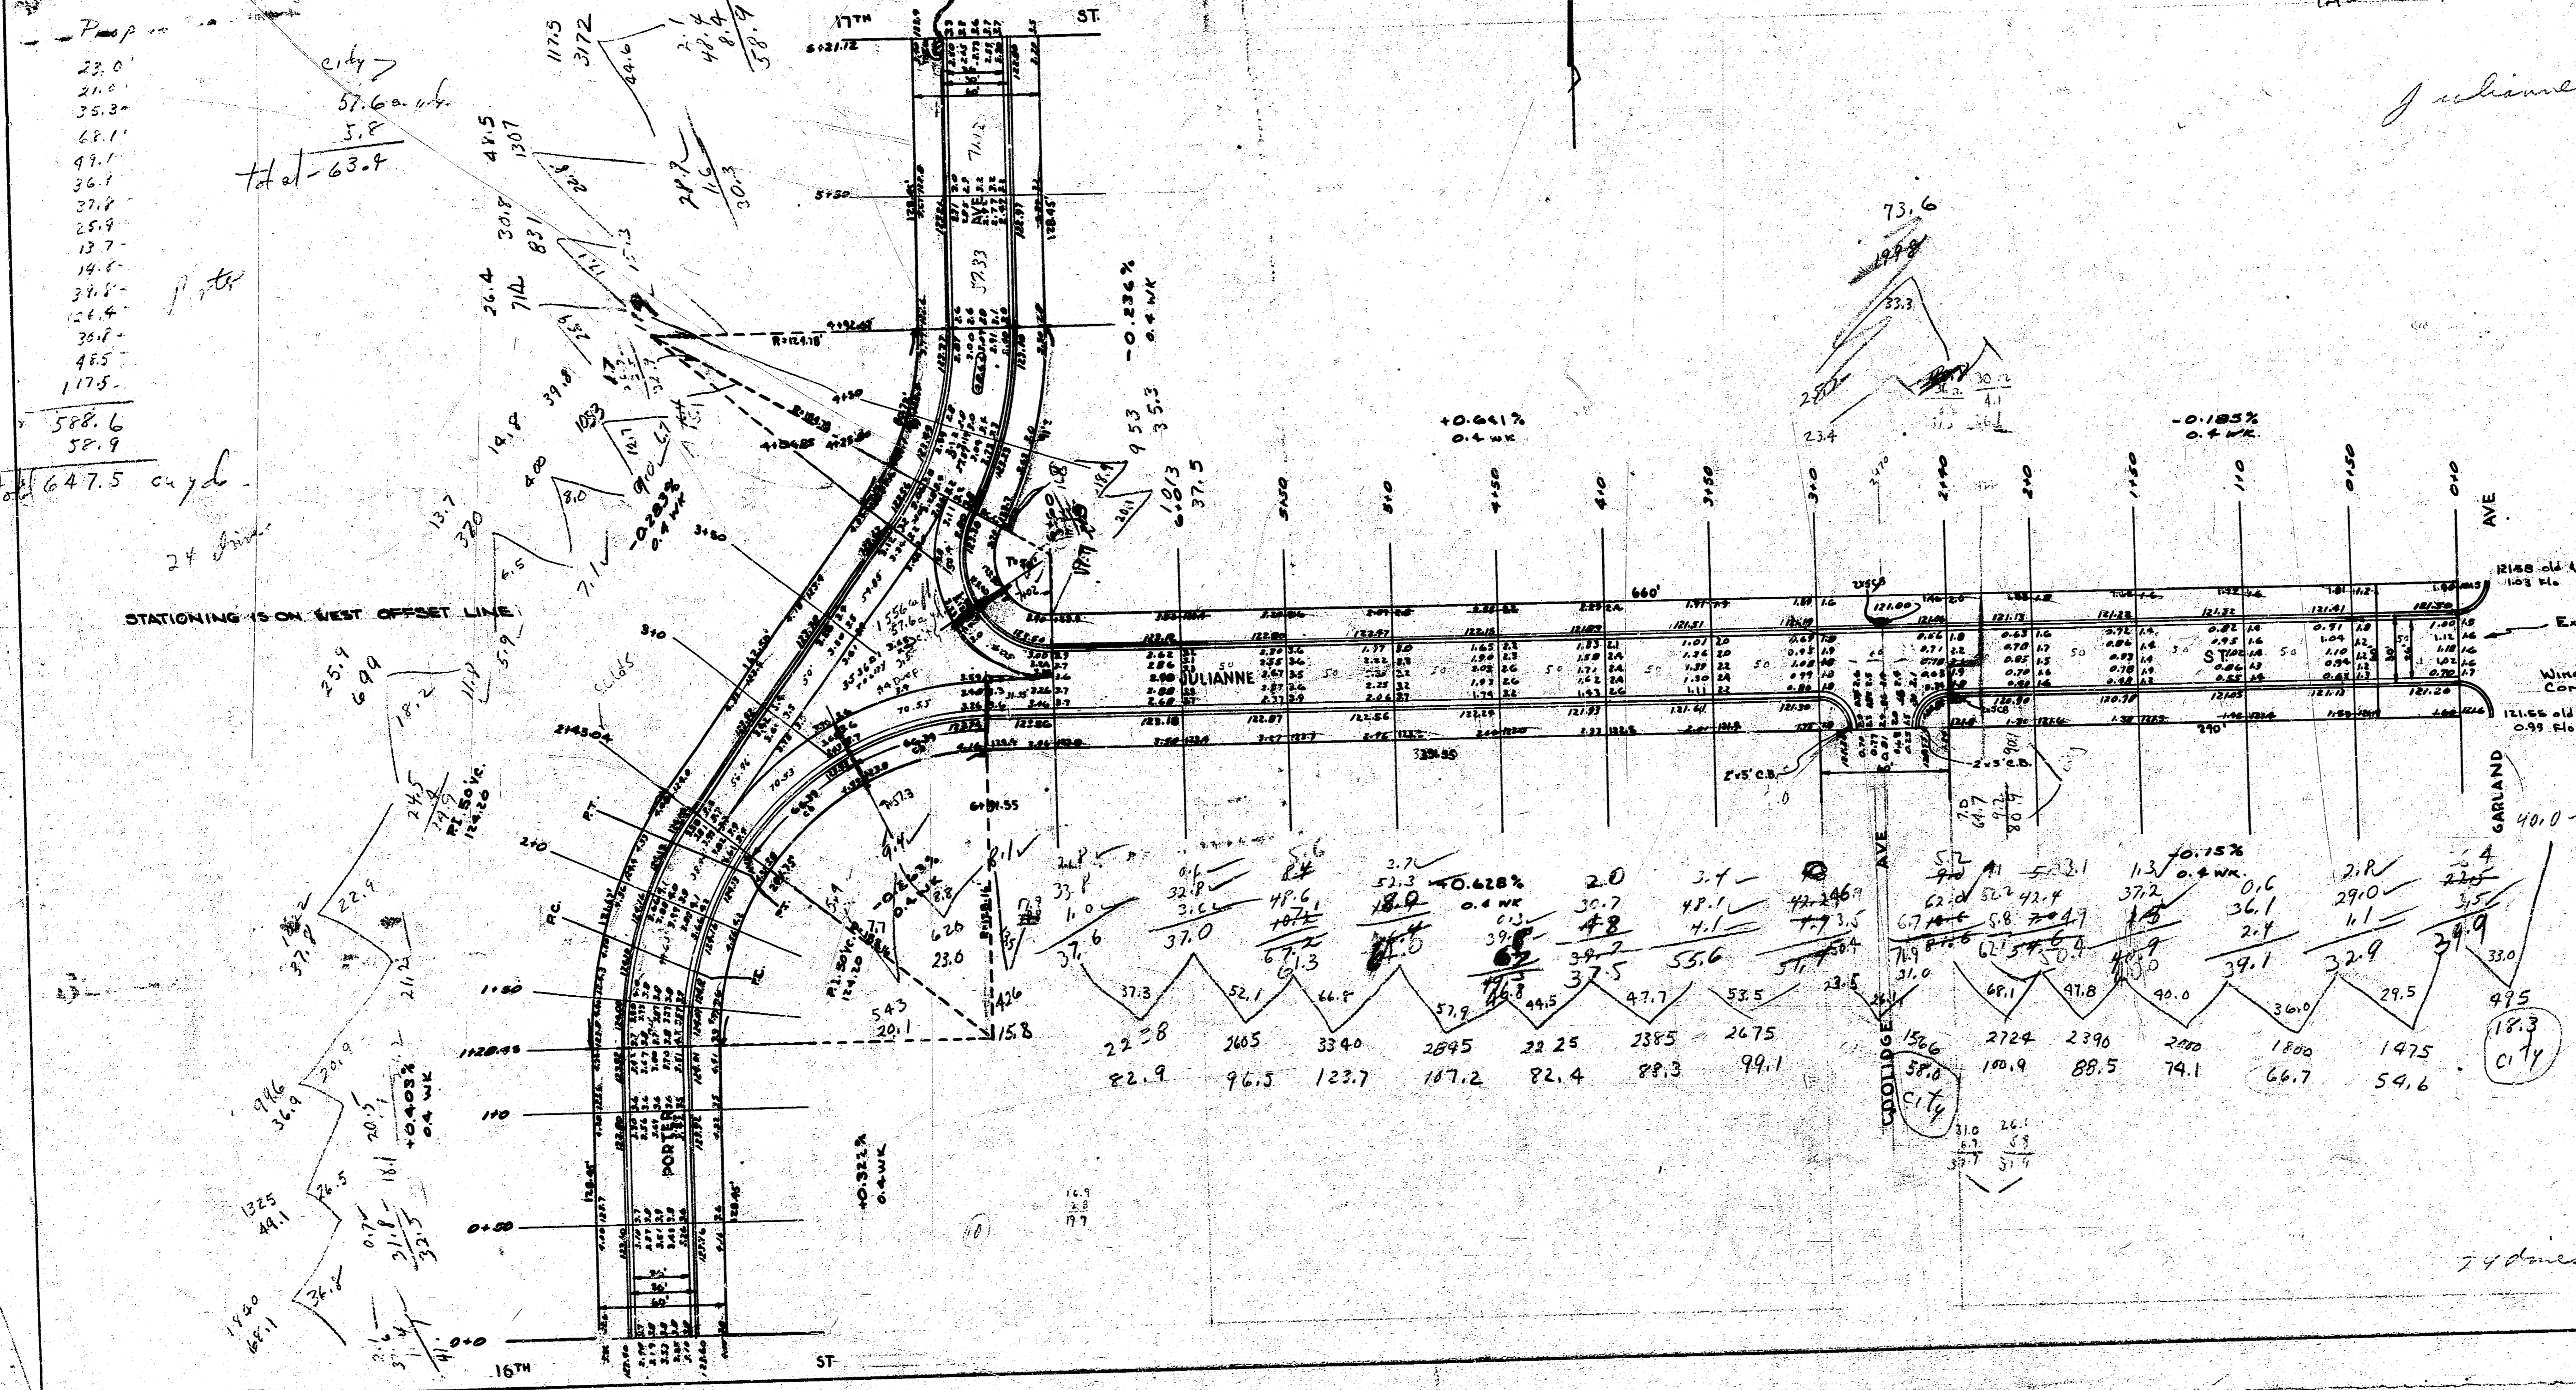

City
 58.6
 15.3
 133.9 on 7/4
 13.4
 Total 147.3

Prep.
 54.6
 66.7
 74.1
 86.5
 100.9
JULIANNE ST PORTER AVE
 26-2-30 ASPH. CONC.
 CITY of WICHITA, KANSAS
 L.K. WHITE CITY ENGINEER
 MARCH 1947